

Wood Guard Rail Required
 Right
 Sta 168+91 to 169+15 Length 24ft.
 LEFT
 Sta 168+91 to 169+15 Length 24ft.
 TOTAL THIS SHEET 48ft.

Cable Guard Rail Required
 Right
 Sta 153+44 to 160+45 201 Ft



Total This Sheet 201ft.

New Culverts Required
 Sta 169+03 15" Rein. Concrete on Cast Iron Pipe Length 32ft.
 Class B (1-2 1/2-5) Concrete 47cy.
 Reinforcing Steel 332lb.
 Sta 170+15 15" Rein. Concrete Pipe Length 56ft.
 Class A (1-2-4) Concrete 27cy.
 Reinforcing Steel 60lb.

FED. ROAD DIST. NO.	STATE	FISCAL YEAR	SHEET NO.	TOTAL SHEETS
8	VT	1927	14	103

PLAN
 SCALE
 1" = 40'

PROFILE
 SCALE
 1" = 10'

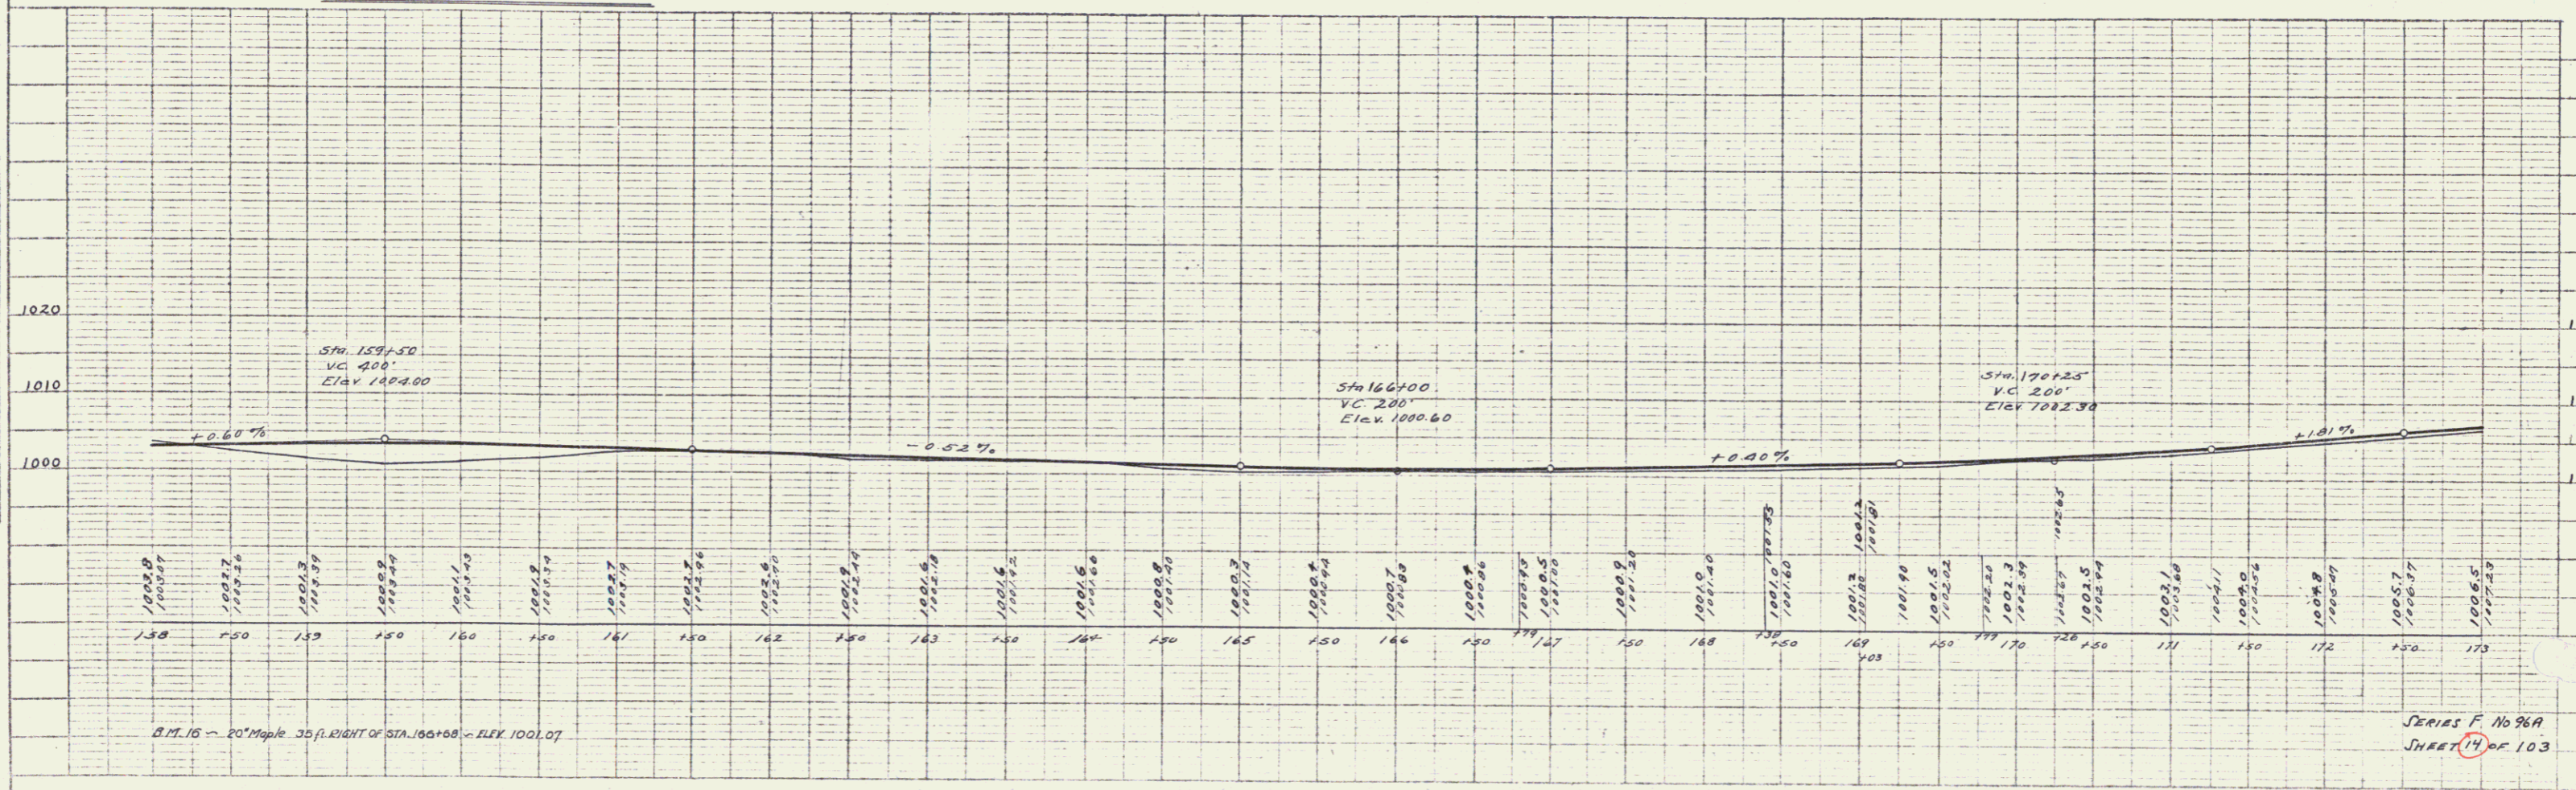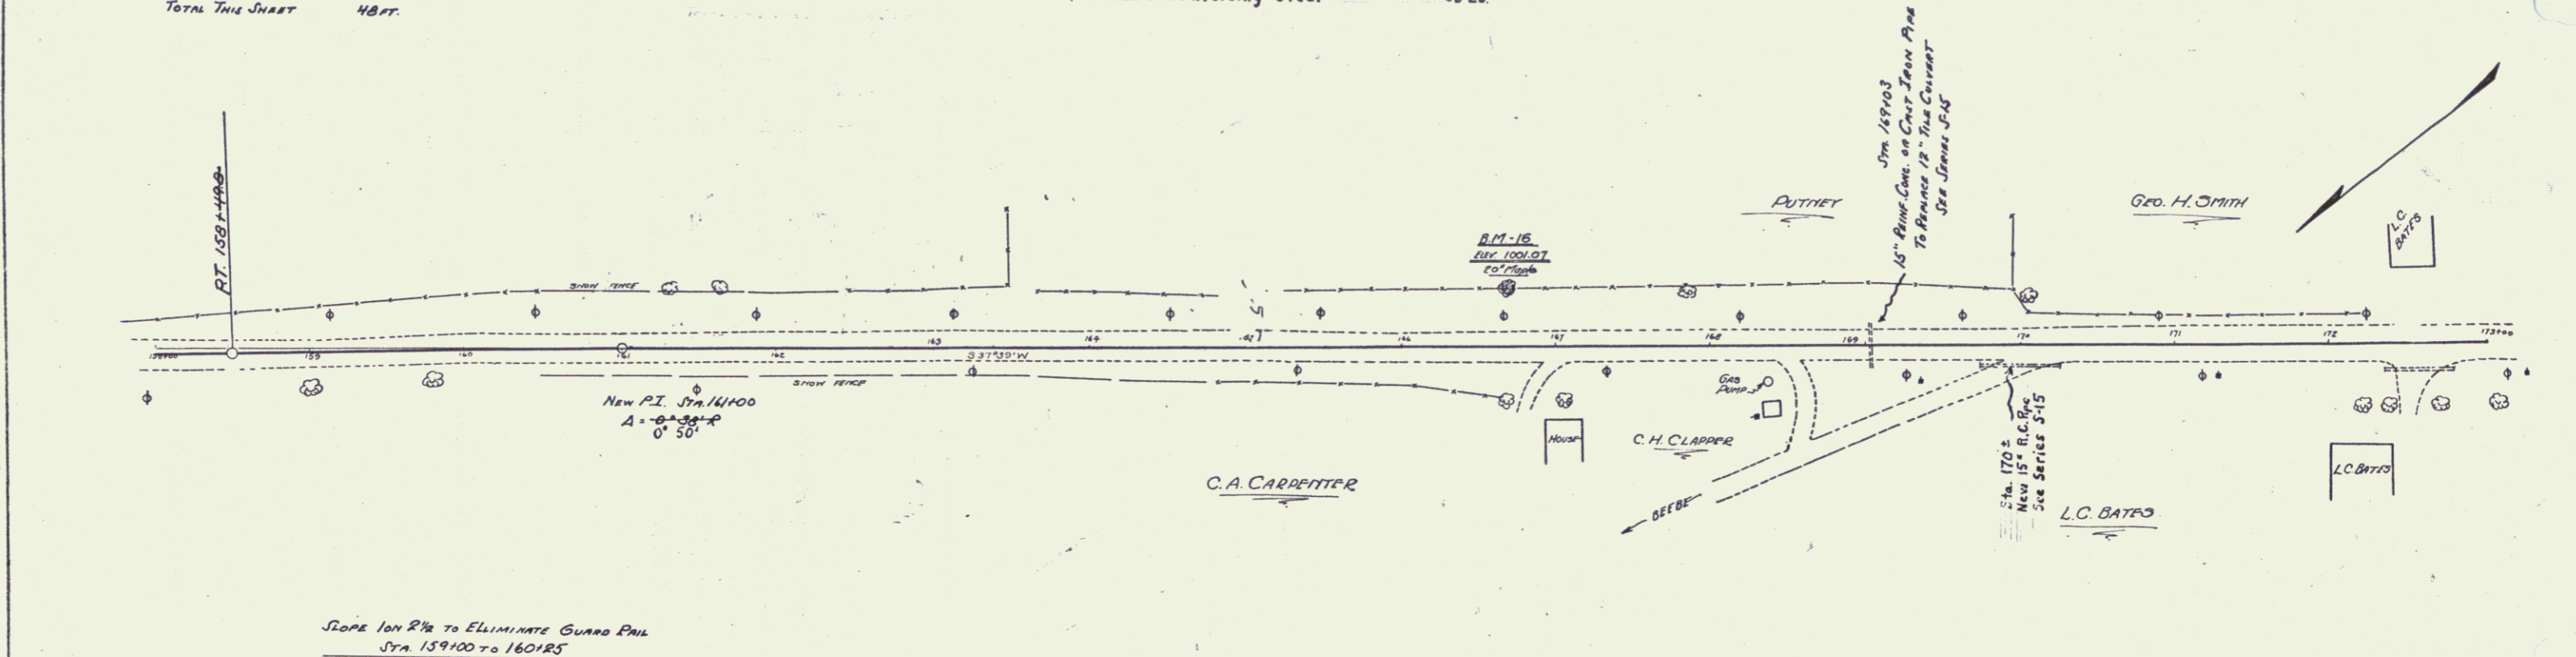

B.M. 16 - 20' High 35' Right of Sta. 160+00 - Elev 1001.07

SERIES F No 96A
 SHEET 14 OF 103

14