

Wood Guard Rail Required
 Right
 Sta 179+00 to 180+12 Length 24ft.
 Left
 Sta 179+00 to 180+12 Length 24ft.
 Total Two Sides 48ft.

New Culverts Required
 Sta 180+00 - 15" Rein. Concrete on Cast Iron Pipe Length 32ft.
 Class B (1-2 1/2") Concrete 2.16x
 Reinforcing Steel 33#.

Driveway Culverts
 Sta. 181+50 R New 12" C.M.P. Length 20'
 Class B (1-2 1/2") Concrete 0.3 cy.



FED. ROAD DIST. NO.	STATE	FED. AID PROJ. NO.	FISCAL YEAR	SHEET NO.	TOTAL SHEETS
9	VI.	9A75	1927	15	103

PLAN

DATE	BY	CHECKED

PROFILE

DATE	BY	CHECKED

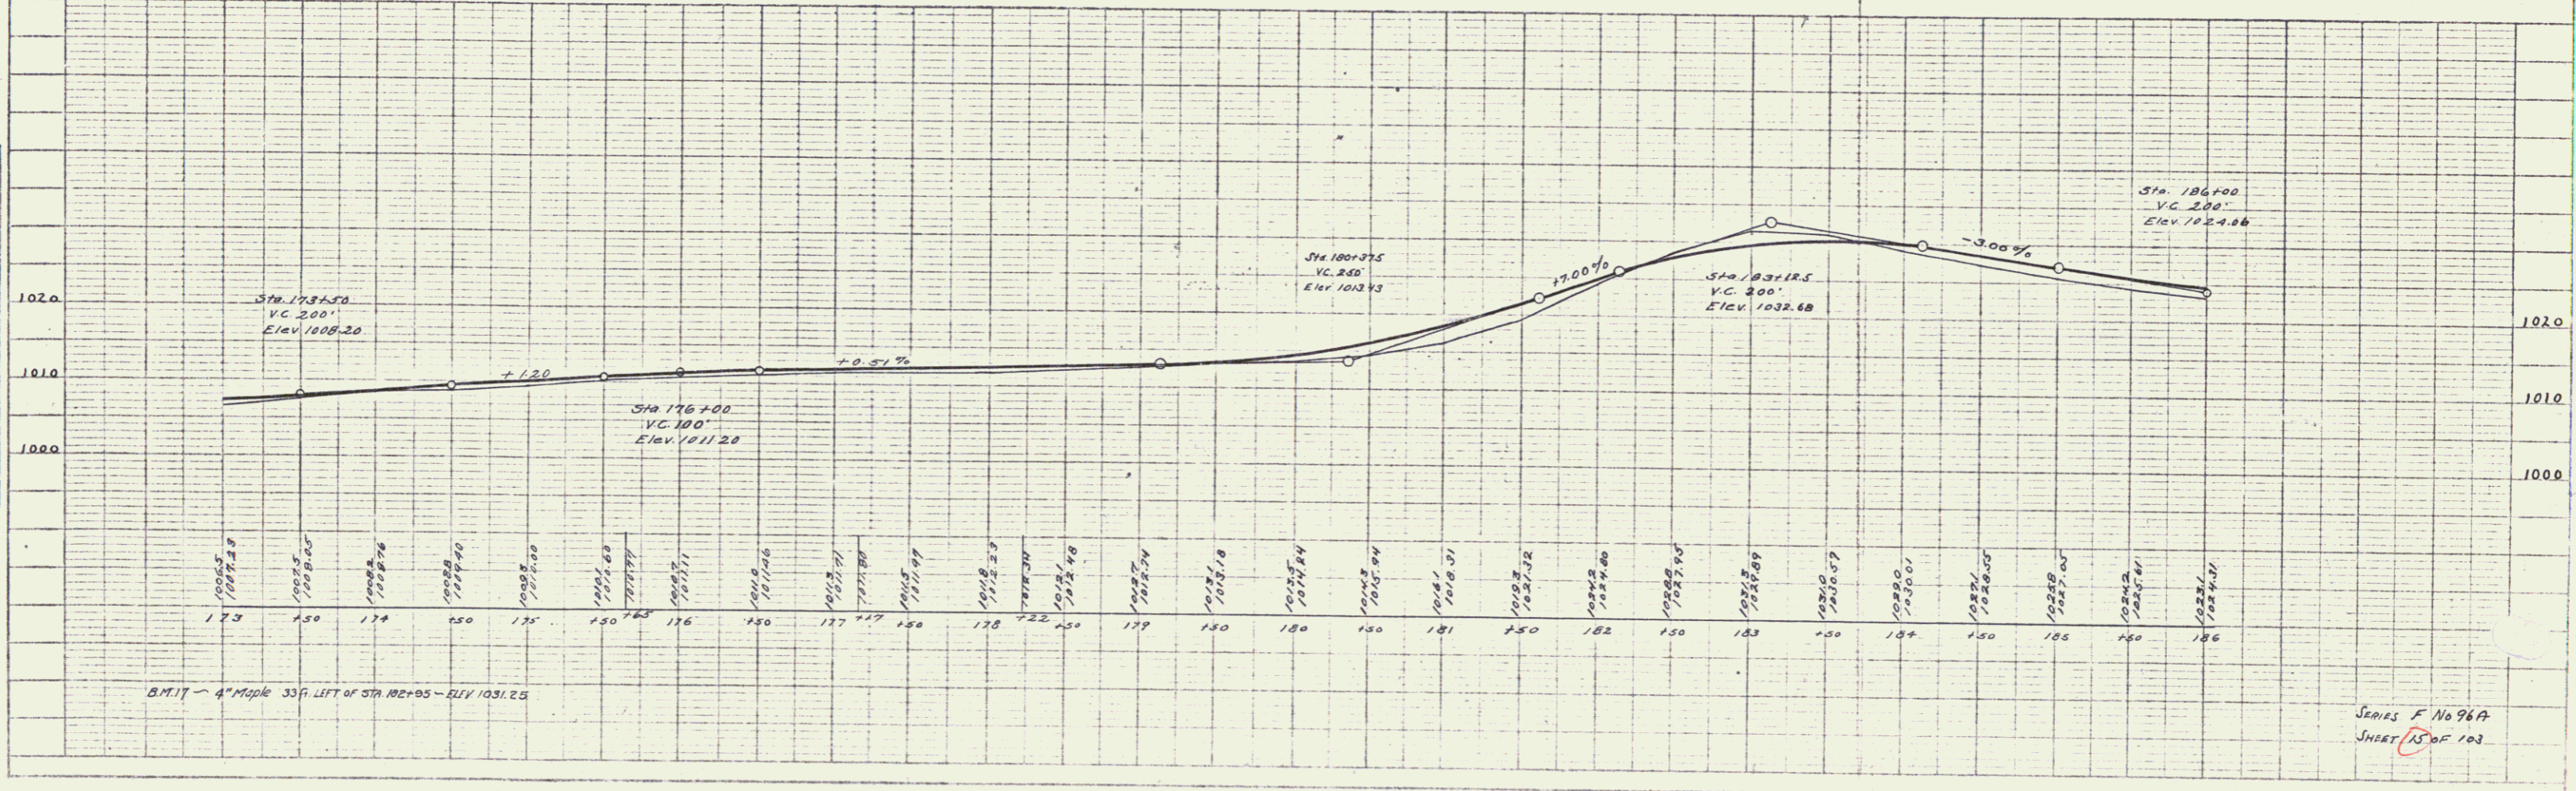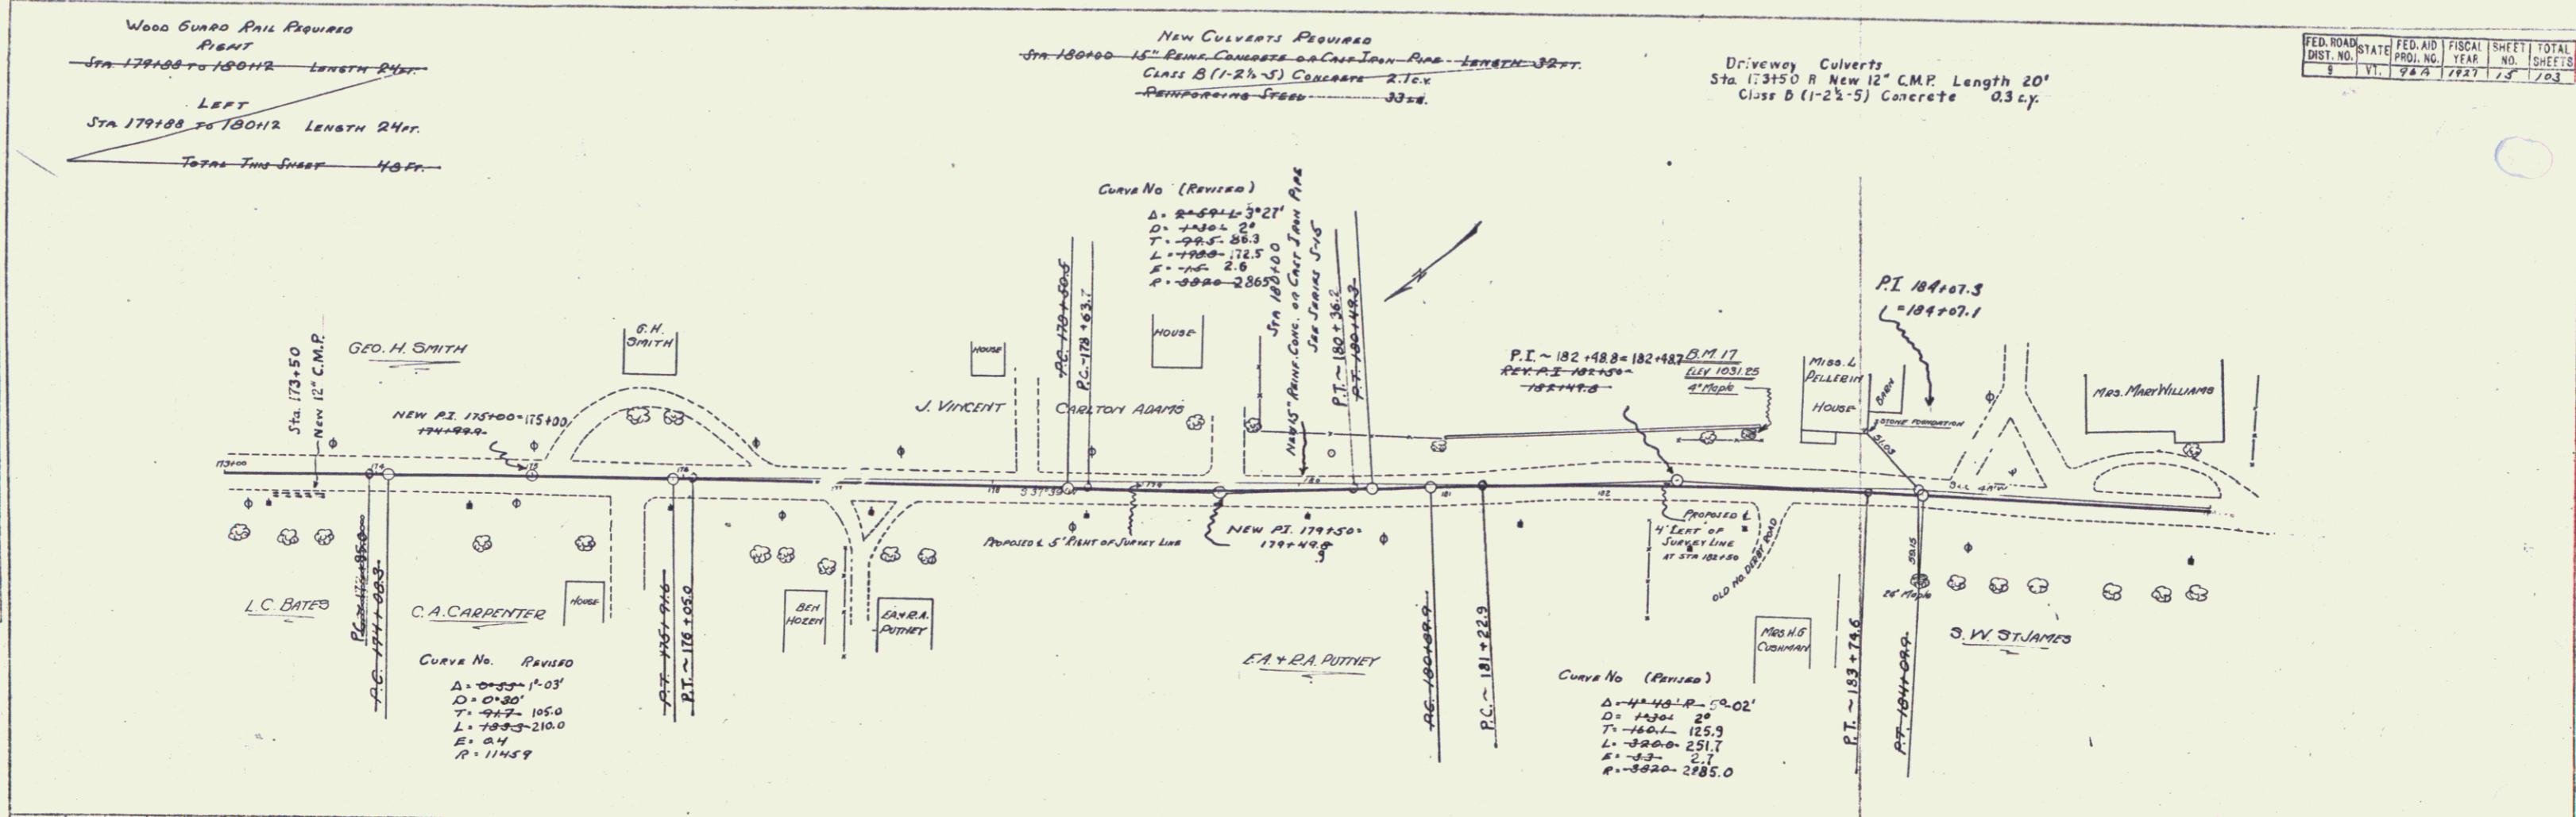

B.M. 17 - 4" Maple 33' LEFT OF STA 182+05 - Elev. 1031.25

SERIES F No 96A
 SHEET 15 OF 103