


FED. ROAD DIST. NO.	STATE	FED. AID PROJ. NO.	FISCAL YEAR	SHEET NO.	TOTAL SHEETS
1	Vt.	96A	1977	7	703

PLAN	DATE	BY	CHECKED
10/1/77	10/1/77	J.M.	J.M.

PROFILE	DATE	BY	CHECKED
10/1/77	10/1/77	J.M.	J.M.

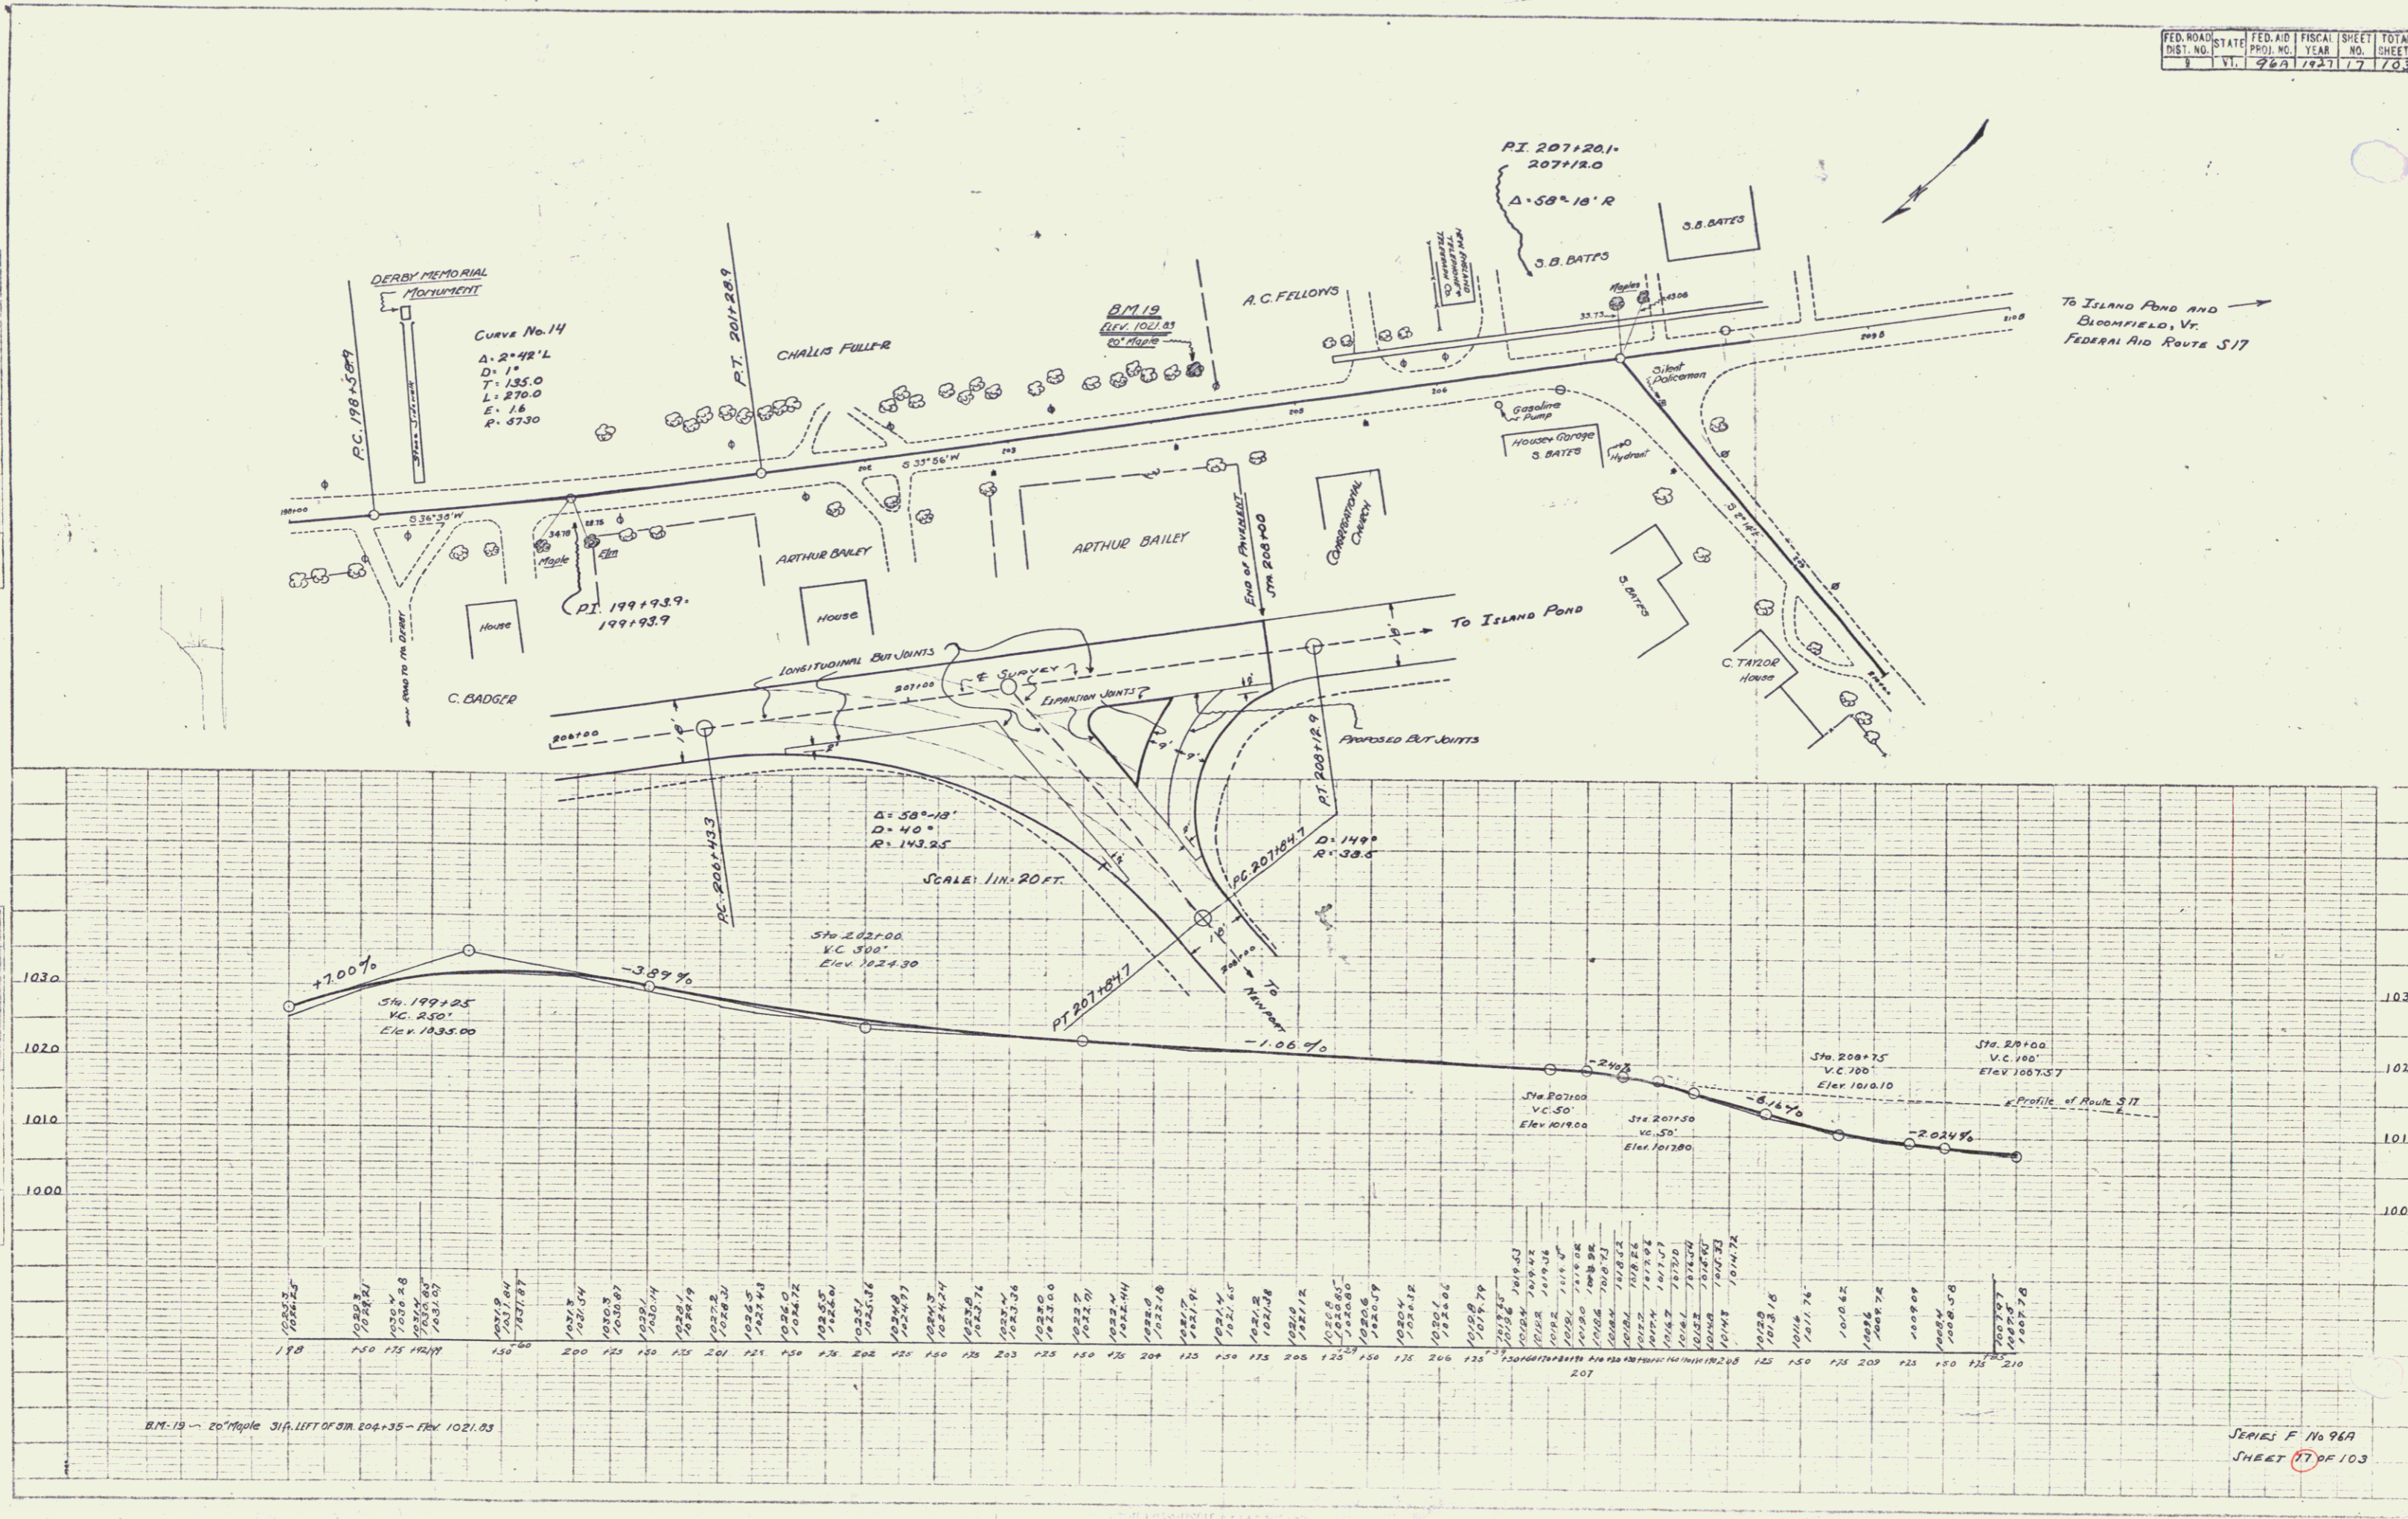

B.M. 19 - 20' Maple 31 ft. left of Sta. 204+35 - Elev. 1021.83

SERIES F No 96A
SHEET 77 OF 103

17