


WOOD GUARD RAIL REQUIRED  
 RIGHT 51 LENGTH 23  
 STA 246+00 TO 247+19  
 LEFT 35 LENGTH 23  
 STA 246+00 TO 247+19  
 TOTAL THIS SHEET 48


NEW CULVERTS REQUIRED  
 STA 247+00 36  
 18" REIN. CONCRETE OR CAST IRON PIPE LENGTH 38 FT.  
 CLASS A (12-4) CONCRETE 4% C.V.  
 REINFORCING STEEL 60 LB.

FED. ROAD DIST. NO.	STATE	FISCAL YEAR	SHEET NO.	TOTAL SHEETS
1	VI.	969	1427	20

PLAN  
 REVISIONS  
 NOTE BOOK  
 BY OR WILL CHECKED  
 DATE

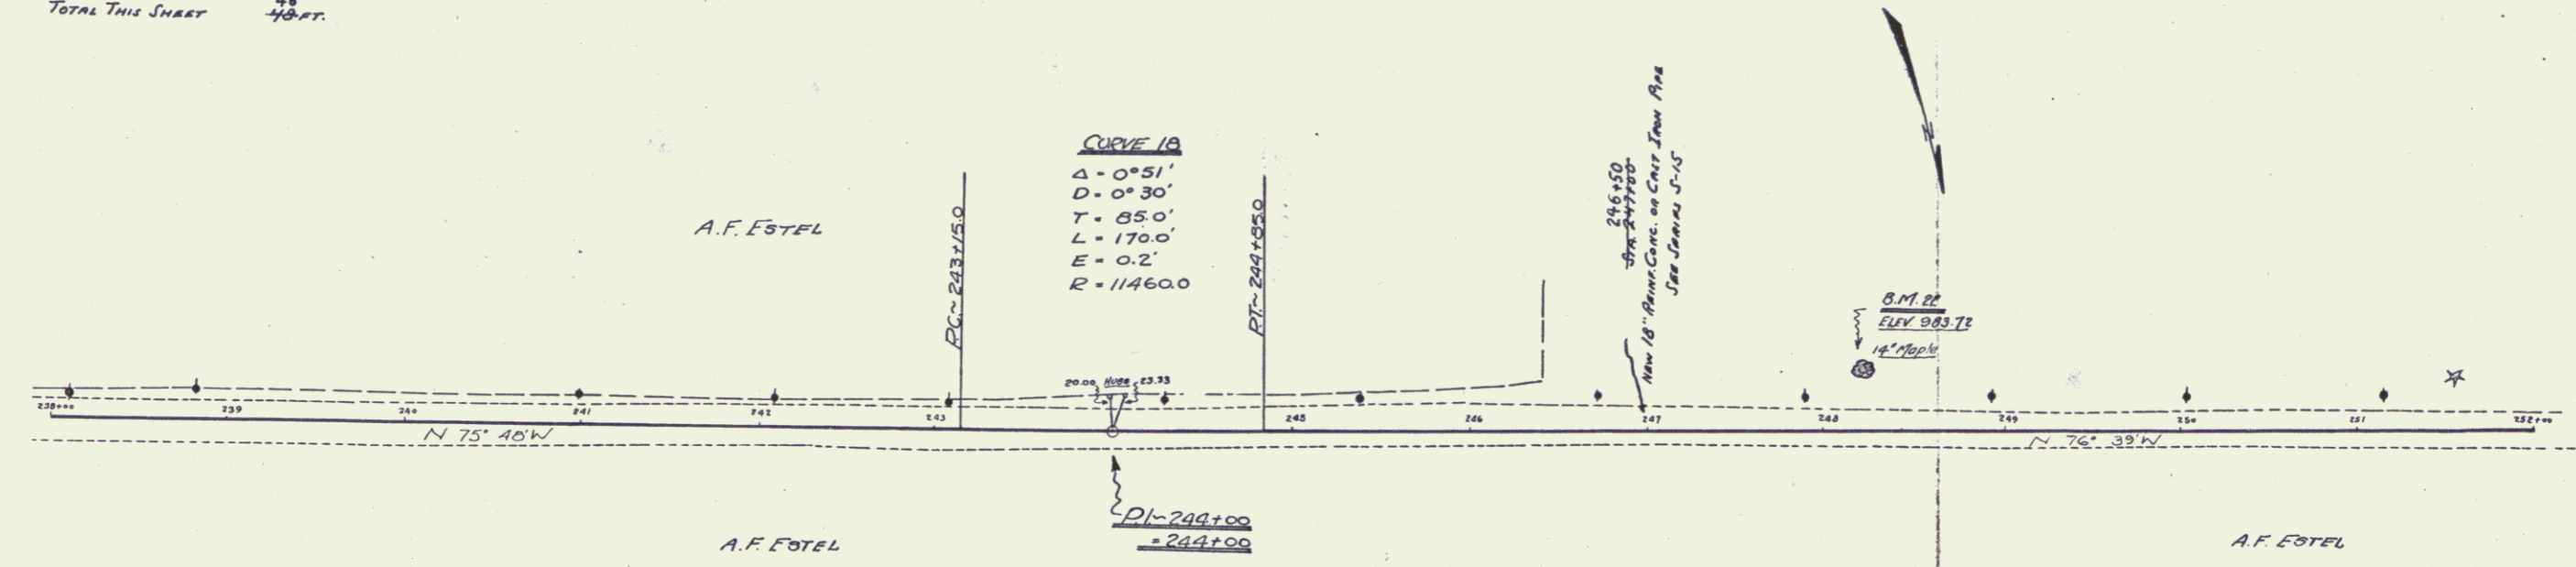

PROFILE  
 REVISIONS  
 NOTE BOOK  
 BY OR WILL CHECKED  
 DATE

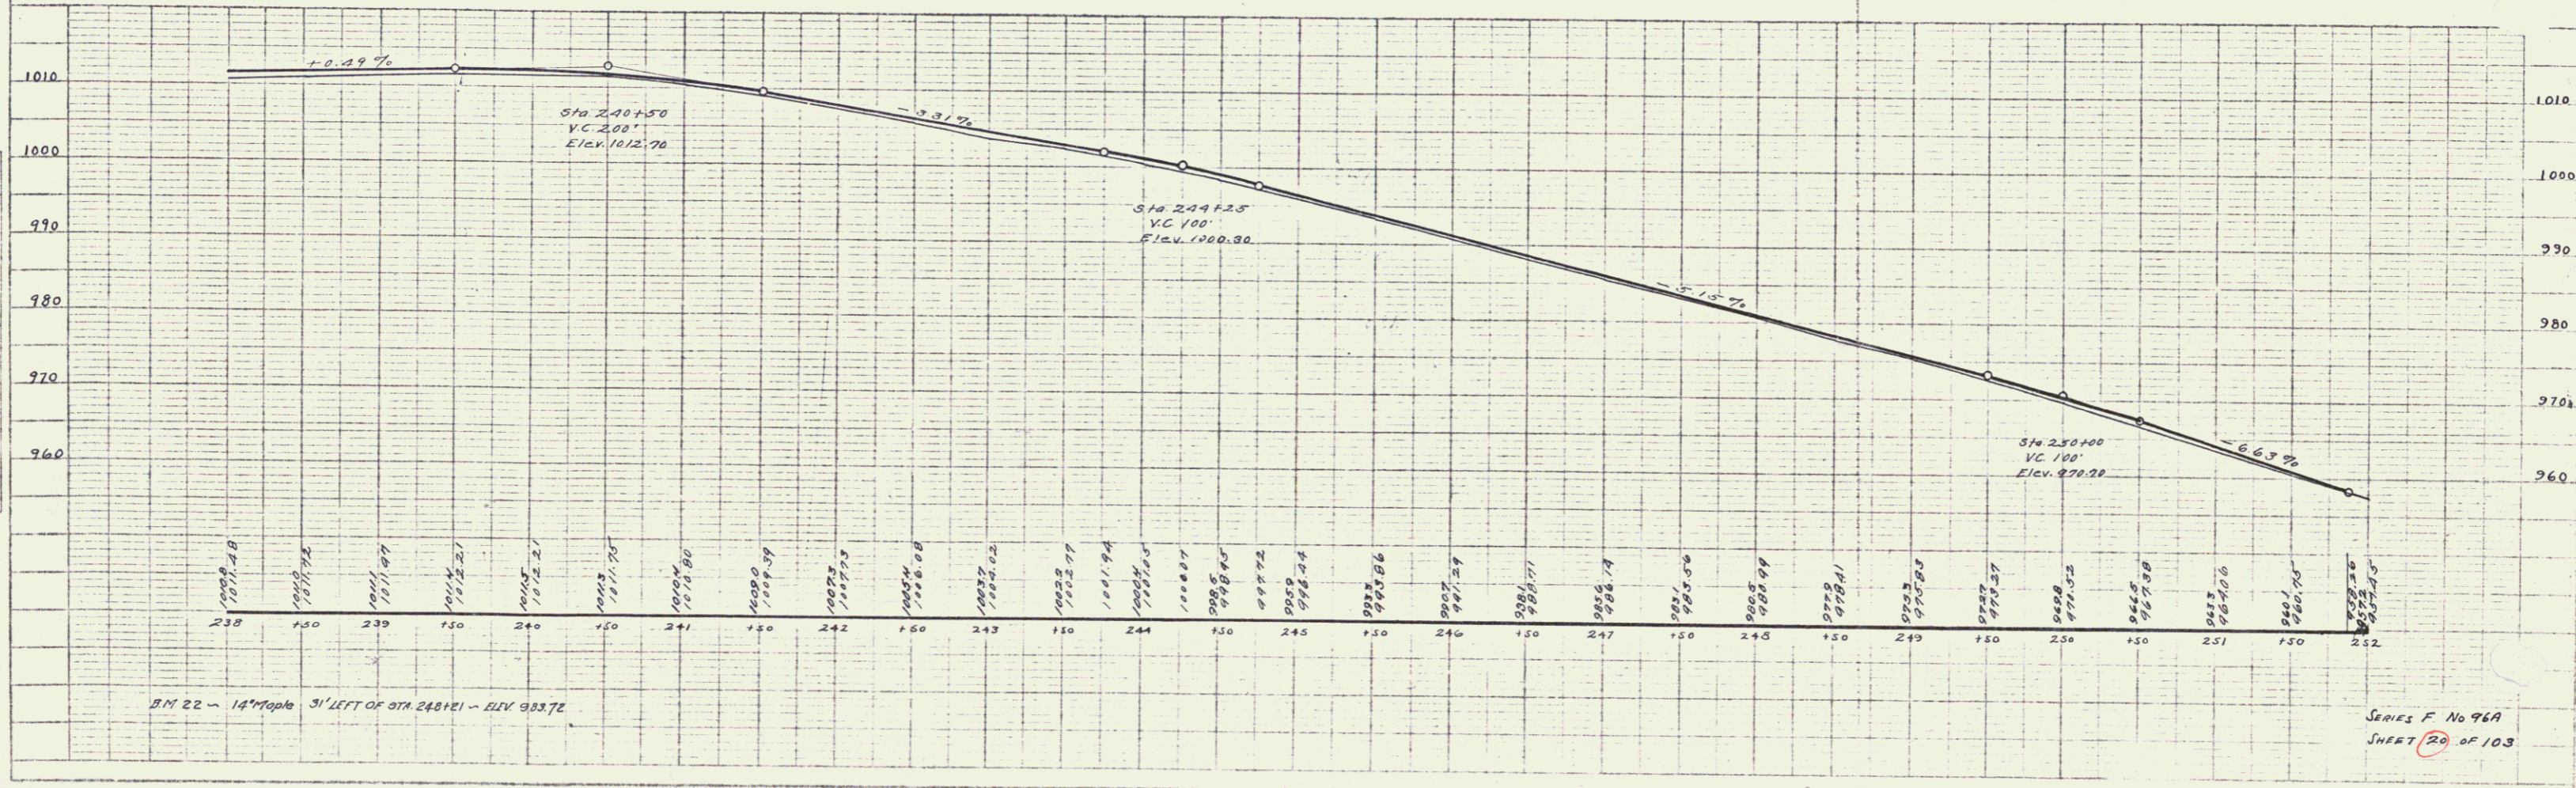

SERIES F No 96A  
 SHEET 20 OF 103

20