


REMOVAL AND DISPOSAL OF PRESENT GUARD RAIL  
 LT 1186-2+16  
 2+275-2+58  
 RT 1170-2+09  
 2+195-2+50

EXCAVATION & REMOVAL OF ROAD SURFACE ON DISCONTINUED HIGHWAYS  
 5+20 LT-14+00


COUNTY OF CALEDONIA  
 TOWN OF SUTTON  
 COUNTY OF ORLEANS  
 TOWN OF BARTON

THREE CABLE GUARD RAIL WITH STEEL POSTS  
 LT 1130-2+00  
 1+70-2+83  
 RT 1130-2+190  
 1+40-3+06

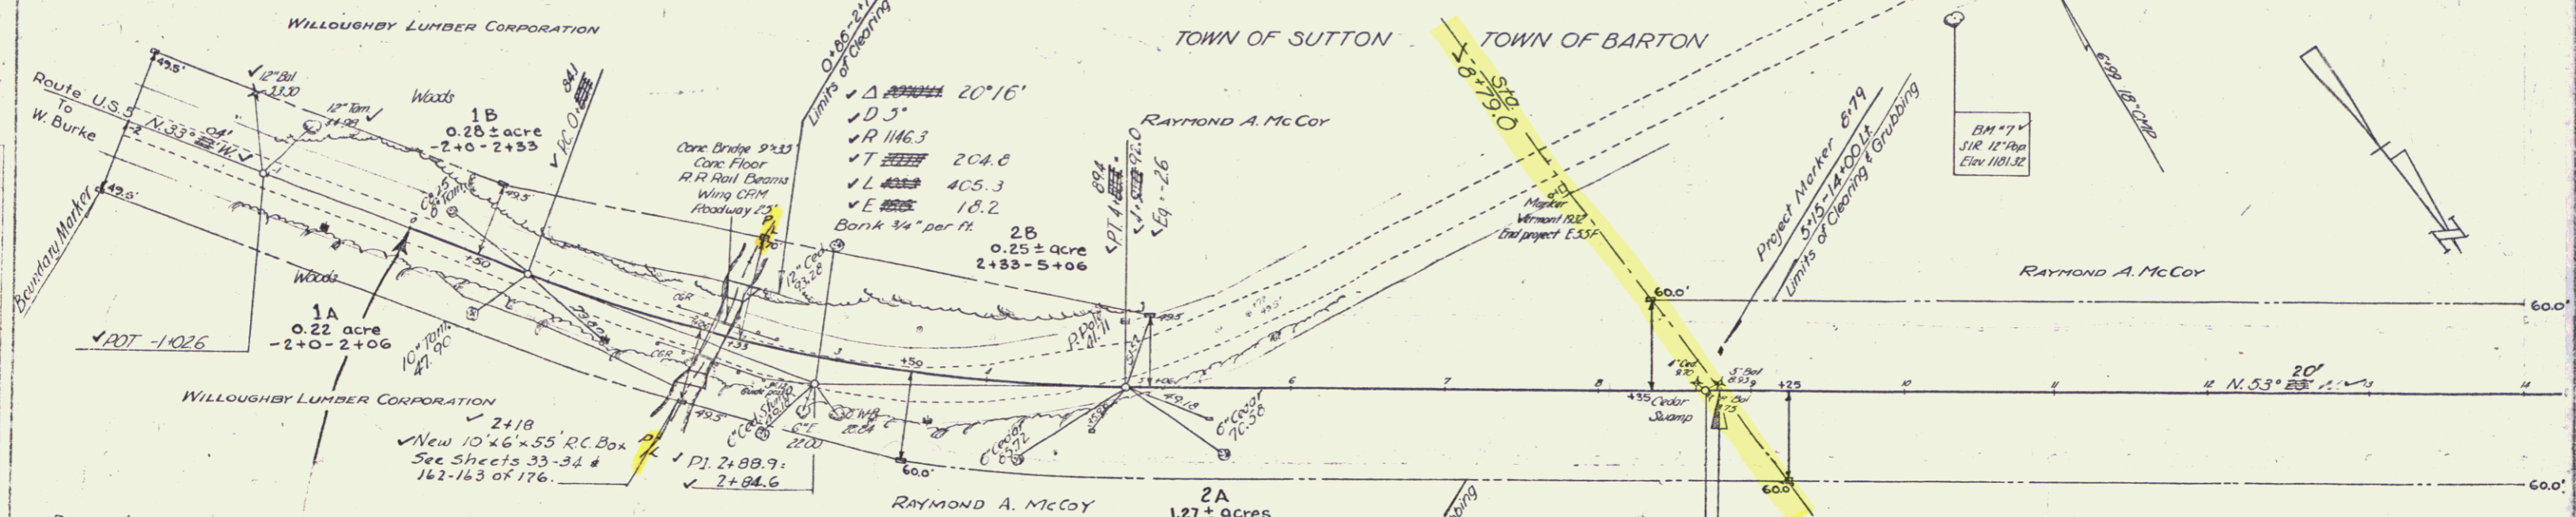

PARCEL	INSTRUMENT	DATE	GRANTOR	GRANTEE	RECORDED	TOWN	BOOK	PAGE	DATE	REMARKS
1A-B	Corp Q.C.D.	2-27-54	WILLOUGHBY LUMBER CORP	St. of Vr.	SUTTON	30	229	3-11-54	(SEE ALSO SHEET 18)	
2A-B	W.D.	11-25-53	RAYMOND A. MCCOY		"	30	225	2-19-54	(SEE ALSO SHEET 17)	

Control of section of old highway between Sutton-Barton town line and station 84+25, 21+53 ft., relinquished to Town of Barton. Recorded Book A, Page 117, Barton Road Records, March 15, 1956.

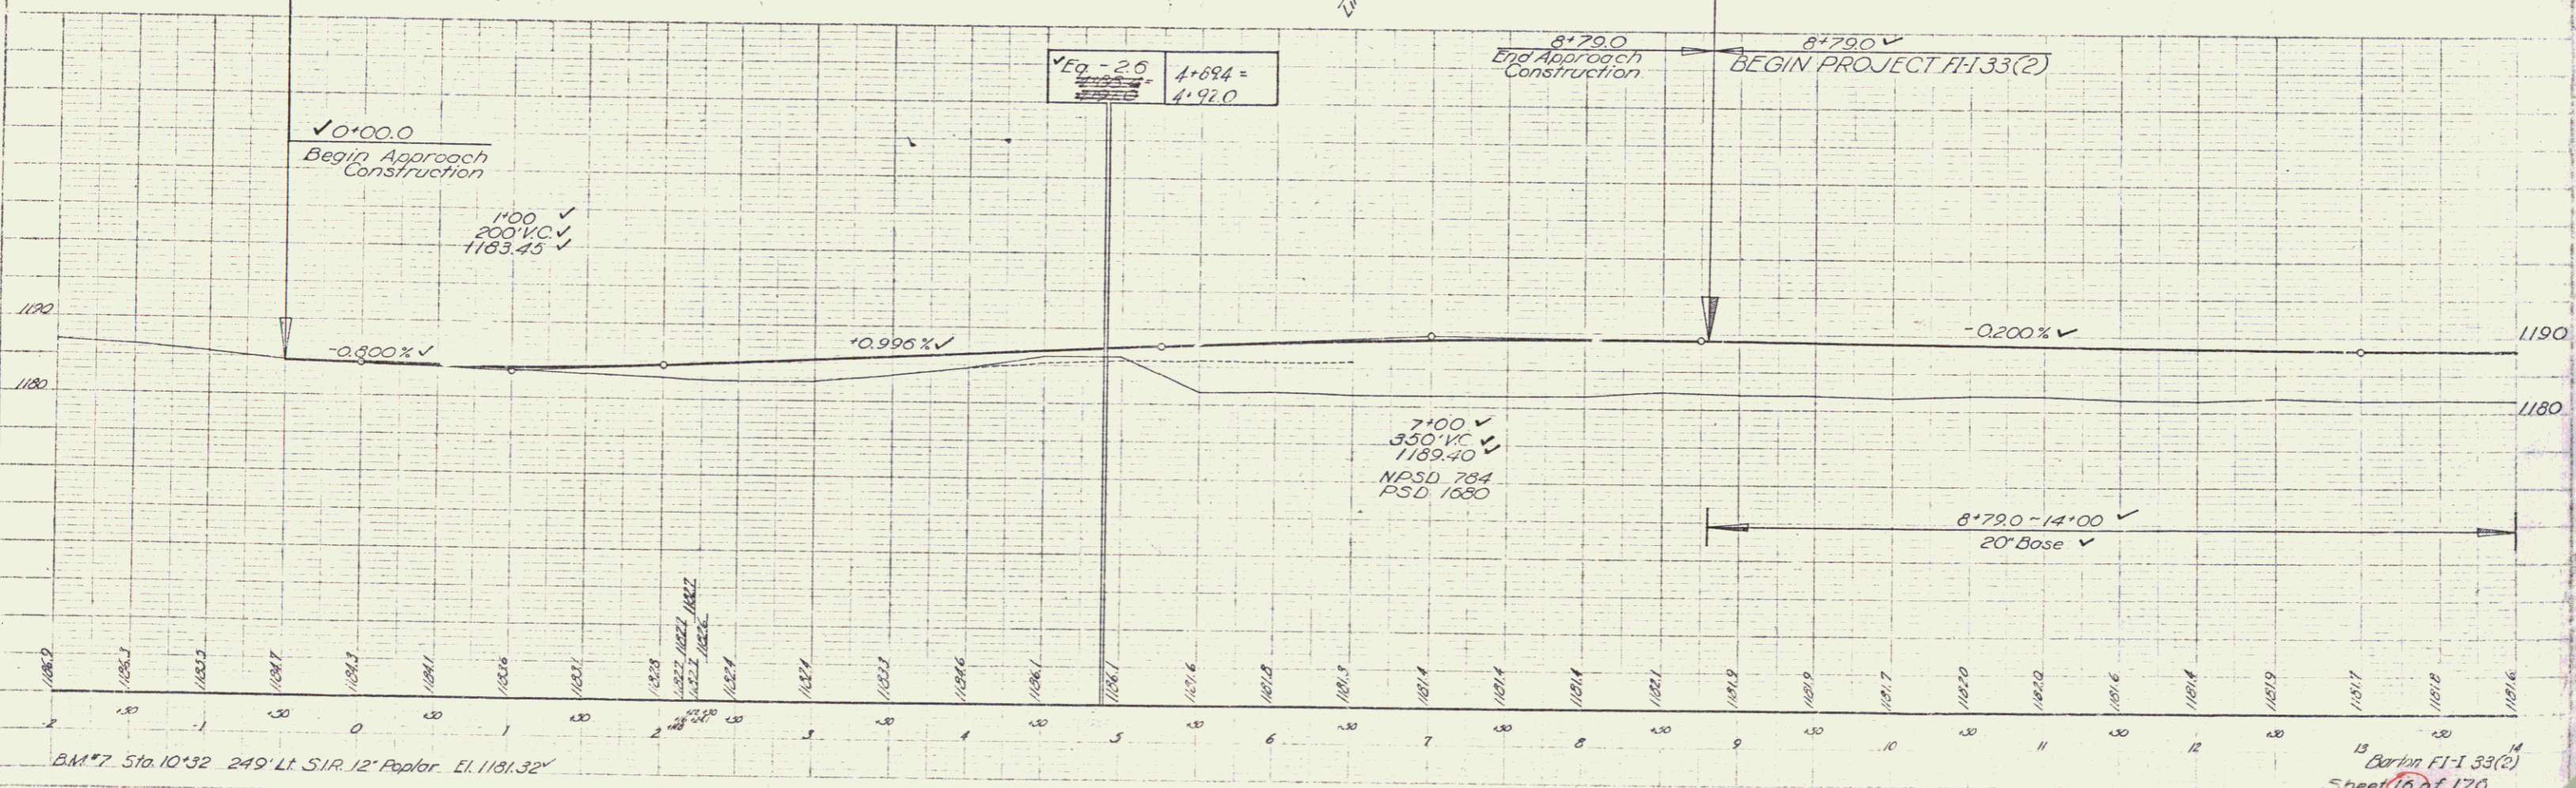

B.M. #7 Sta. 10+32 249' Lt. S.I.R. 12" Poplar. El. 1181.32'

Barton F1-1 33(2)  
 Sheet 16 of 170

2