


PARCEL	INSTRUMENT	DATE	GRANTOR	GRANTEE	RECORDED	REMARKS
3-C-D-E	WD	11-25-53	RAYMOND A. MCCOY	37 of Vt. Barton	48	361 2-9-54
6	CORP QCD	2-27-54	WILLOUGHBY LUMBER COOP		48	369 3-10-54
7-A-B	WD	4-3-54	PERLEY & MILDRED GRAMMO		48	392 4-14-54
8	WD	3-12-54	ELLEN M. CANTY		48	370 3-18-54

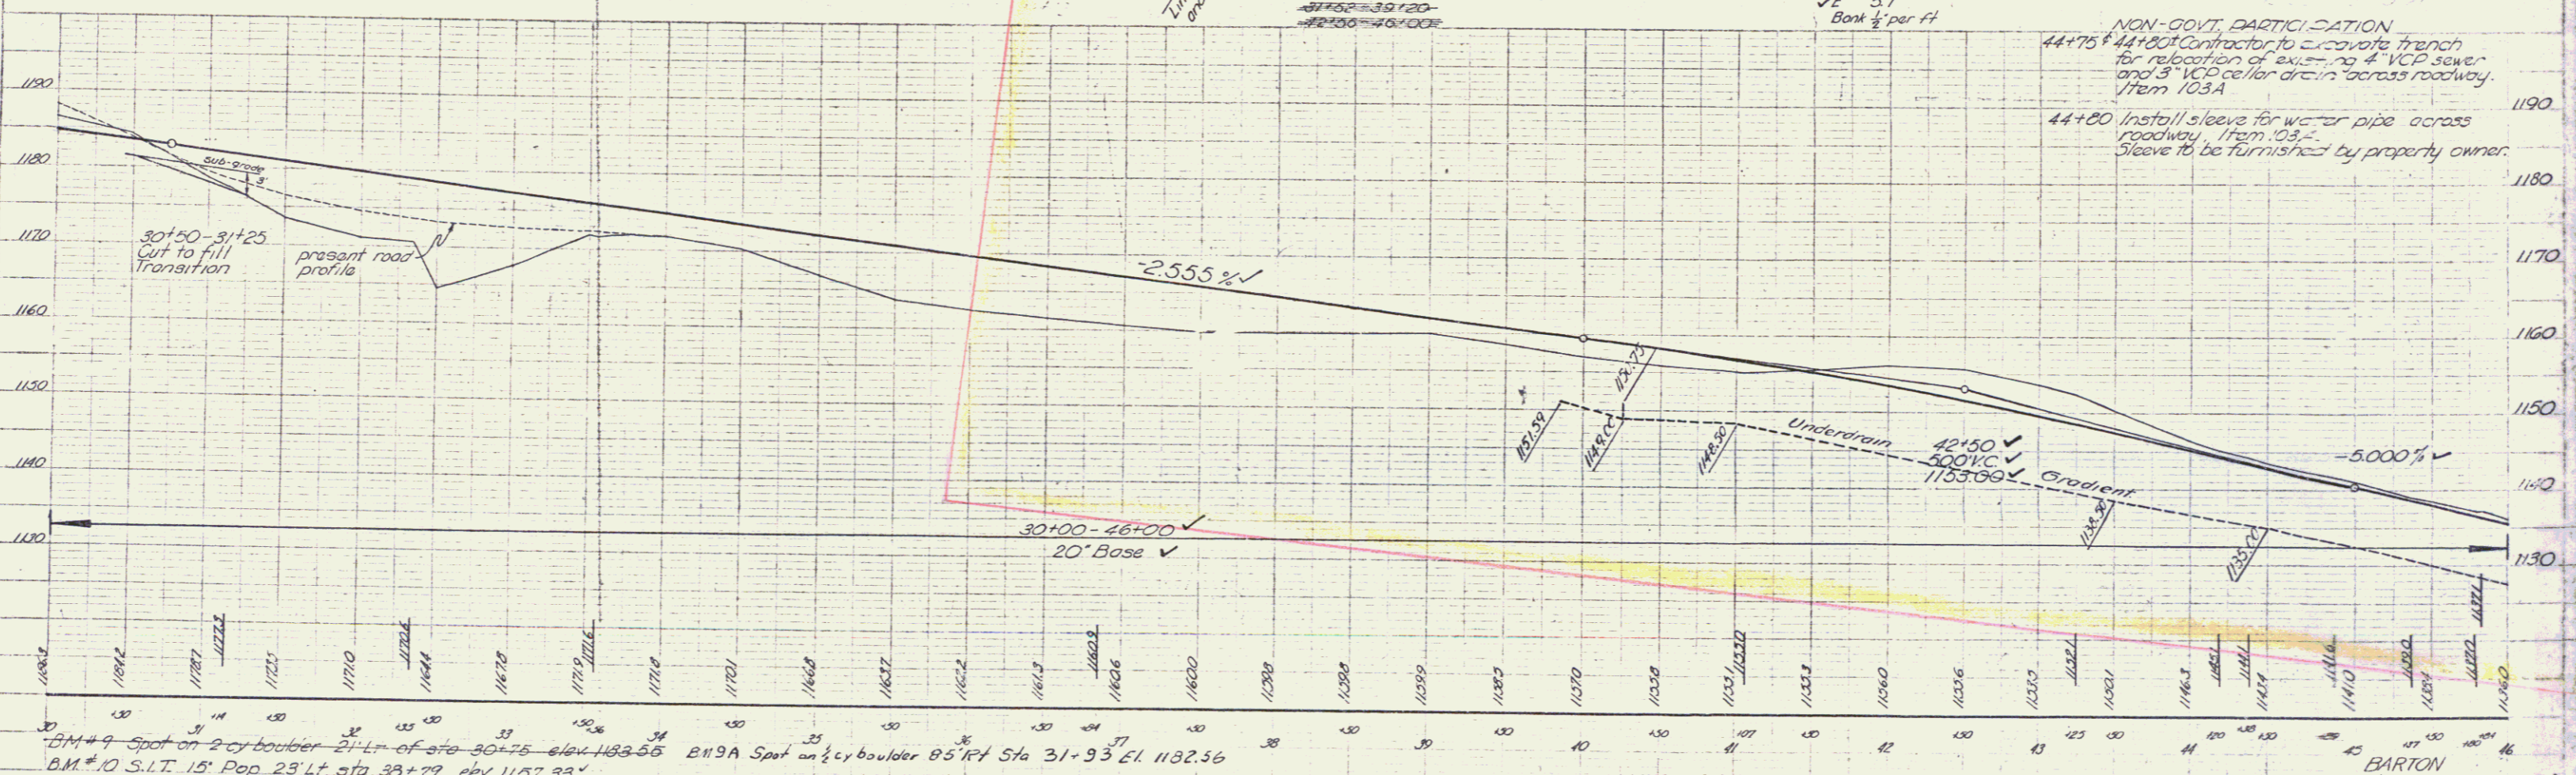

BM #9 Spot on 2' cy boulder 21' Lt. of sta 30+75 elev 1183.55
 BM #10 S.I.T. 15' Pop. 25' Lt. of sta 38+79 elev 1157.33

BARTON
 Project #1 No. 33(2)
 sheet 10 of 170