


| BRIDGE DATA | | |
|-------------------------------------|---------|----------|
| Type | Present | Proposed |
| Overall Span Along E. of Flood | 125.5' | 54.3' |
| Roadway Width, Face to Face of Curb | 19.0' | 40.0' |
| Clear Span Along E. of Roadway | 14.0' | 49.4' |
| Clear Span Normal to Stream | 13.0' | 46.8' |
| Clear Height to Low Bridge Seat | 6.0' | 10.0' |
| Max High Water Elev. | 958.4' | |
| Waterway | | |
| to Low Bridge Seat | 70° | 290° |
| to Mar. H.W. Elev. | | 724° |
| to Norm. H.W. Elev. | 70° | 133° |
| Normal High Water Elev. | | 955.8' |
| Drift | none | none |
| Stream Velocity | | 7.5/Sec |
| Scour | none | none |

| Sheet No. | LIST OF BRIDGE SHEETS |
|-----------|------------------------------|
| 25 | Plan |
| 26 | Profile |
| 40 | Details of Superstructure |
| 41 | Details of Abutment #1 & 2 |
| 59 | Reinforcing Steel Sheet |
| 51 | Standard SB 5-C-1 |
| 53 | Standard SB-20, Det. C,H,K,L |

| SUMMARY OF ESTIMATED QUANTITIES | | |
|--|-------|--------|
| Item | Final | Unit |
| 107 Structure Excavation | 36 | cuy |
| 106A Channel Excavation of Earth | 1190 | cuy |
| 407 Asphaltic Asbestos Coating | 13 | sq ft |
| 381 Bit Concrete Fmnt. for Bridge Floors | 27 | sq yds |
| 401-B Concrete Class B (mod.) | 178 | cuy |
| 521 Stone Fill | 705 | cuy |
| 402 Reinforcing Steel | 20071 | lbs |
| 403A Structural Steel | 60000 | lbs |
| 501 Furnishing Equip for Driving Piles | 1 | hr |
| 504 Steel Piling | 1120 | lf |
| 504-1 Cut-offs for Steel Piling | 96 | lf |
| 542 Two Cable Guard Rail | 108 | lf |

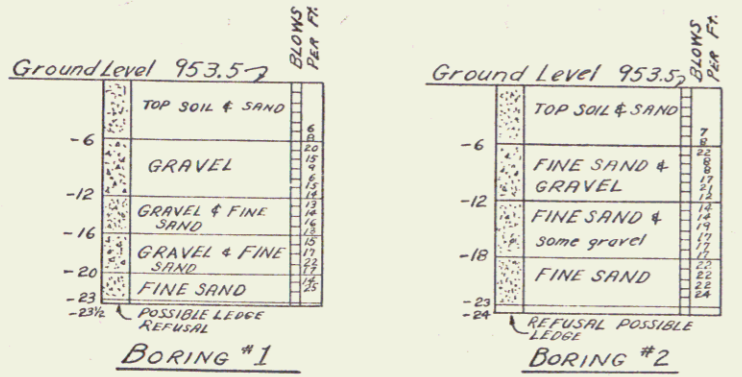

Blows per foot indicate the number of blows necessary to drive a casing, whose outside diameter is 2 1/2" and whose thickness is 3/8", one foot, using a hammer which weighs 350 pounds and drops 24".

| PARCEL | INSTRUMENT | DATE | GRANTOR | GRANTEE | RECORDED | REMARKS |
|--------|------------|---------|-------------------------|---------|----------------------|-------------------|
| 19A-B | W.D. | 3-23-54 | CLINTON & HELEN LIBBY | Stofyt | BARTON 48 382 4-1-54 | SEE ALSO SHEET 23 |
| 20A-B | W.D. | 3-23-54 | PERLEY J & EVA S. NAULT | " | BARTON 48 384 4-1-54 | SEE ALSO SHEET 27 |

BARTON FI-133(2)
Sheet (25) of 176