


PARCEL	INSTRUMENT	DATE	GRANTOR	GRANTEE	TOWN	RECORDED BOOK PAGE DATE	REMARKS
25	W.D.E.	3-23-54	FLYNN L. GRAVES	STOBYT	BARTON	48 385-386 4-1-54	SEE ALSO PAGE 28
26	COND.	3-5-54	ALBIA G. WIGHTMAN	"	"	D-MISC 4-5 3-5-54	
27	COND.	3-5-54	CLIFTON & EDITH DE GREENIA	"	"	D-MISC 4-5 3-5-54	
28	COND.	3-5-54	MARY S. HARDY	"	"	D-MISC 4-5 3-5-54	
11-B	COND.	3-5-54	ELMER L. ANNIS	"	"	D-MISC 4-5 3-5-54	SEE ALSO SHEET 20.
26-A	W.D.E.	7-2-54	ALBIA G. WIGHTMAN	"	"	48 424 7-10-54	

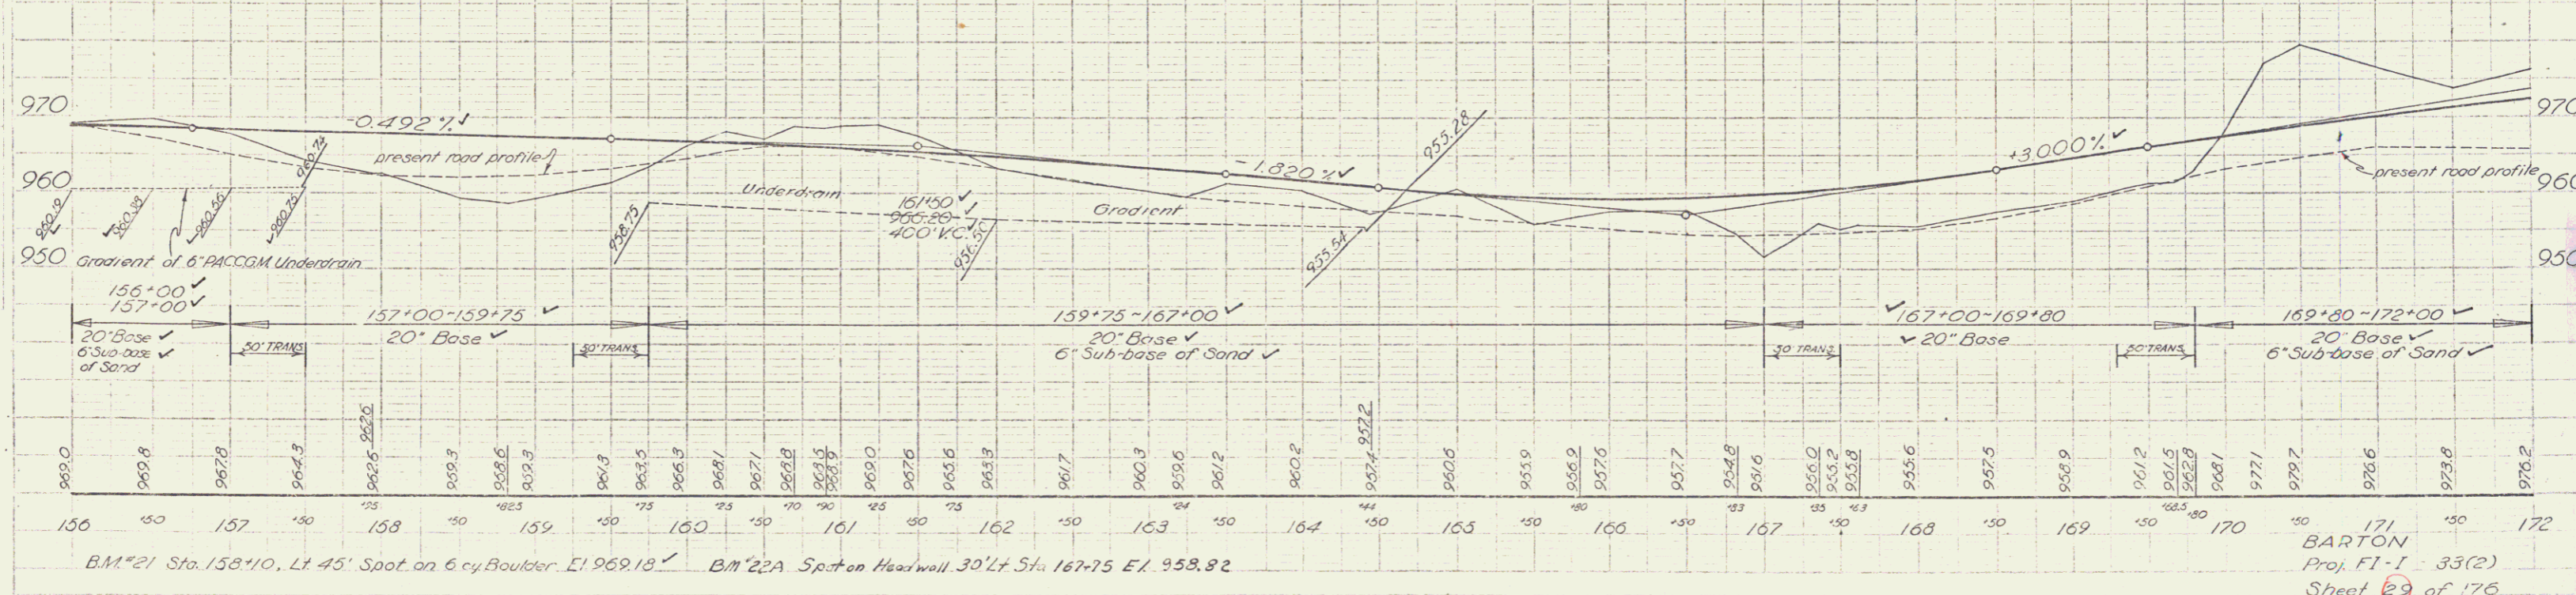

- VA 27'31" RI
- VD 4'
- VR 1432.7
- VT 350.8
- VL 687.9
- VE 42.3
- Bank 3/4' per ft.

B.M. #21 Sta. 158+10, Lt. 45' Spot on 6 cy Boulder. E.I. 969.18 ✓ B.M. #22A Spot on Headwall 30' Lt. Sta. 167+75 E.I. 958.82

BARTON  
Proj. FI-1 33(2)  
Sheet 29 of 176