
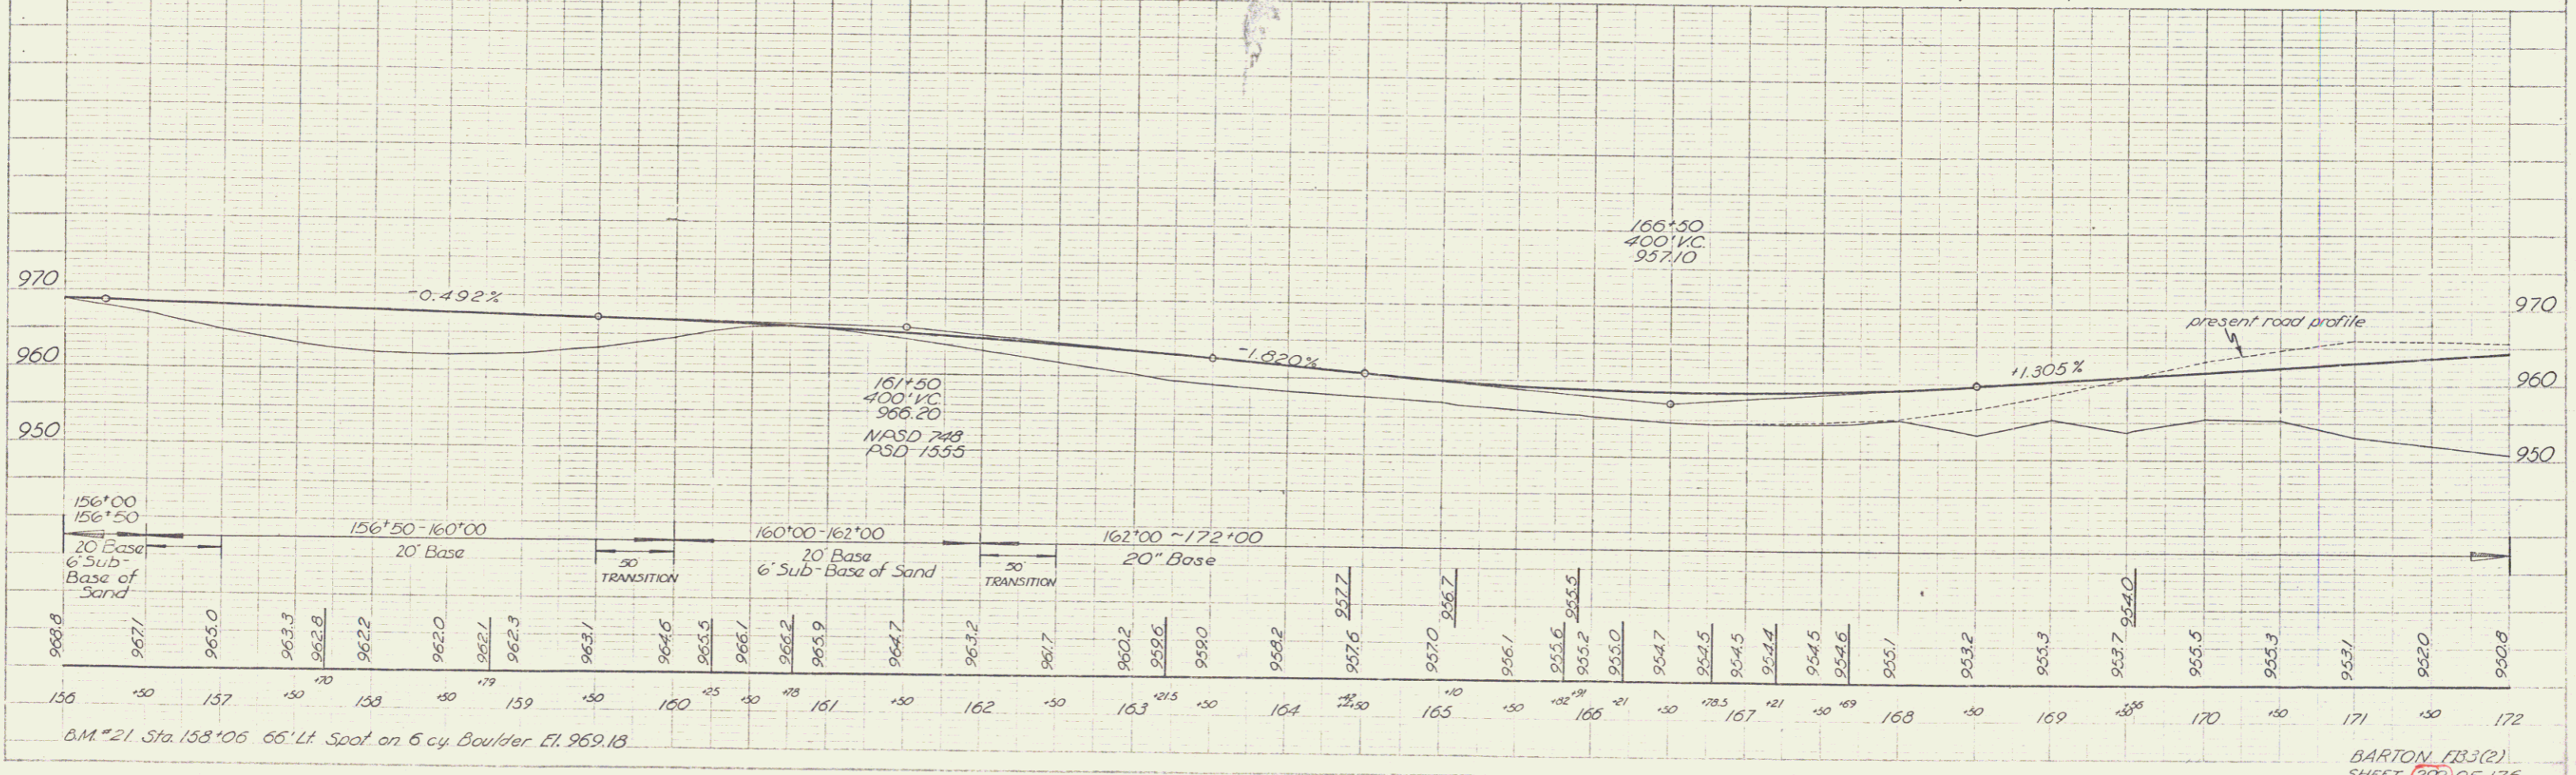


PLAN  
 SHEET NO. 18  
 DATE 10/1/50  
 DRAWN BY MILLER  
 CHECKED BY MILLER

PLAN  
 SHEET NO. 18  
 DATE 10/1/50  
 DRAWN BY MILLER  
 CHECKED BY MILLER

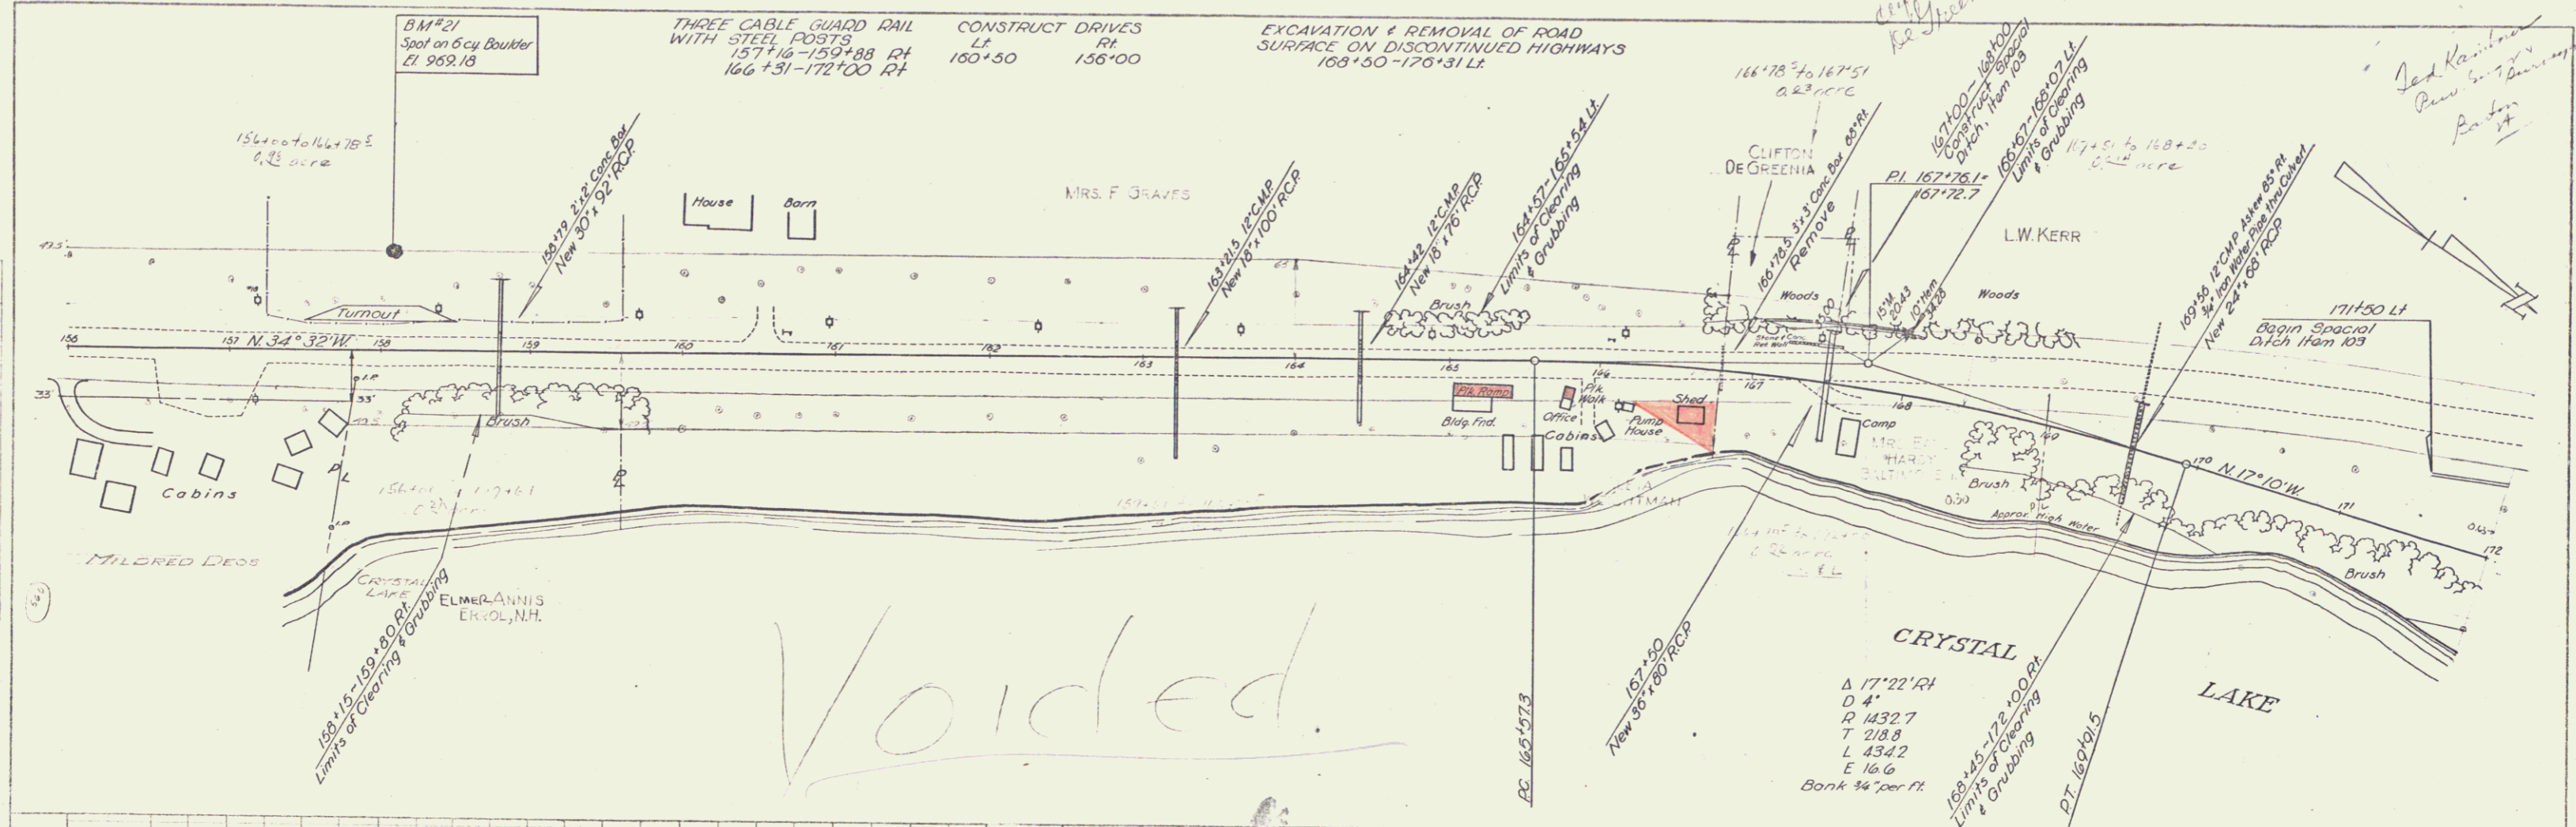

B.M. #21 Sta. 158+06. 66' Lt. Spot on 6 cy. Boulder. El. 969.18

BARTON (E3)(2)  
 SHEET 18 OF 176