



SEEDING ITEM 611 & TOPSOIL ITEM 621
- 188+25 - 189+95 Rt V

CONSTRUCT DRIVES
L 1
V 195+00
V 196+00
V 197+00
189+70

THREE CABLE GUARD RAIL
WITH STEEL POSTS
- 188+00 - 188+08 Rt V
- 197+59 - 201+00 Rt V

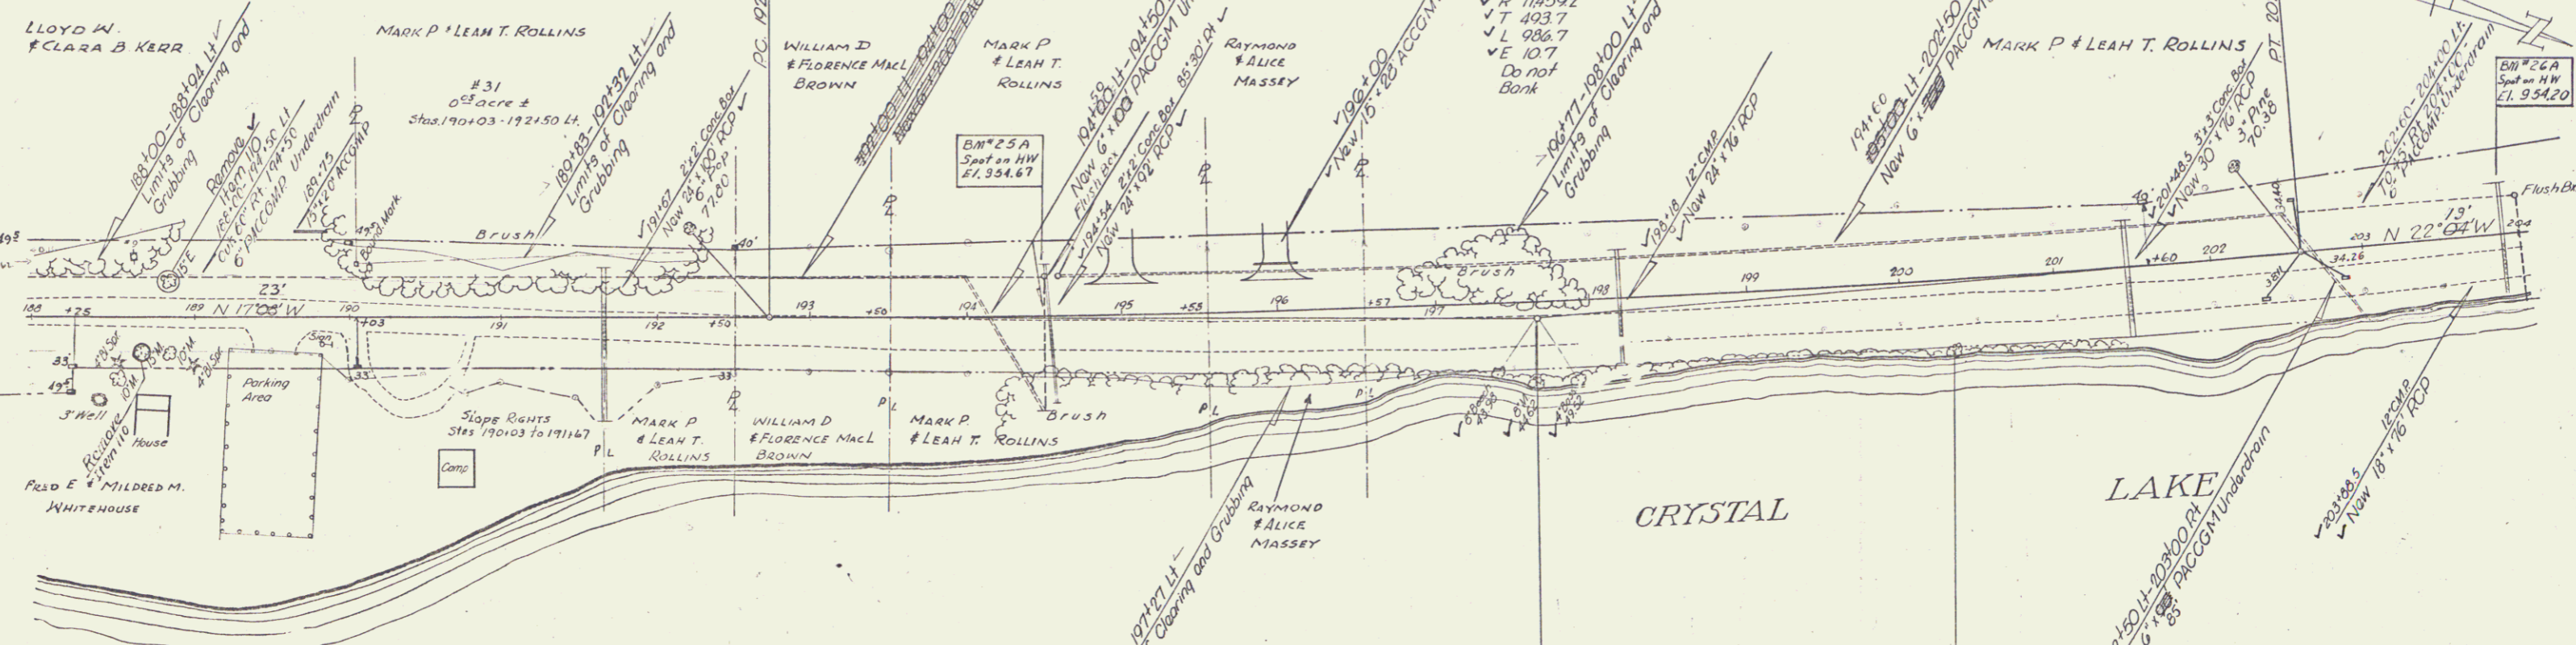

PARCEL	INSTRUMENT	DATE	GRANTOR	GRANTEE	RECORDED	REMARKS
31	WD	3-24-54	MARK P & LEAH T. ROLLINS	ST OF VT. BARTON 48	386	4-1-54 SEE ALSO SHEET 32

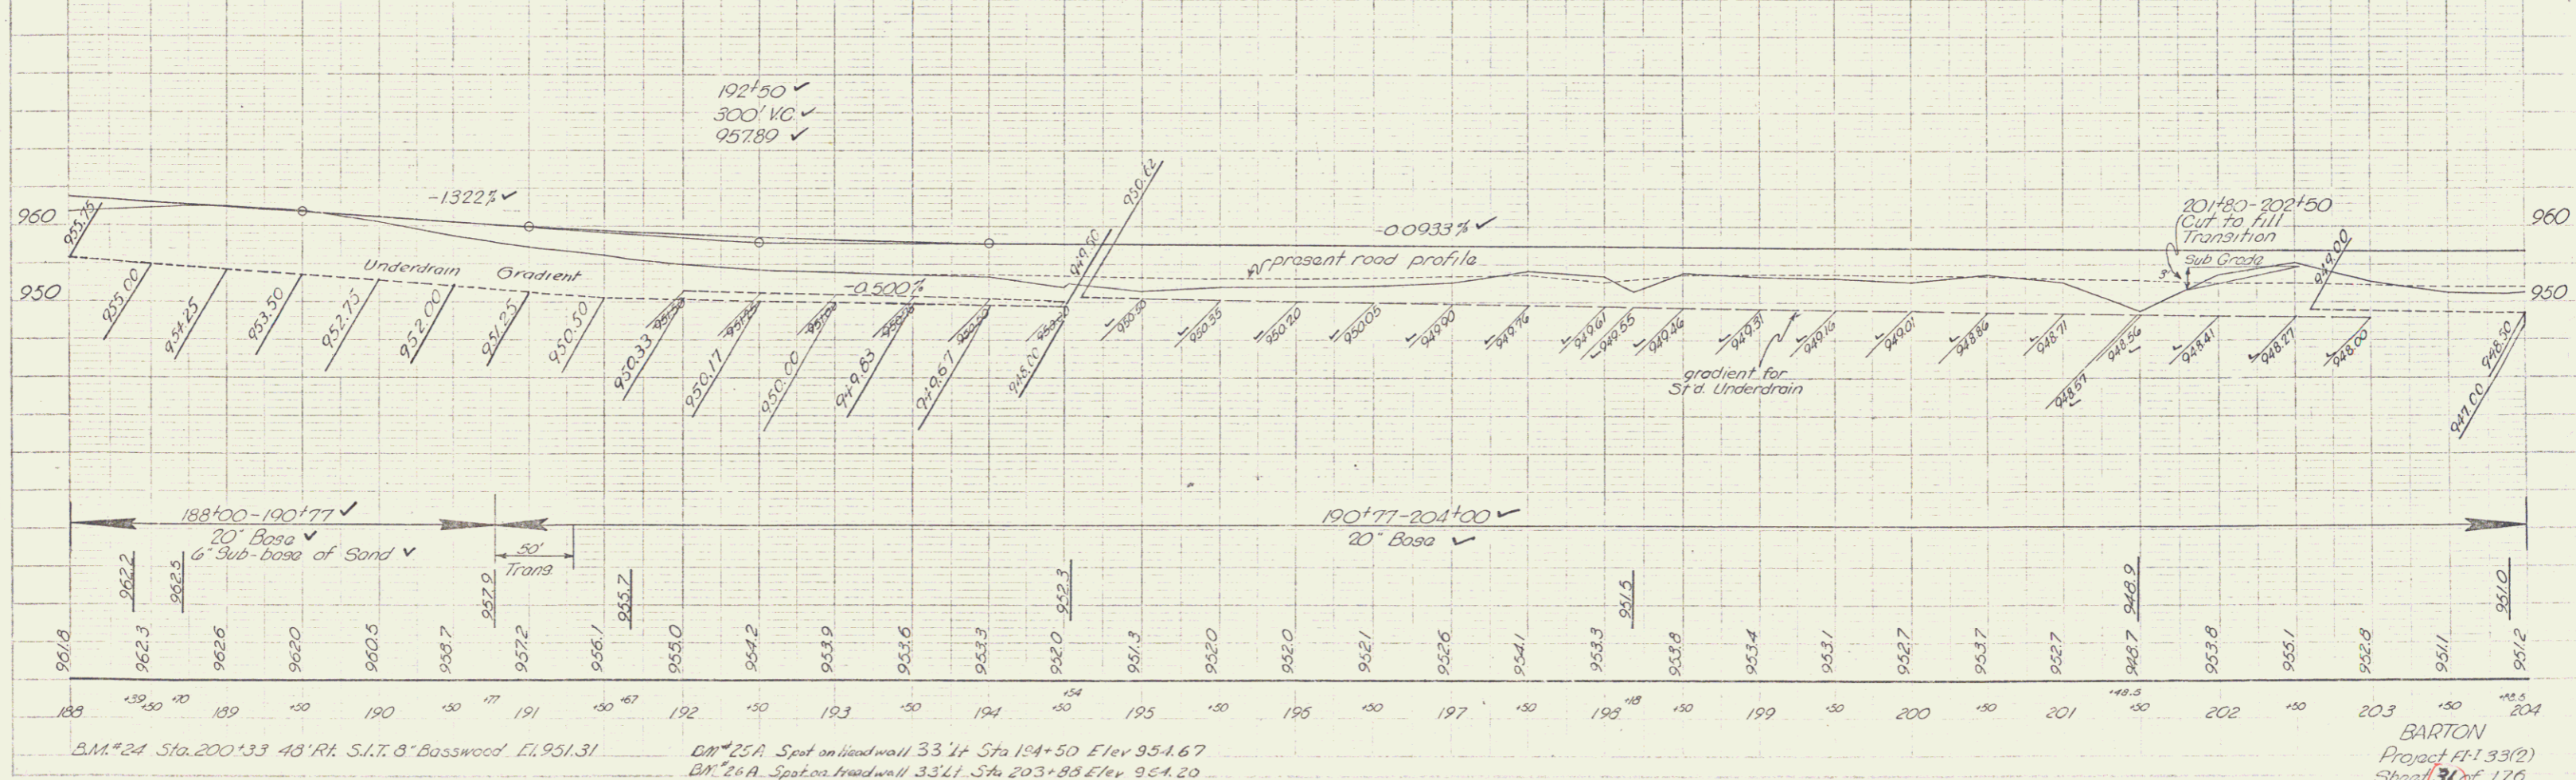

B.M. #24 Sta. 200+33 48' Rt. S.I.T. 8" Basswood El. 951.31

B.M. #25A Spot on Roadwall 33' Lt Sta 194+50 El. 954.67
B.M. #26A Spot on Roadwall 33' Lt Sta 203+88 El. 954.20

BARTON
Project FF-133(2)
Sheet 31 of 176