


Title
 Project
 Date
 Scale
 No. of Sheets
 No. of this Sheet

F.A.G.N.
 53-47 1939 7 50A

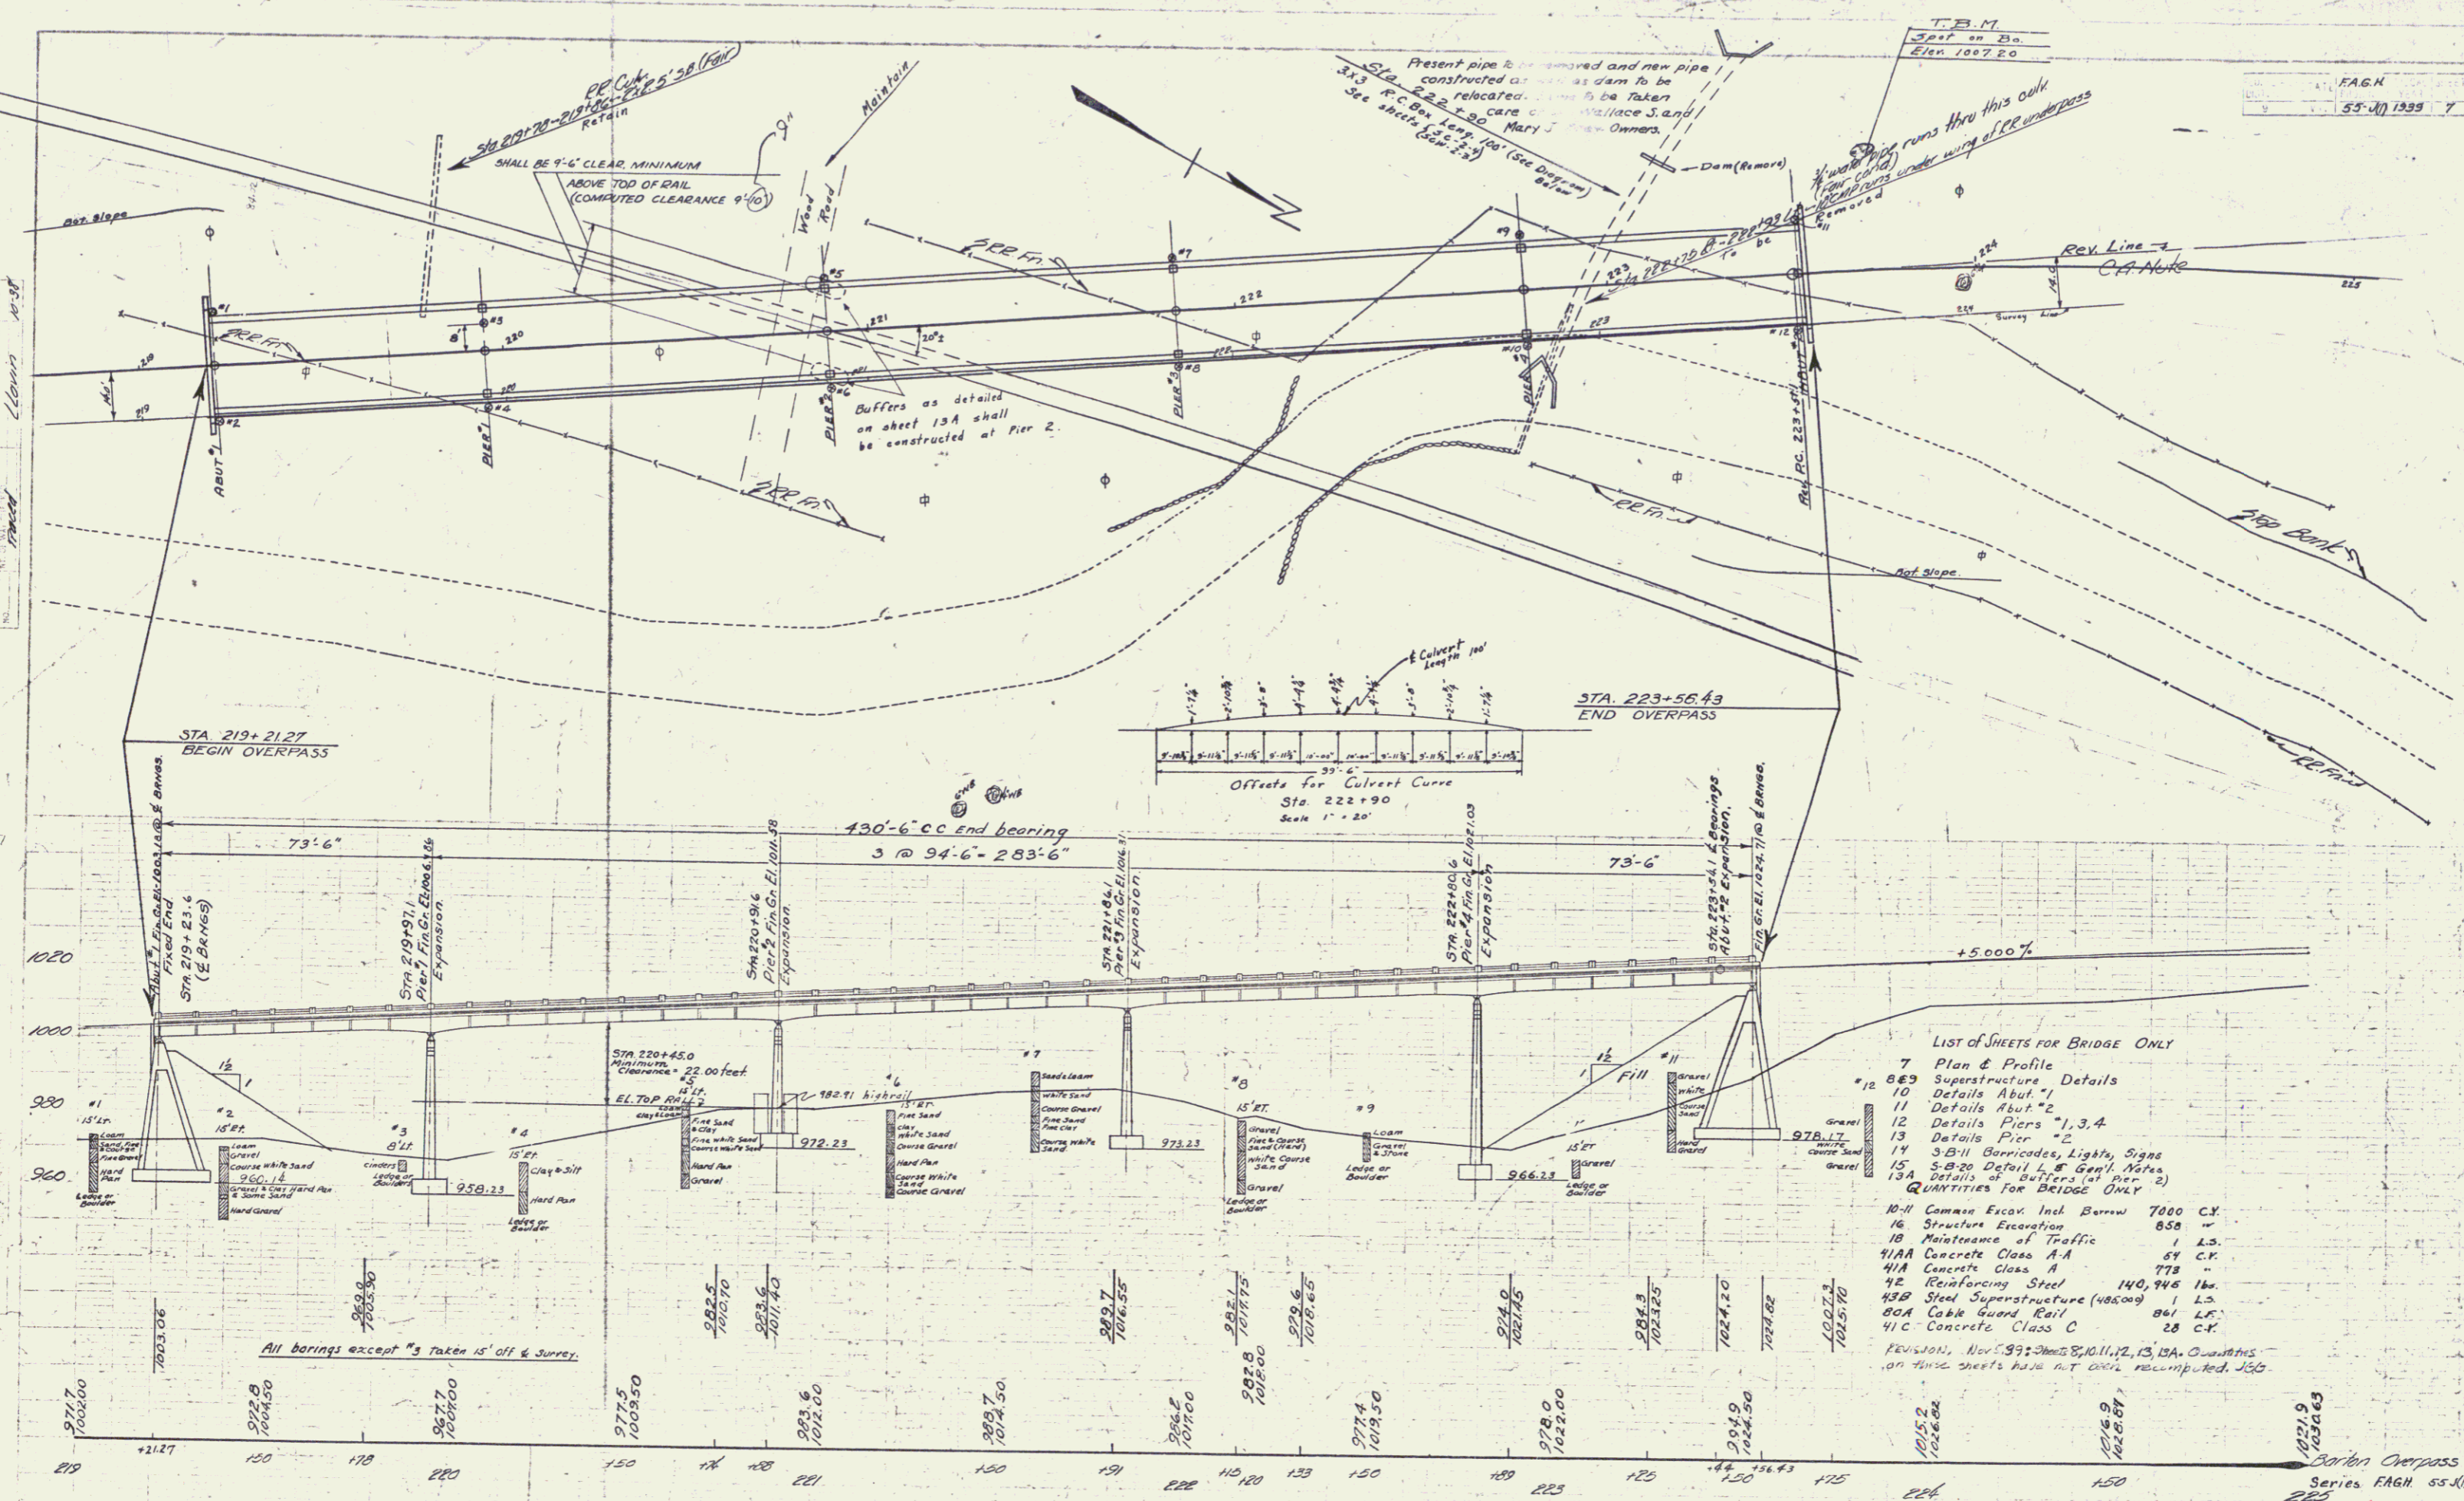

LIST OF SHEETS FOR BRIDGE ONLY

- 7 Plan & Profile
- 8 Superstructure Details
- 9 Details Abut #1
- 10 Details Abut #2
- 11 Details Pier #1, 3, 4
- 12 Details Pier #2
- 13 3-B'II Barricades, Lights, Signs
- 14 5-B'II Detail 1, 8' Guard Posts
- 15 Details of buffers (at pier 2)
- QUANTITIES FOR BRIDGE ONLY
- 16 Common Excav. Incl. Borrow 7000 C.Y.
- 17 Structure Excavation 850 "
- 18 Maintenance of Traffic 1 L.S.
- 41A Concrete Class A-A 64 C.Y.
- 41B Concrete Class A 778 "
- 42 Reinforcing Steel 140,748 lbs.
- 43B Steel Superstructure (48000) 1 L.S.
- 44A Cable Guard Rail 841 L.S.
- 41C Concrete Class C 28 C.Y.

REVISIONS, Nov. 29, 1939: Sheets 8, 10, 11, 12, 13, 15A, C. Quantities on these sheets have not been recomputed. J.S.B.

T.B.M. Spot on double STA 223+73.45' U. Elev. 1007.20

Station Overpass
 Series F.A.G.N. 53-47
 Sheet 7 of 50A