

NOTE:


-FOUR TREES BETWEEN 253+00± TO 254+55± ARE TO BE SAVED AS INDICATED. IF DAMAGED BY CONTRACTOR TREES ARE TO BE REPLACED BY HIM WITHOUT COMPENSATION.

Mrs Rosabelle Valley

Albert Valley

Her Ho

Garage

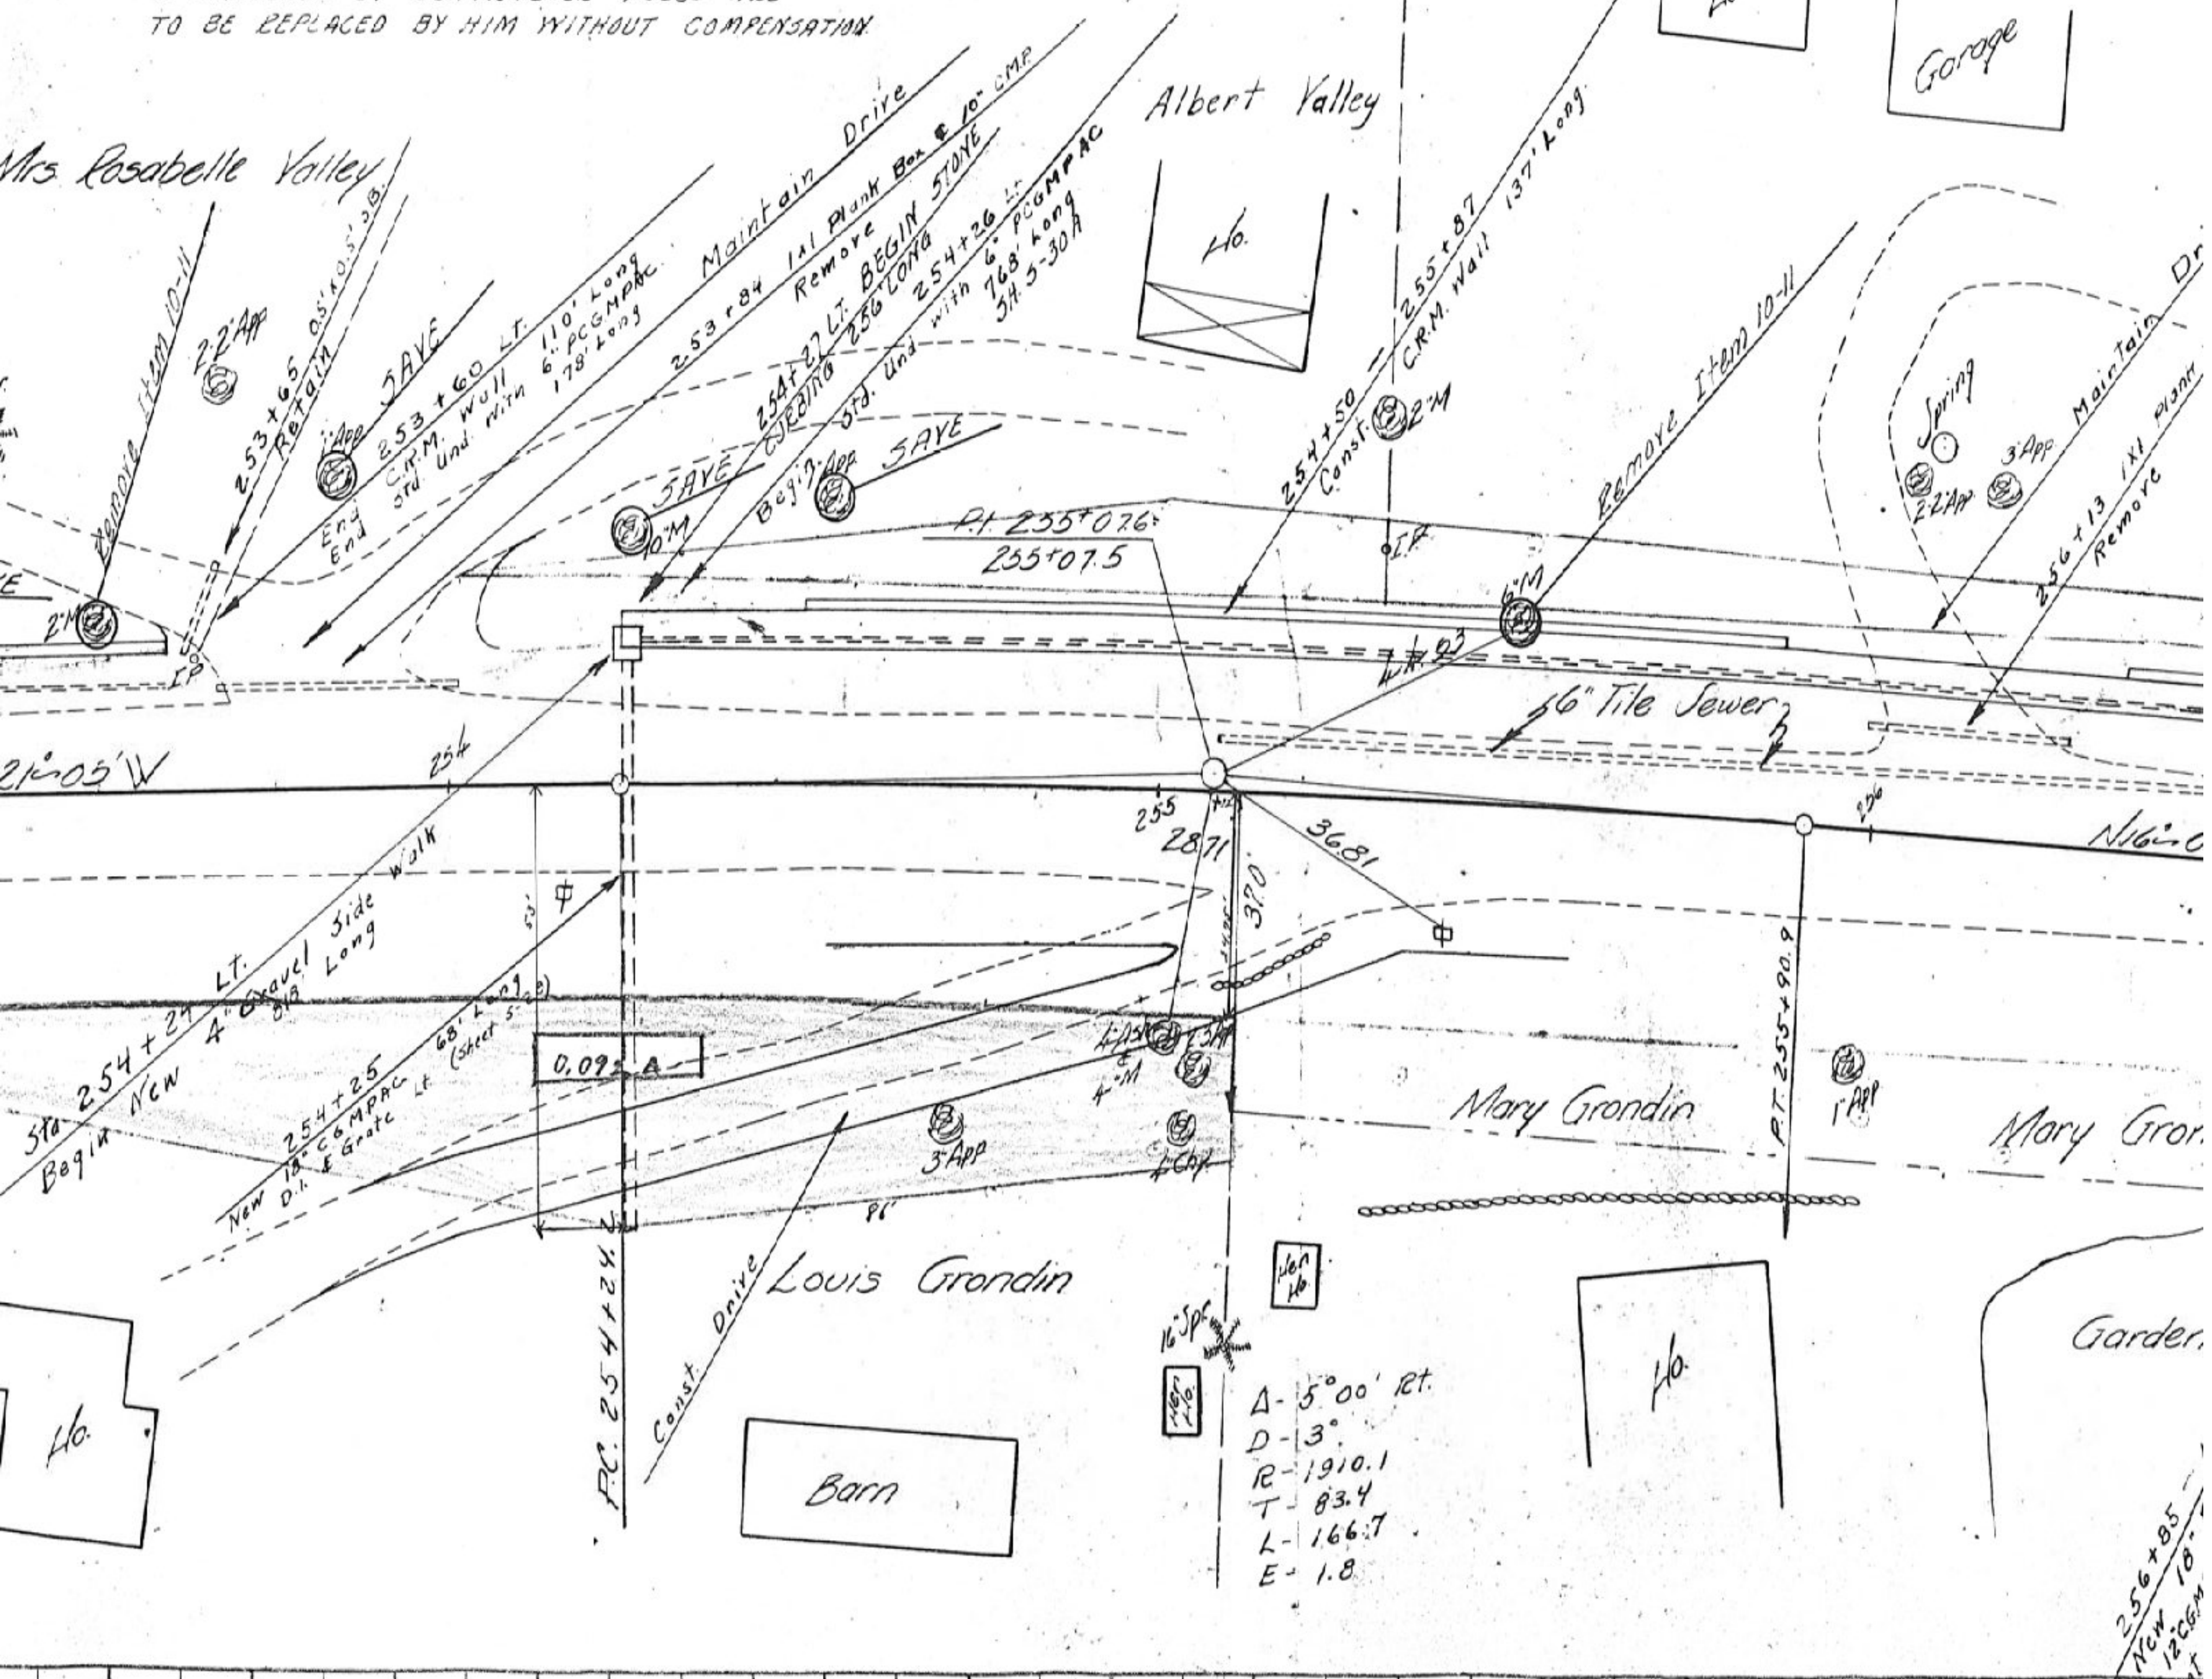

0.09± A

Δ - 5° 00' RT.
 D - 3'
 R - 1910.1
 T - 83.4
 L - 166.7
 E - 1.8

256+85
 New 10'
 12' CMP