

WOOD GUARD RAIL REQUIRED
CULVERT STATION LEFT RIGHT

79+50	24
79+00	24

CABLE GUARD RAIL REQUIRED

STATION	TO STATION	LEFT	CONSTANT	PAYERS
75+22	76+30	168	40	2.08
77+12	79+33	221	20	2.41
79+33	80+00	67	2.0	87

NEW REIN. CONCRETE PIPE CULVERTS REQUIRED

STATION	TO STATION	LEFT	CONSTANT	PAYERS	STATION	DIRM.	LENS.	CONC.	STEEL
75+22	76+30	168	40	2.08	75+52	18"	56'	3.0cy.	3.3 lbs.
79+00	79+00	12"	4'	1.7	88				


STD. UNDERDRAIN WITH 6" PERP CORR. GALV. METAL PIPE REQUIRED

STATION	TO STATION	LEFT	RIGHT
74+00	75+00		100 FT.

FILE NO.	55A	193V	9	75
DIST. NO.				
SHEET NO.				

Date
 Mr. [Name]
 [Address]
 [City, State]

Date
 Mr. [Name]
 [Address]
 [City, State]

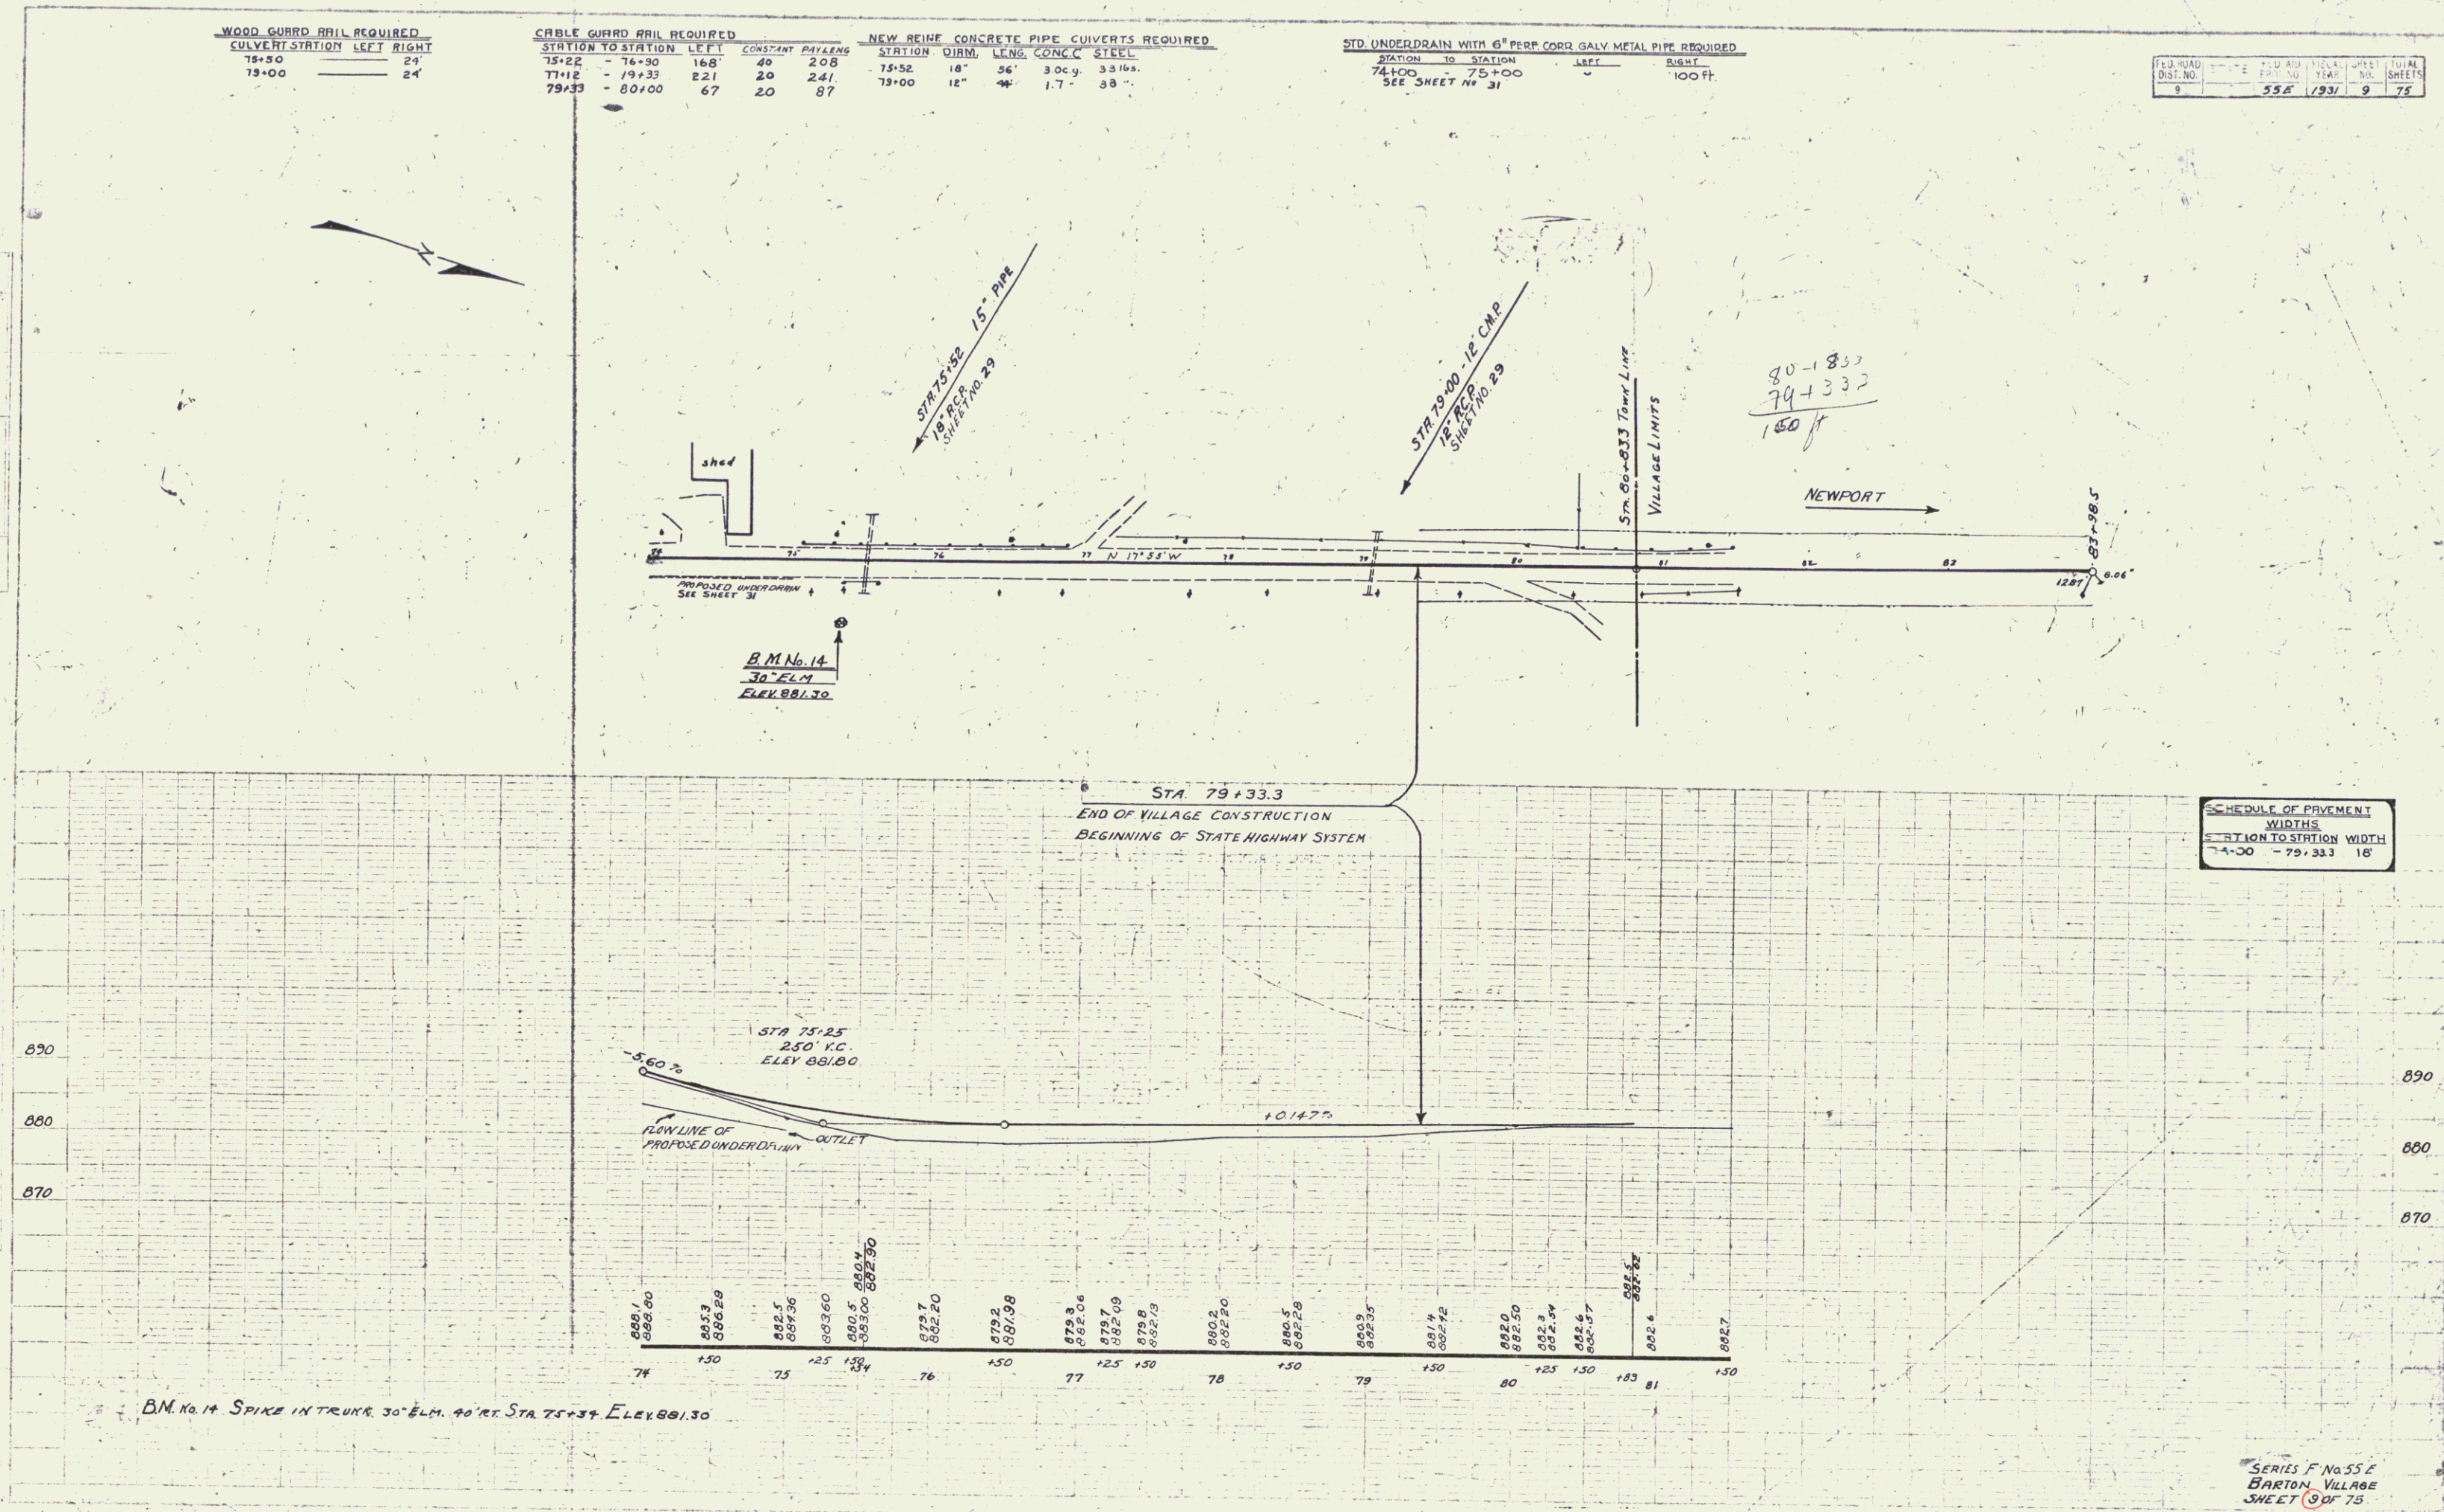

SCHEDULE OF PAVEMENT WIDTHS

STATION TO STATION	WIDTH	
74+00	79+33.3	16'

B.M. No. 14 SPIKE IN TRUNK 30' ELM. 40' RT. STA. 75+39. ELEV. 881.30

SERIES F No. 55
BARTON VILLAGE
SHEET 3 OF 75

3