


**CABLE GUARD RAIL REQUIRED**

STATIONS	L or R	Length	Constant	Qty
114+05-114+53	L	48'	20'	68'
114+21-114+53	R	32'	20'	52'
114+36-114+44	L	8'	20'	60'
114+25-114+21	L	36'	40'	136'

FED. ROAD DIST. NO. 55 E DATE 1931 FISCAL SHEET No. 15 OF 75

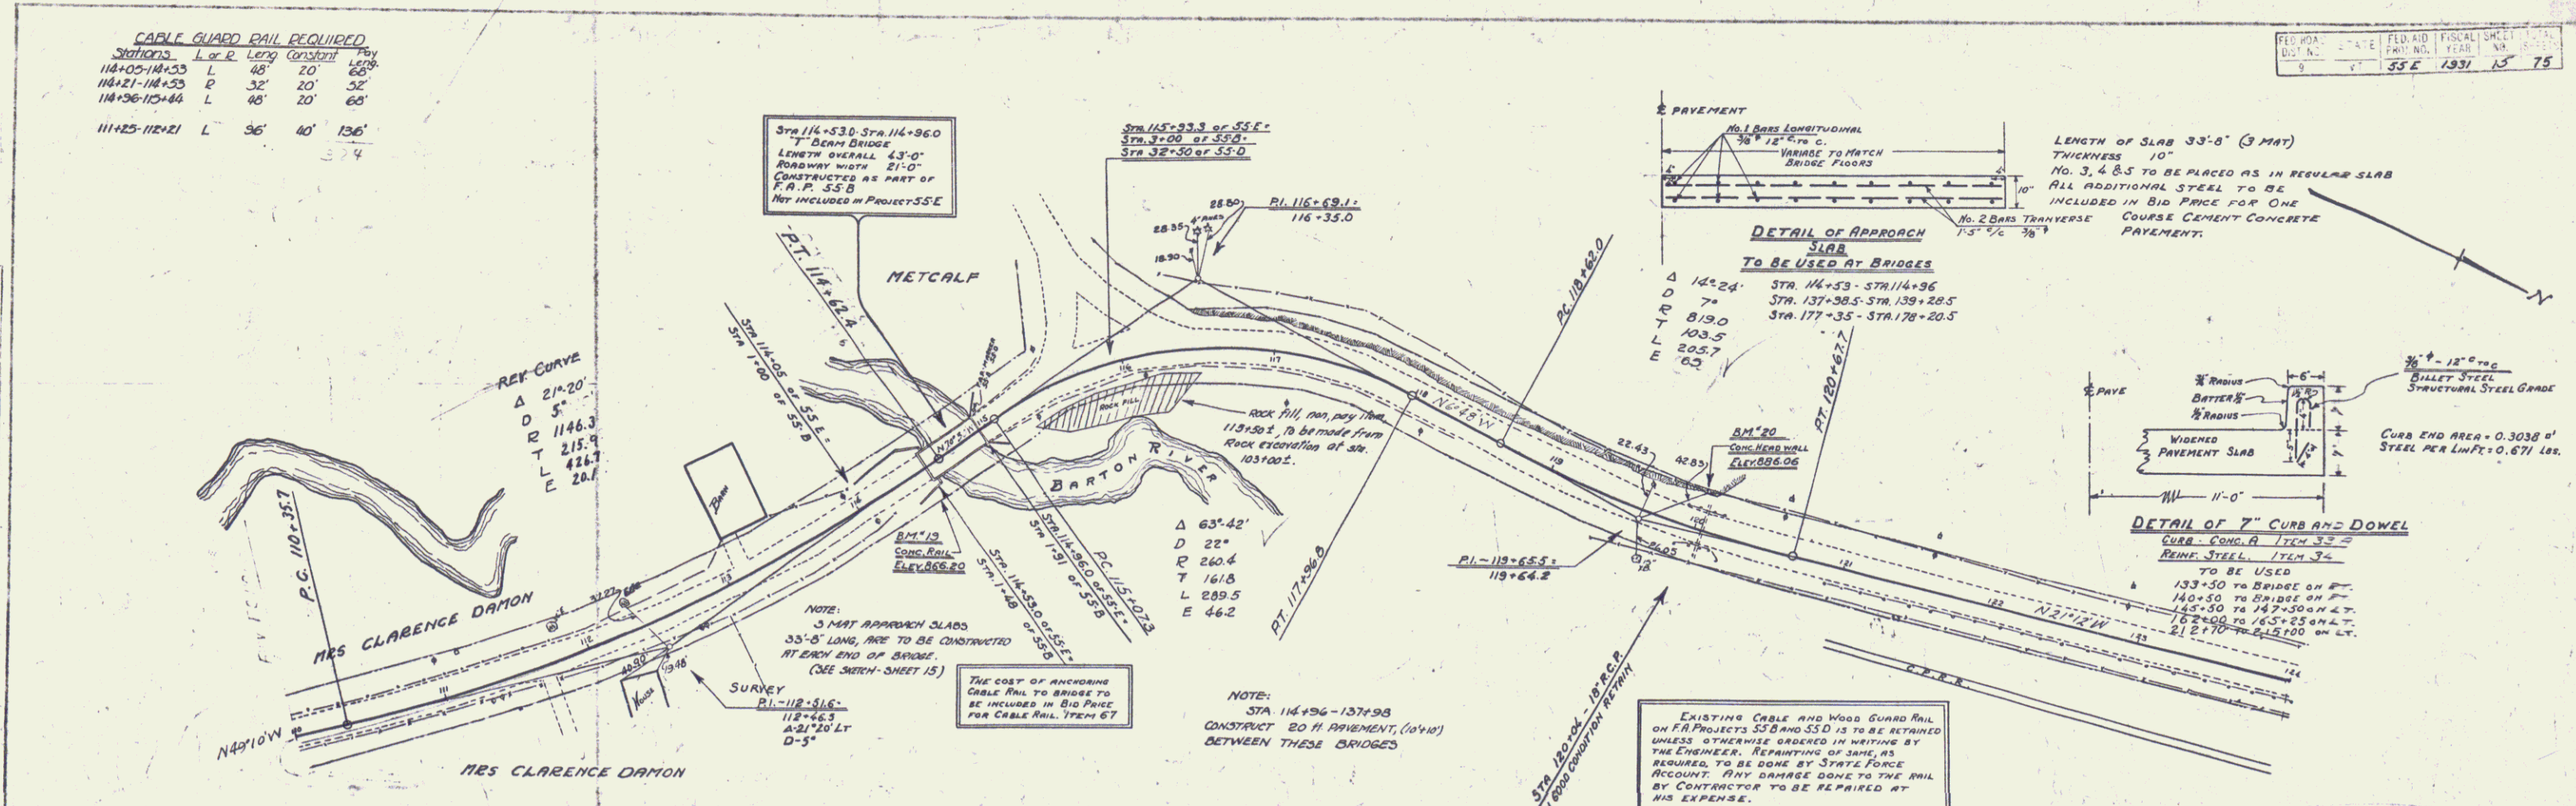


**LINE REVISION**

DATE	BY	REVISION
JUNE 18, 1931		
ORIG.	REV.	
PI - 112+516	112+389	
A - 112+46.5	112+344	
D - 21' 20" LT	21' 20" LT	
D - 5'	4' 30"	

LINE S PARALLEL TO RIGHT DURING CONSTRUCTION CHANGED BACK TO ORIGINAL SURVEY LINE.

**CURVE REVISION**

ORIG. PT.	REV. PT.	REV. DATA
114+74.2	114+72.5	Ea = +1.7

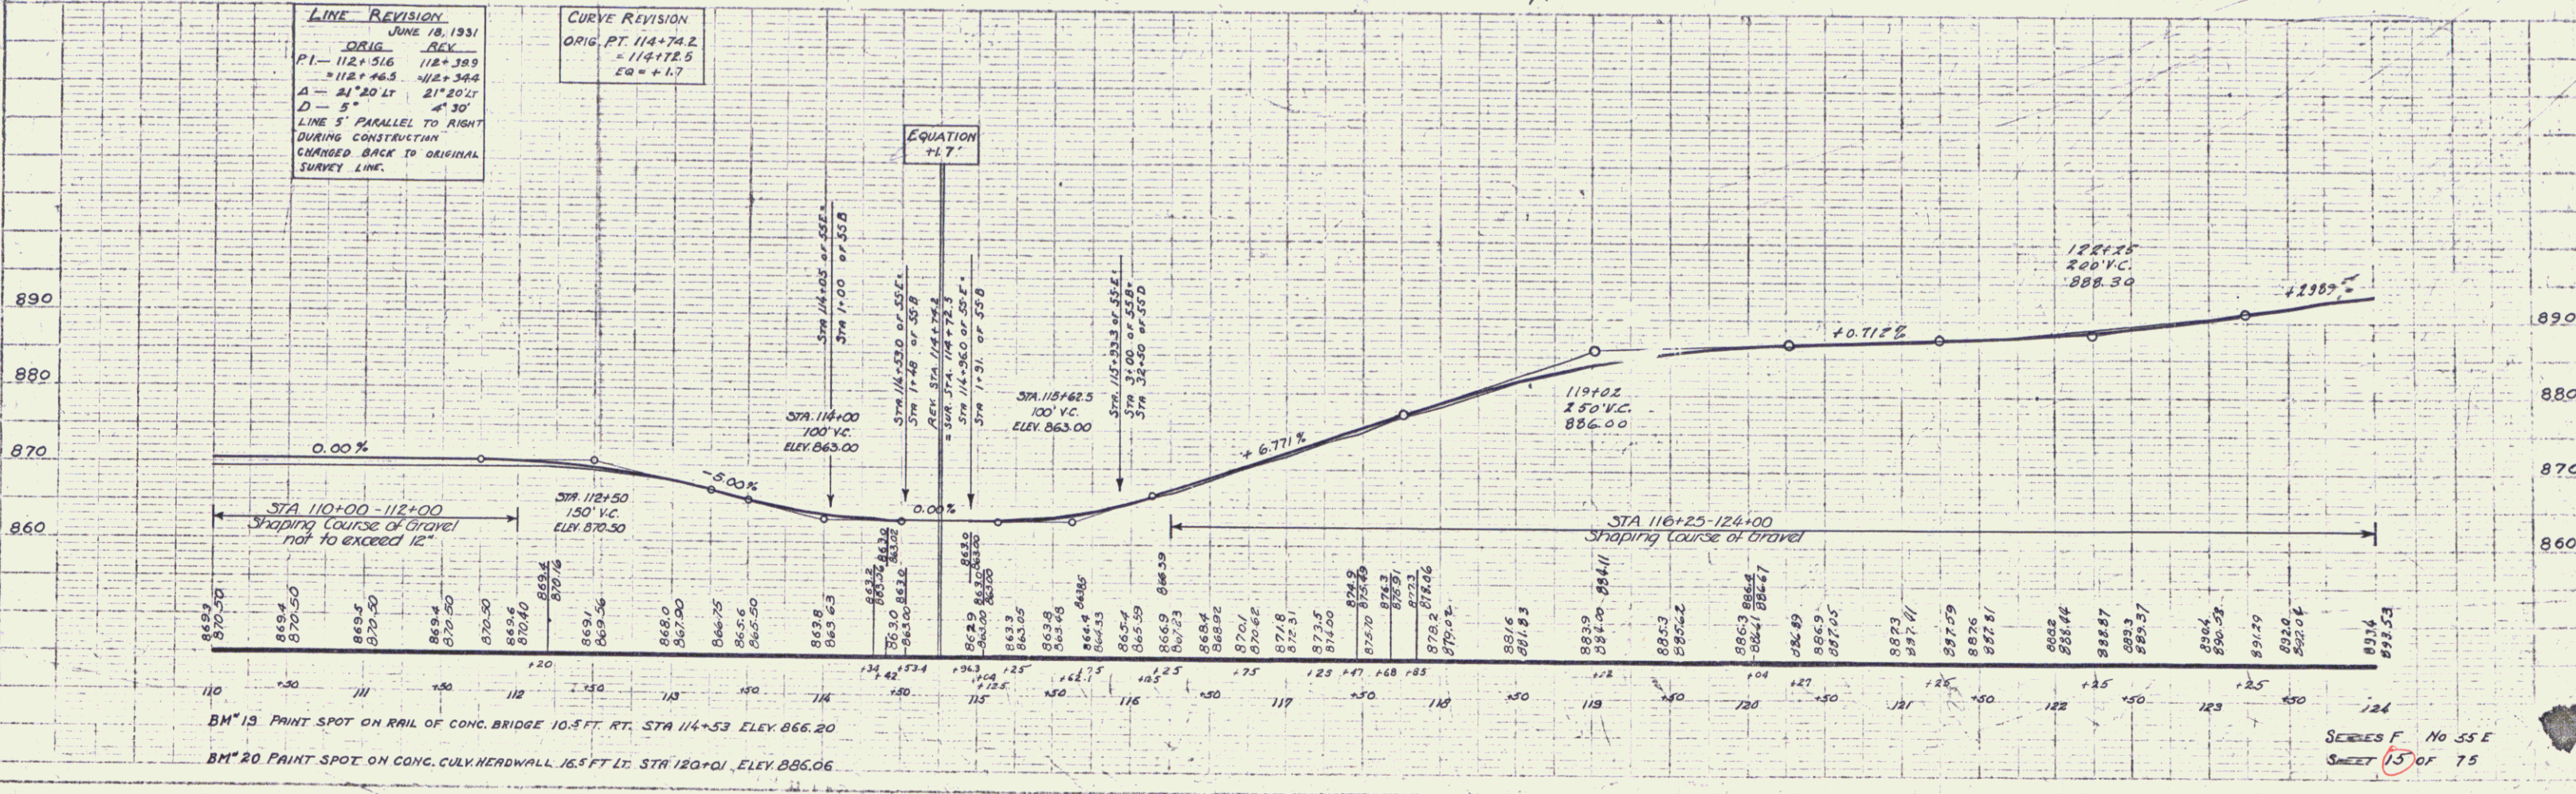

SHEET 15 OF 75