


POST WAR FA PRIMARY

PLAN
 DATE: 3/24
 CHECKED: [Signature]
 NO. []

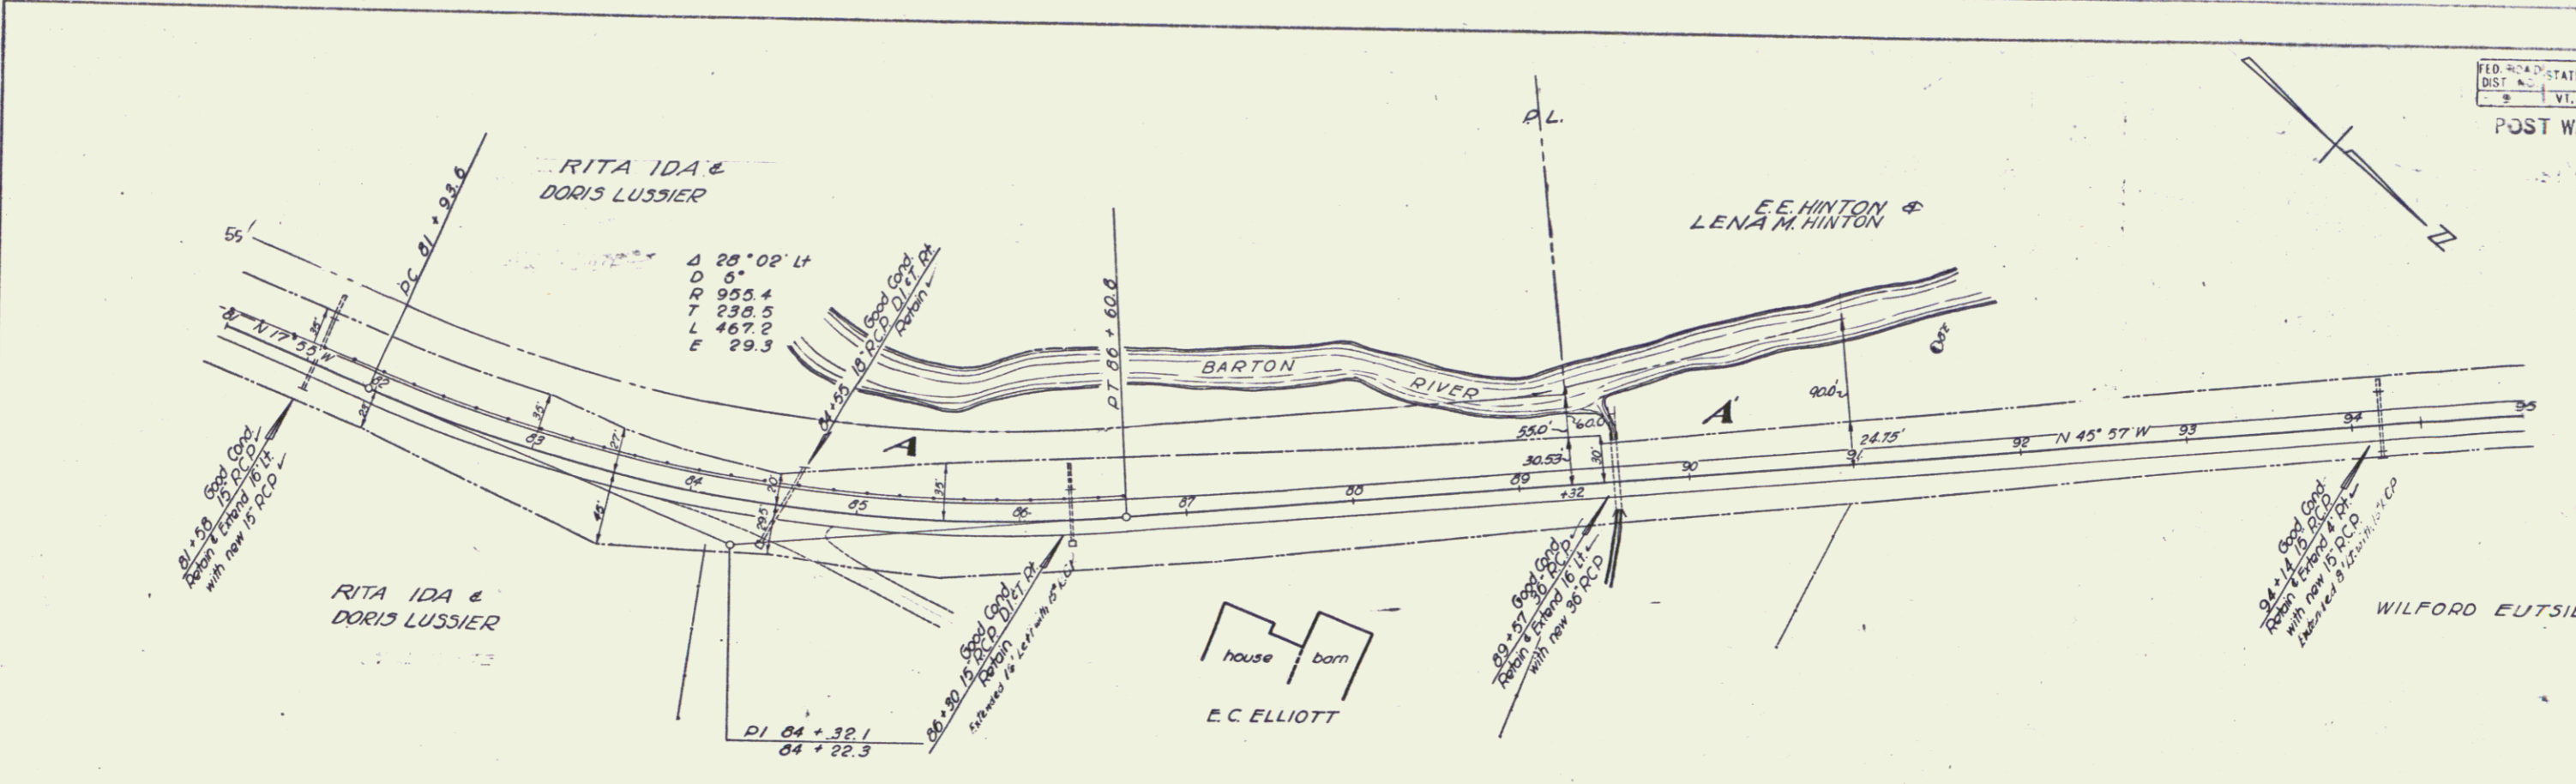

PROFILE
 DATE: []
 CHECKED: []
 NO. []

