

PLANNING	STATE	F	FISCAL YEAR	20	SHEET NO.	27	TOTAL SHEETS	12
VI.	35(12)							

PLAN	REVISED	DATE
NOTE BOOK	ALIGNED	
NO.	OF WAY CHECKED	
		CHG.

PROFILE	REVISED	DATE
NOTE BOOK	GRADES CHECKED	
NO.	STRUCTURE NOTED BY CIVIL	

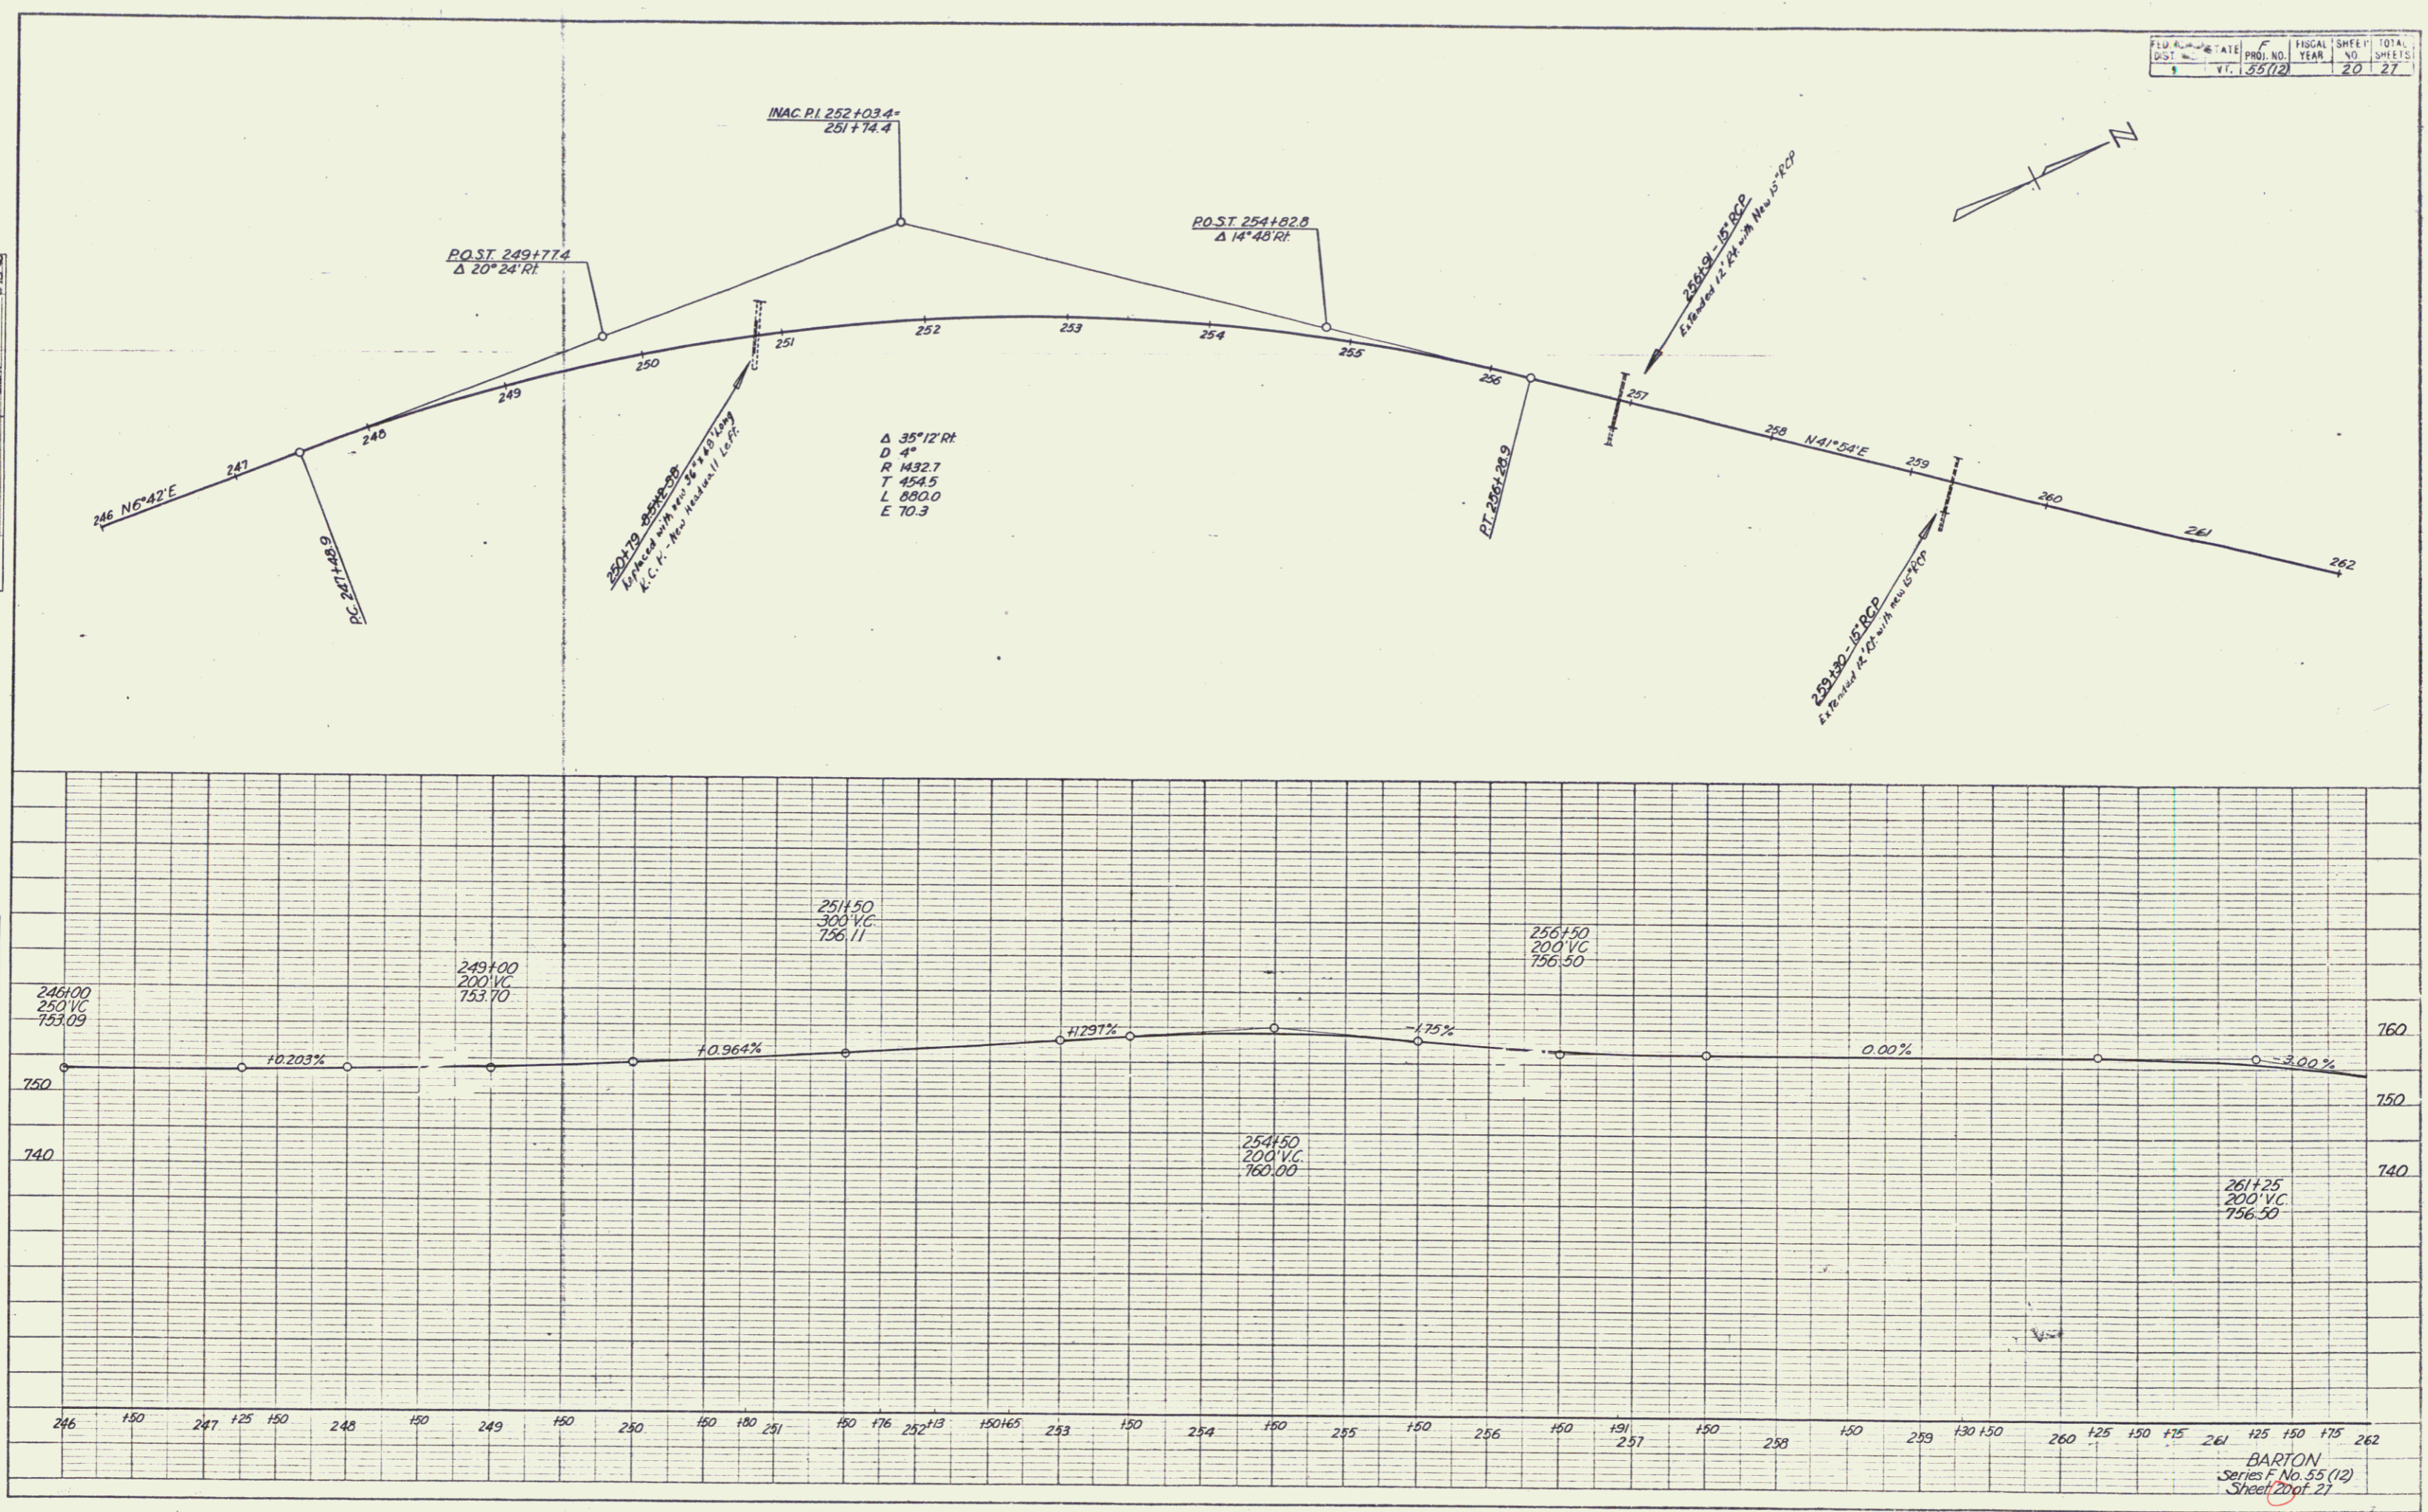


PLATE 1 - PLAN PROFILE D.P. & R.E. STANDARD
 KELP & ESSER CO., NEW YORK
 N. E. & CO. INC. 348-11 C
 NEW YORK, N. Y.

BARTON
 Series F No. 55 (12)
 Sheet 20 of 27