

FED. ROAD DIST. NO.	STATE	PROJECT NO.	YEAR	FISCAL SHEET NO.	TOTAL SHEETS
9	VT.	55160		22	27

PLAN	DATE
REVISED	
NOTED	
NO. 1	
NO. 2	
NO. 3	
NO. 100	

PROFILE	DATE
REVISED	
NOTED	
NO. 1	
NO. 2	
NO. 3	
NO. 100	

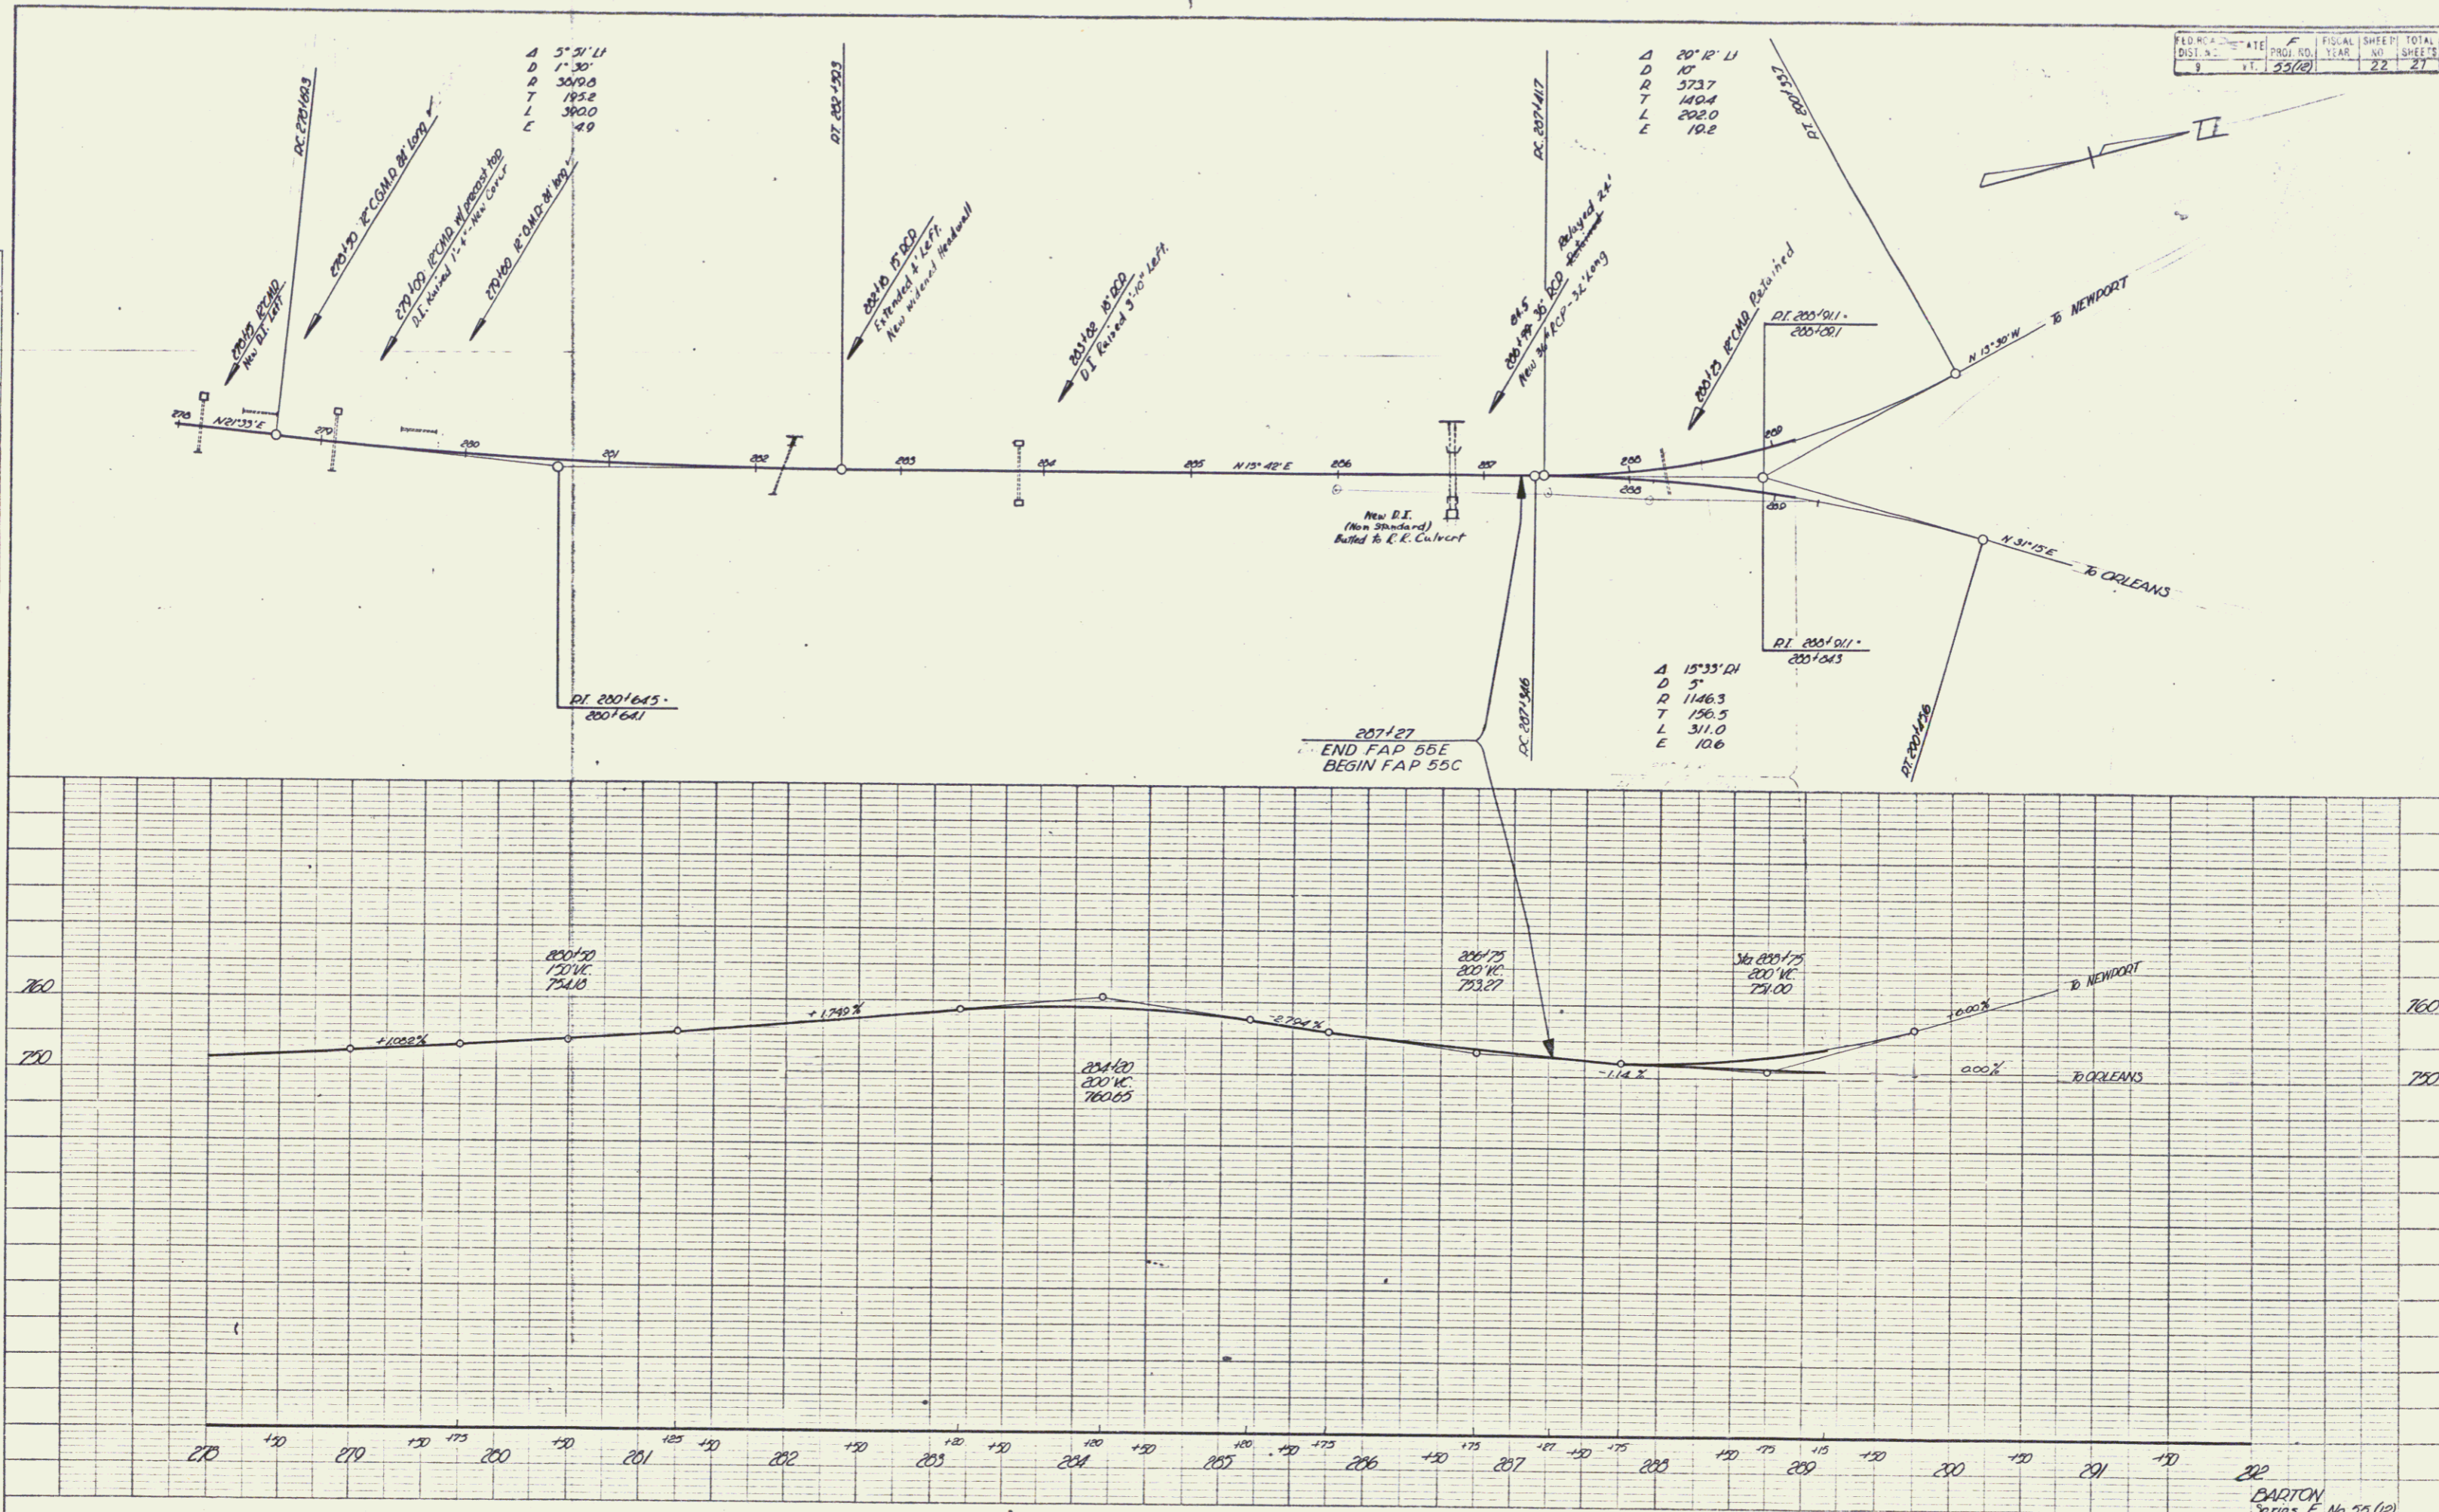


PLATE 1 - PLAN-PROFILE OF P. & A. L. STATION
 REUFEL & EISEN CO. NEW YORK

N. E. CO. NO. 34810
 GENERAL ENGINEERS

BARTON
 Series E No. 75 (12)
 Sheet 22 of 27 Sheets

20