
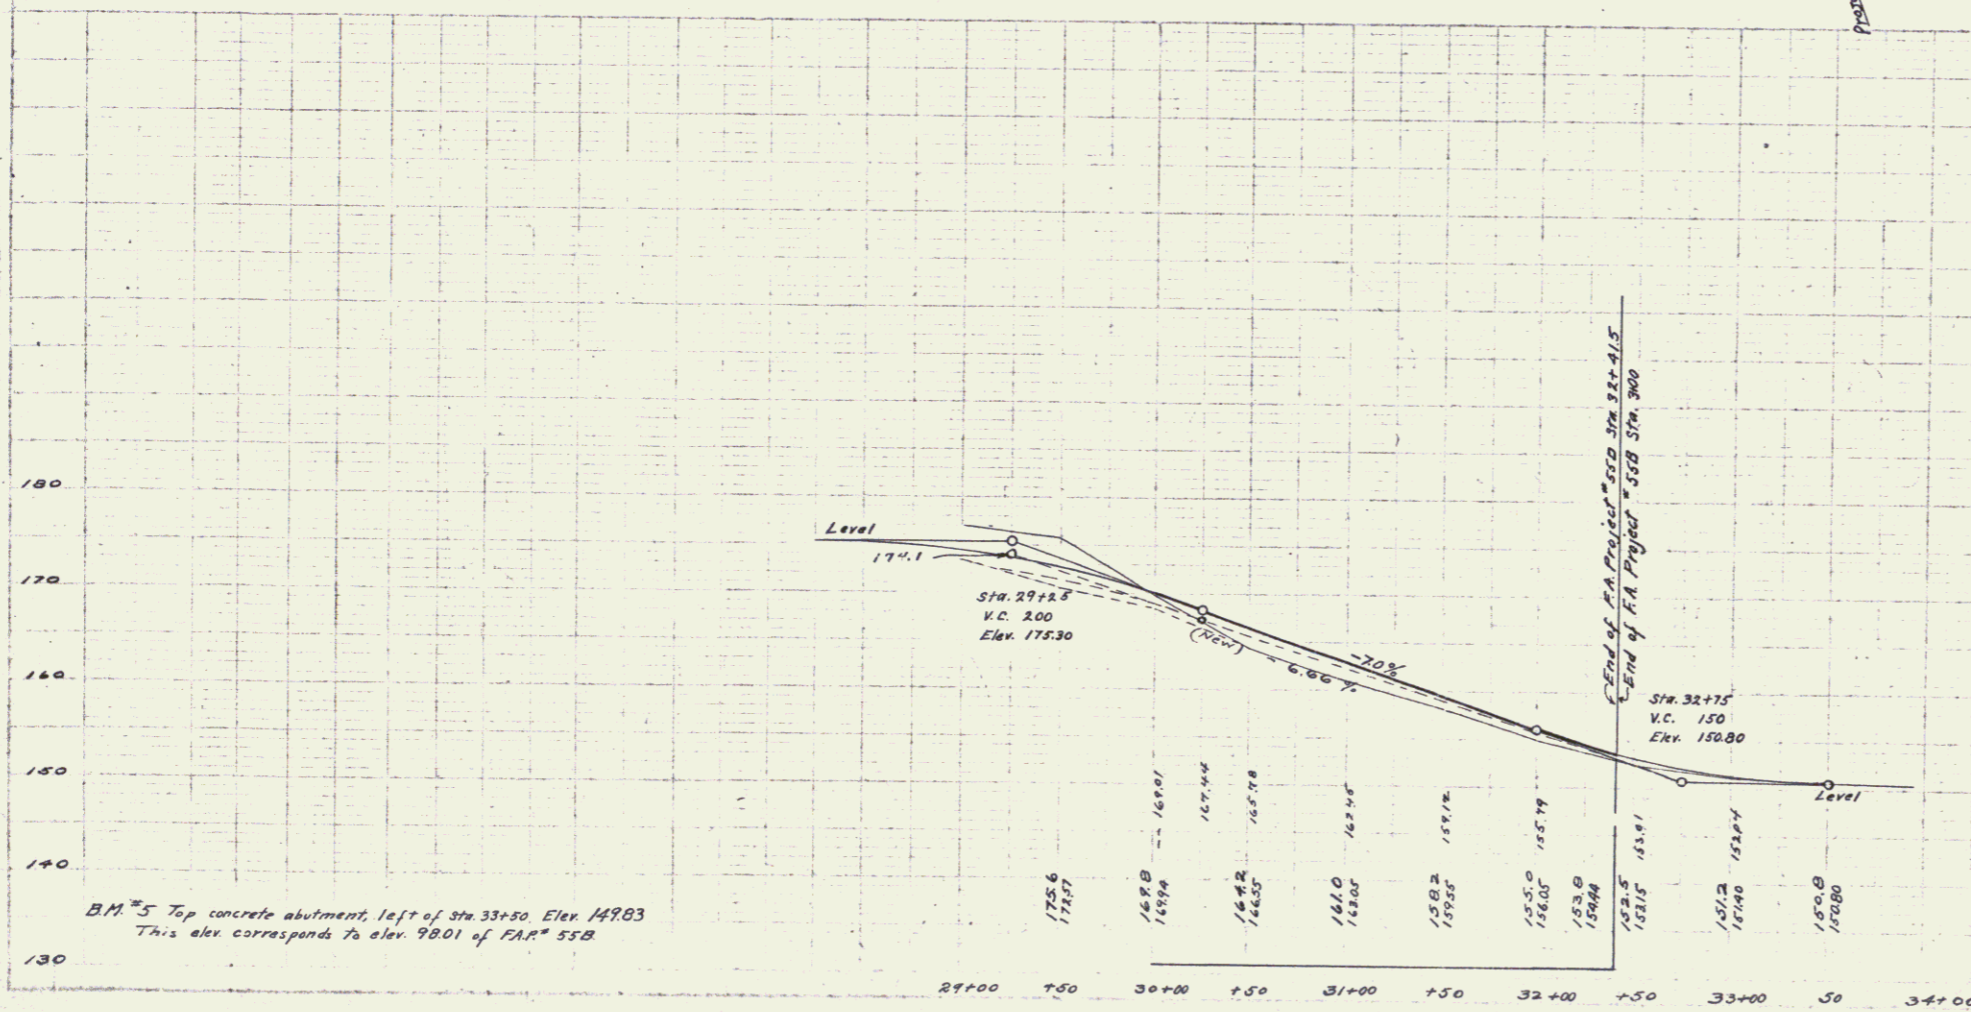


CABLE GUARD RAIL REQUIRED
 ON LEFT
 SEA 30+00 to SEA 32+40 Length 240ft

9 YR 550 1926 5 22

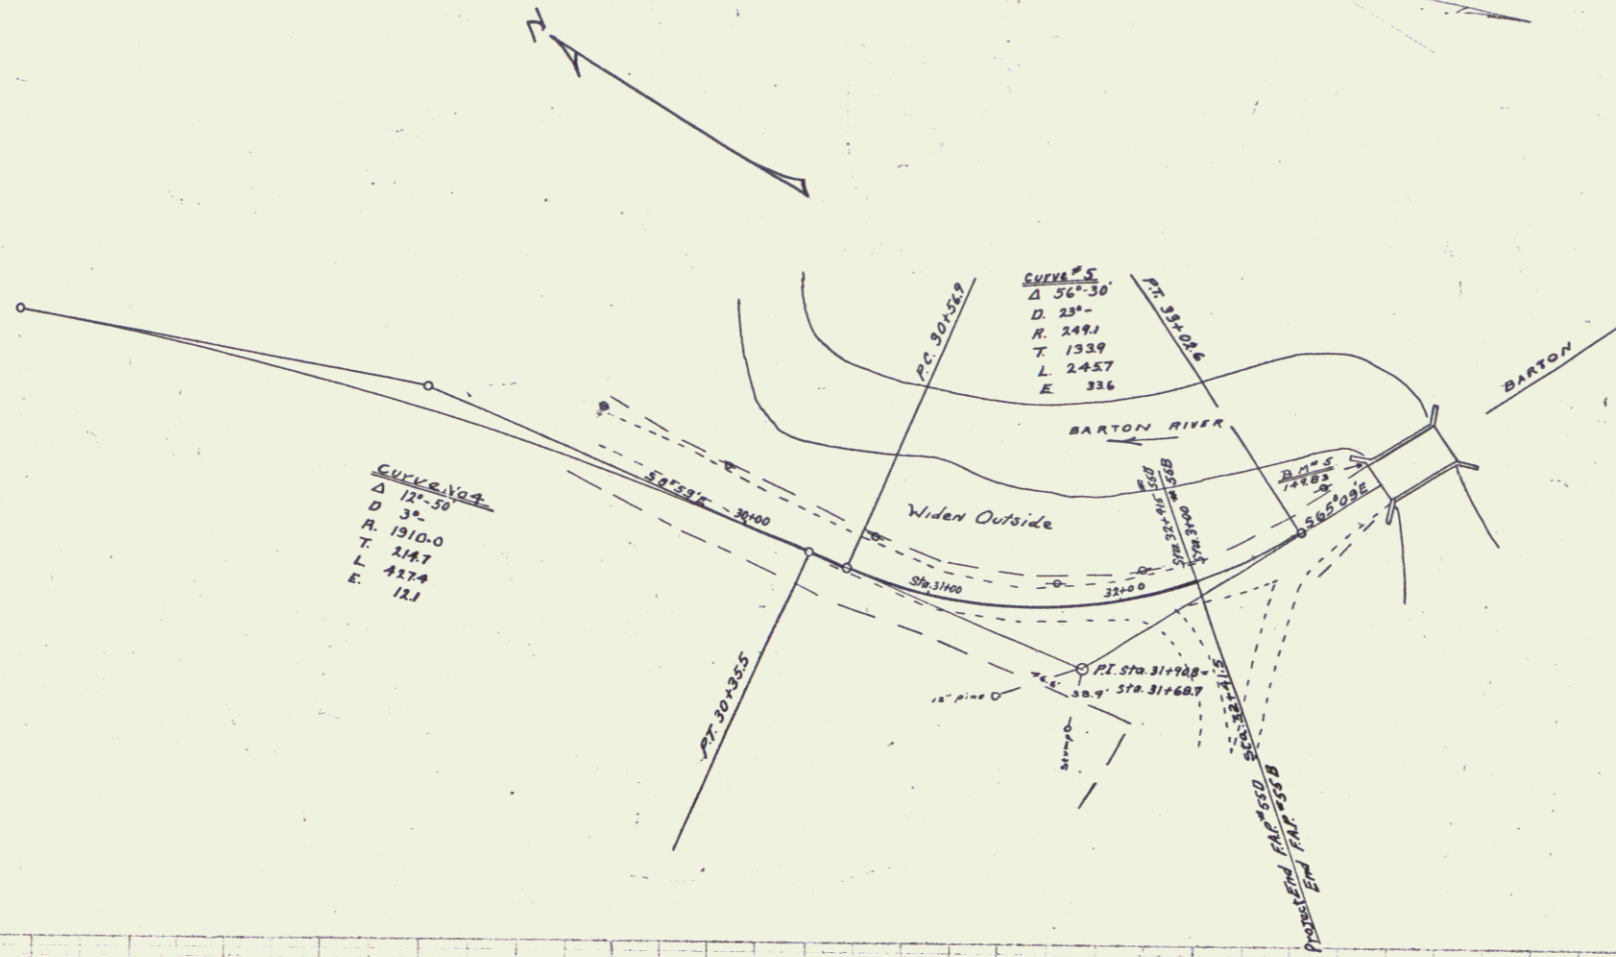

7