



FED. ROAD DIST. NO.	DATE	FED. AID PROJ. NO.	FISCAL YEAR	SHEET NO.	TOTAL SHEETS
9	19	1937	4	50	

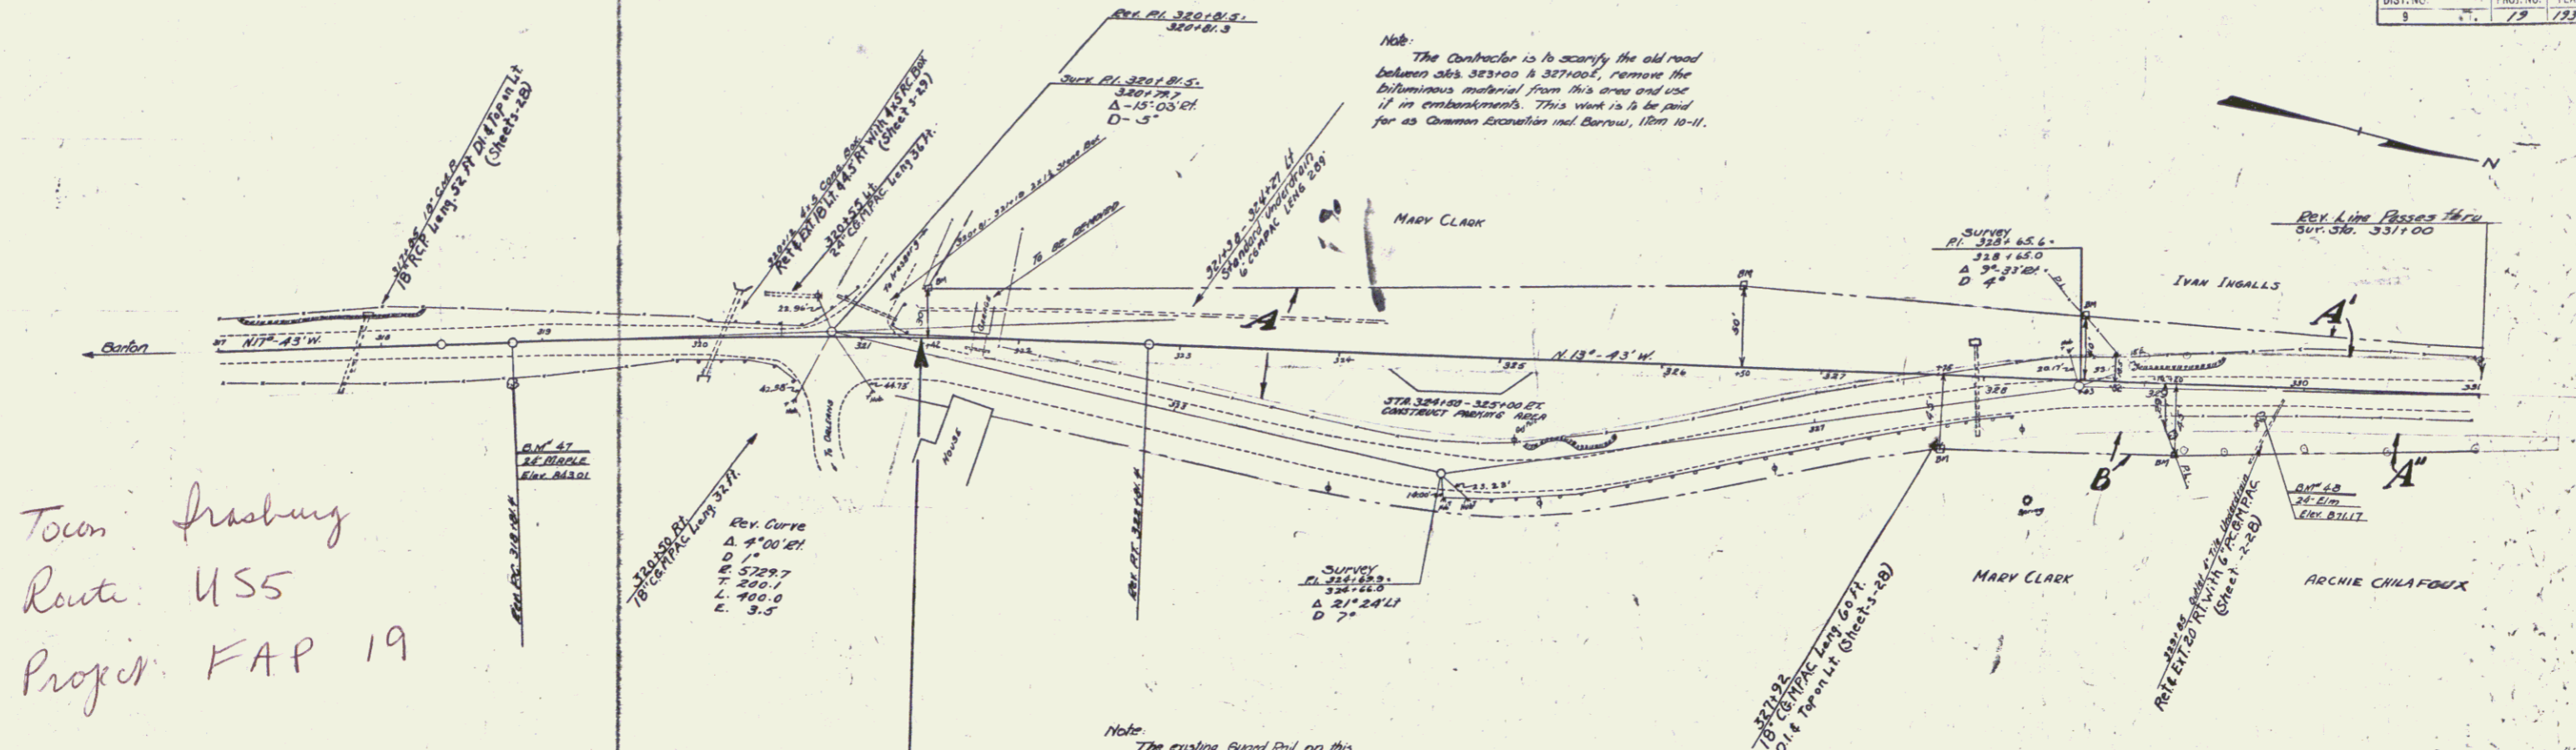

Town of Frasing
Route US5
Project FAP 19

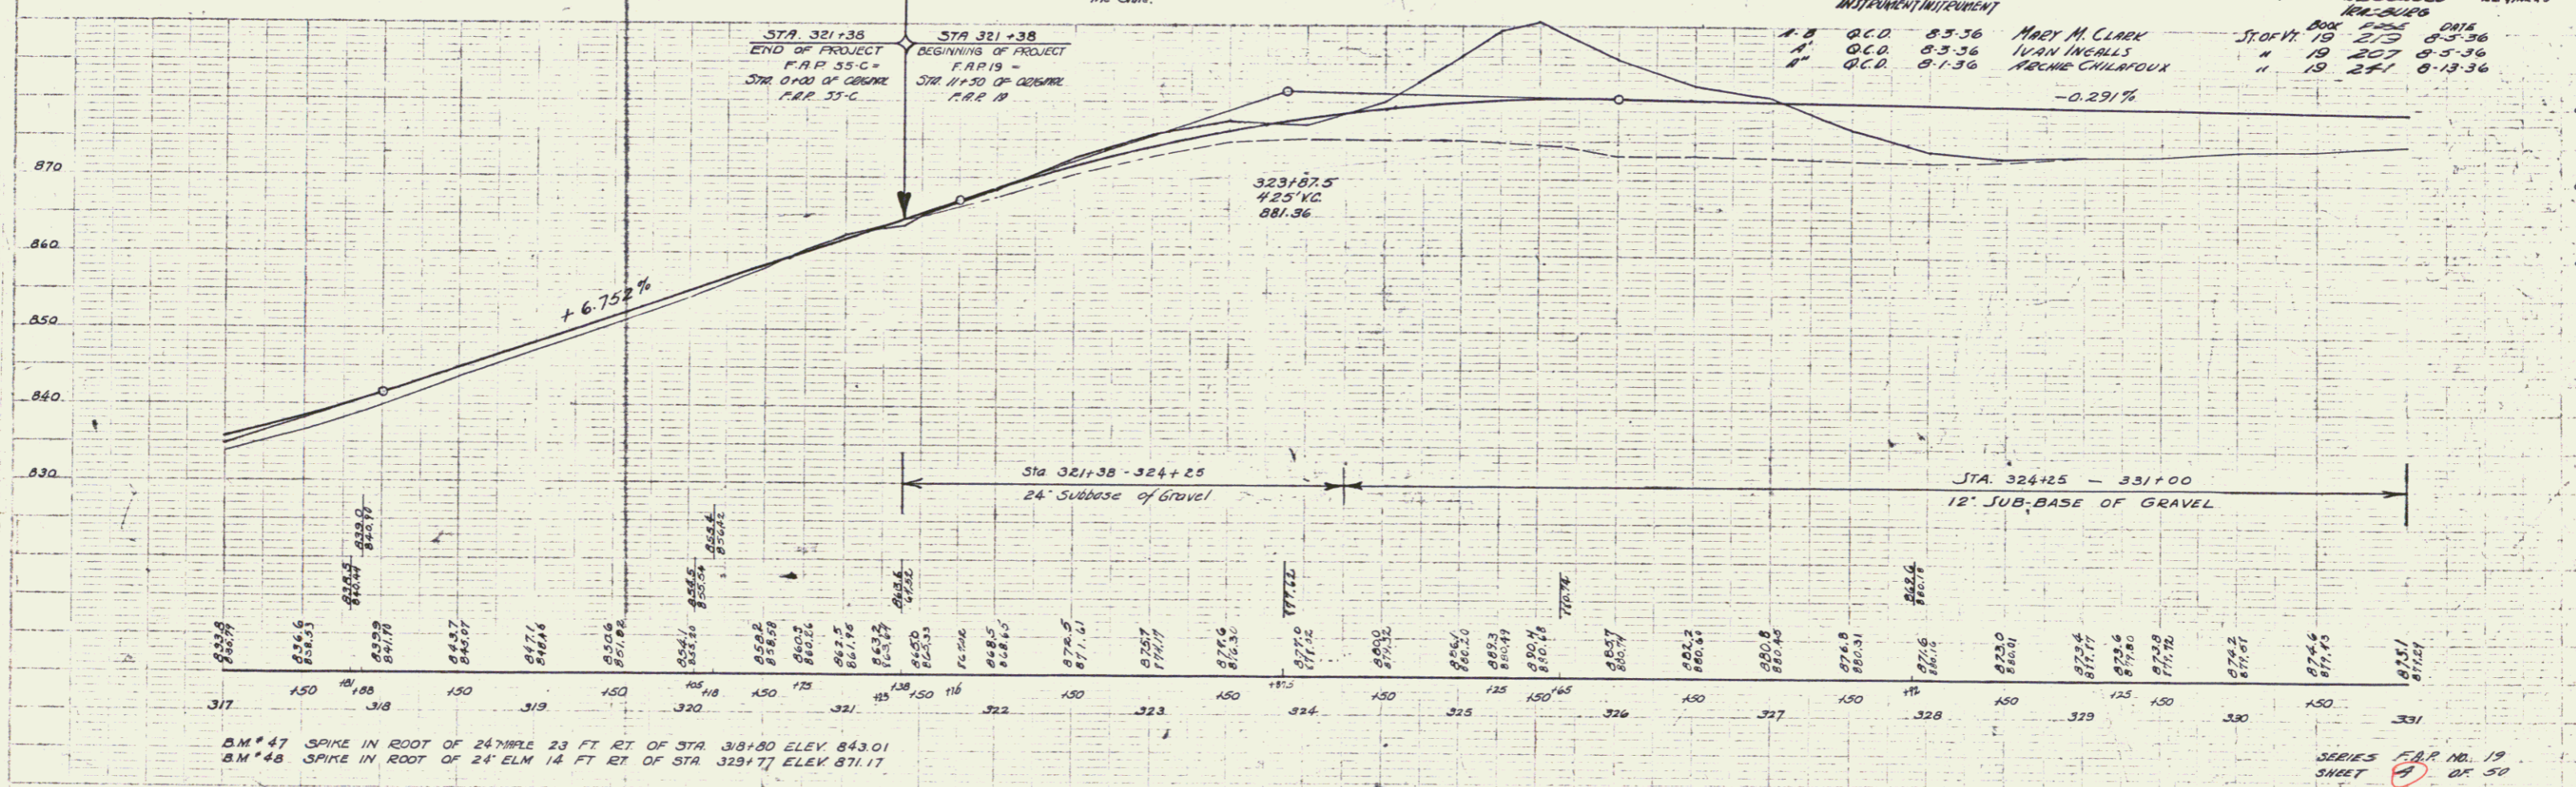

DAREL	KIND OF DATE OF INSTRUMENT/INTERVIEW	GRANTOR	GRANTEE	RECORDED	REMARKS
A	Q.C.D.	MARY M. CLARK	ST. OF Vt.	19 213	8-5-36
A	Q.C.D.	IVAN INGALLS	"	19 207	8-5-36
A	Q.C.D.	ARCHIE CHILAFUOX	"	19 271	8-13-36

B.M. #47 SPIKE IN ROOT OF 24" APPLE 23 FT RT OF STA 318+80 ELEV 843.01
B.M. #48 SPIKE IN ROOT OF 24" ELM 14 FT RT OF STA 329+77 ELEV 871.17

SERIES F.A.P. NO. 19
SHEET 4 OF 50