



FED. ROAD DIST. NO.	STATE	FED. AID PROJ. NO.	FISCAL YEAR	SHEET NO.	TOTAL SHEETS
8	VT.	19	1932	5	59

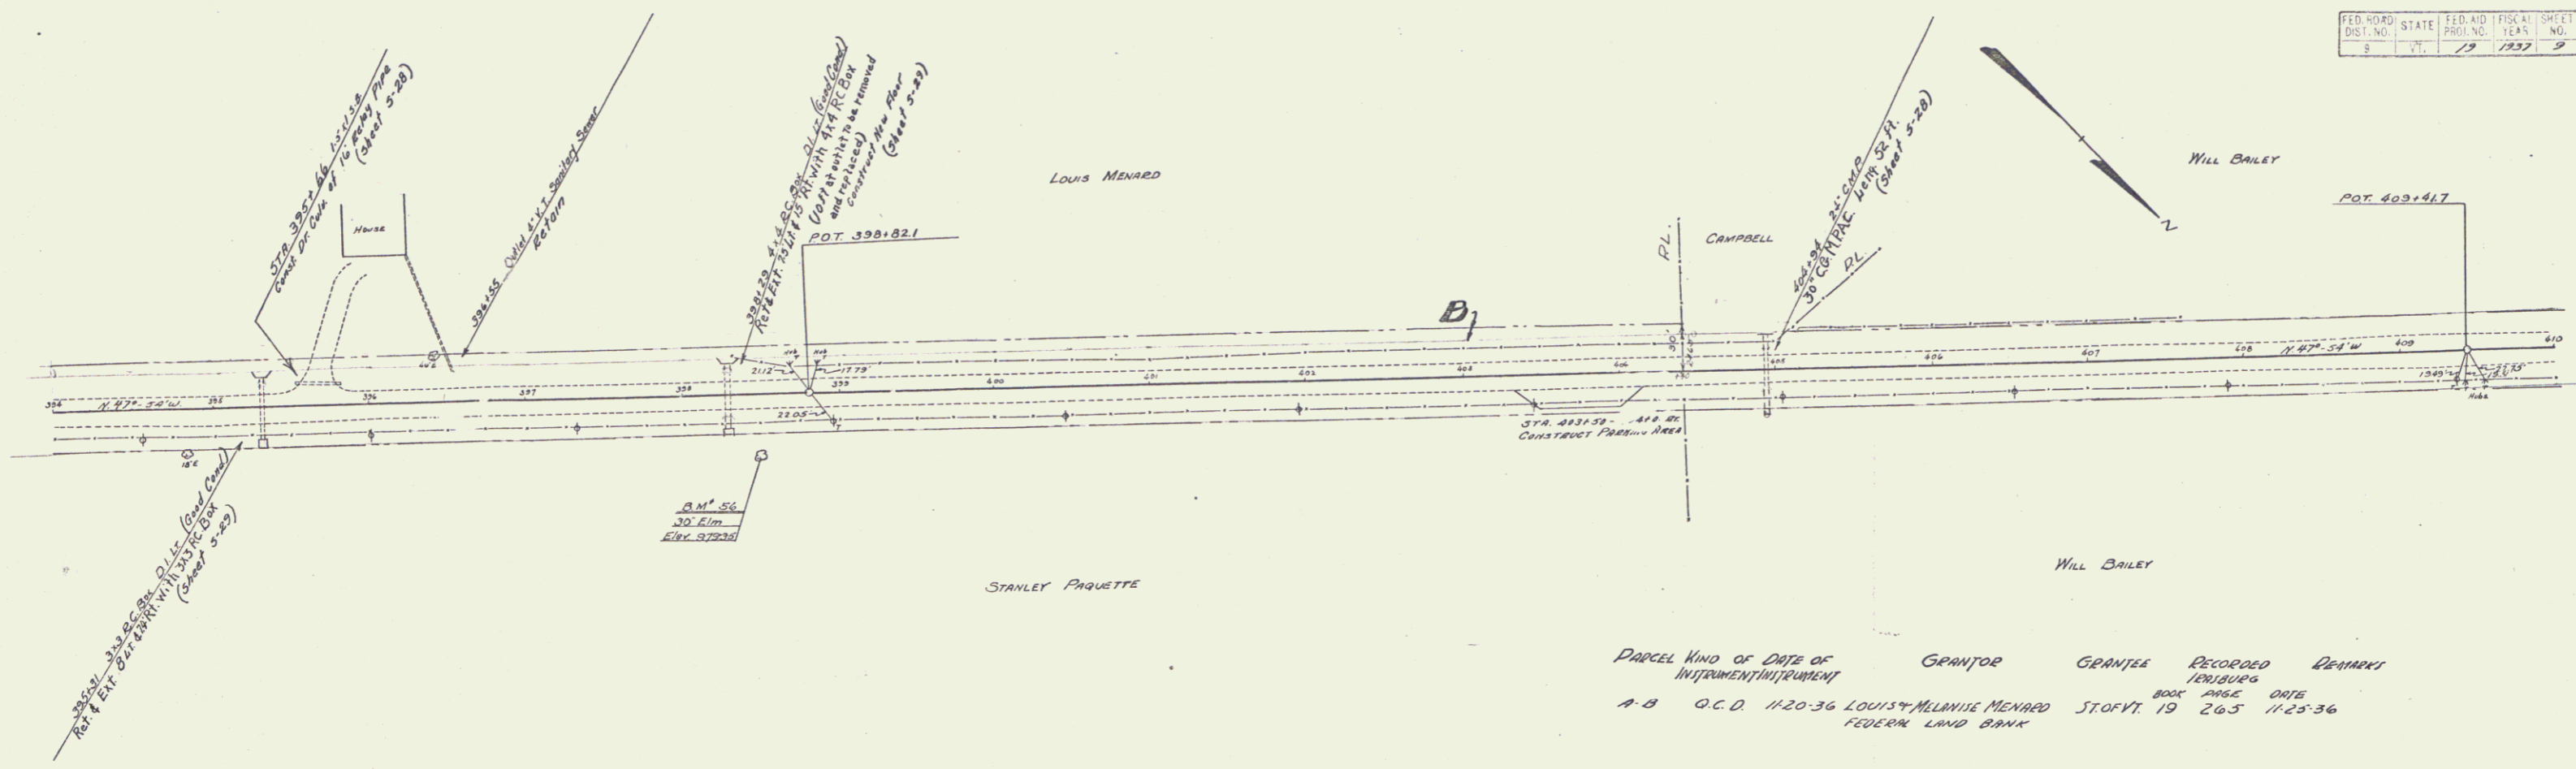

PARCEL KIND OF DATE OF GRANTEE GRANTEE RECORDED DEPART  
 INSTRUMENT INSTRUMENT  
 A-B O.C.D. 11-20-36 LOUIS & MELANIE MENARD ST. OF VT. 19 265 11-25-36  
 FEDERAL LAND BANK

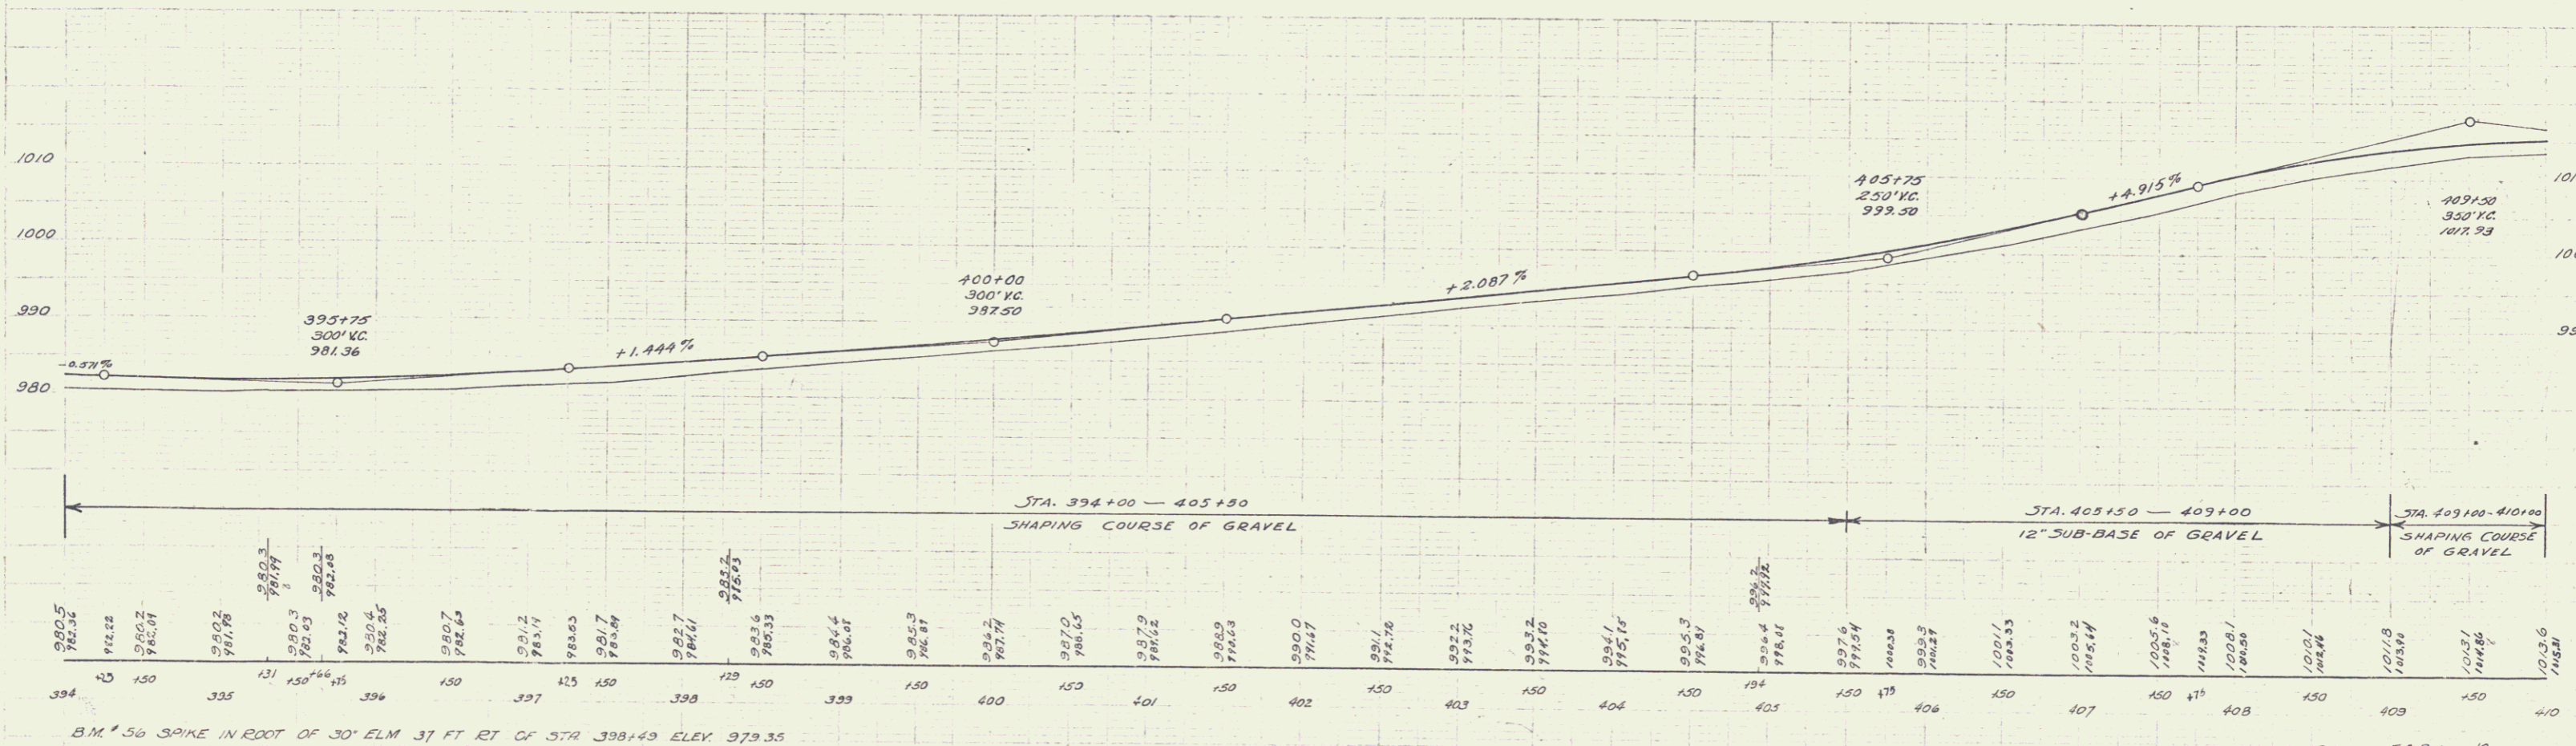

Station	Elevation	Station	Elevation	Station	Elevation
394	980.5	397	983.1	400	987.7
395	981.2	398	984.6	401	987.9
396	981.7	399	985.1	402	988.0
397	985.1	400	987.5	403	988.2
398	986.3	401	987.9	404	988.1
399	986.9	402	988.0	405	988.4
400	987.5	403	988.2	406	988.8
401	987.9	404	988.1	407	989.2
402	988.0	405	988.4	408	989.5
403	988.2	406	988.8	409	989.8
404	988.1	407	989.2	410	990.1
405	988.4	408	989.5		
406	988.8	409	989.8		
407	989.2				
408	989.5				
409	989.8				
410	990.1				

B.M. # 56 SPIKE IN ROOT OF 30' ELM 37 FT RT OF STA 398+49 ELEV 979.35

SERIES E.A.P. NO. 19  
 SHEET 5 OF 59

7