


CURVE # 8  
 $\Delta = 92.27^\circ$  LT  
 $D = 7$   
 $TP = 572.7$   
 $T = 172.5$   
 $L = 345.5$   
 $E = 2.6$

CURVE # 7  
 $\Delta = 0^\circ 51' 11''$  RT  
 $D = 0.151$   
 $R = 231.83$   
 $T = 176.8$   
 $L = 340.0$   
 $E = 0.8$

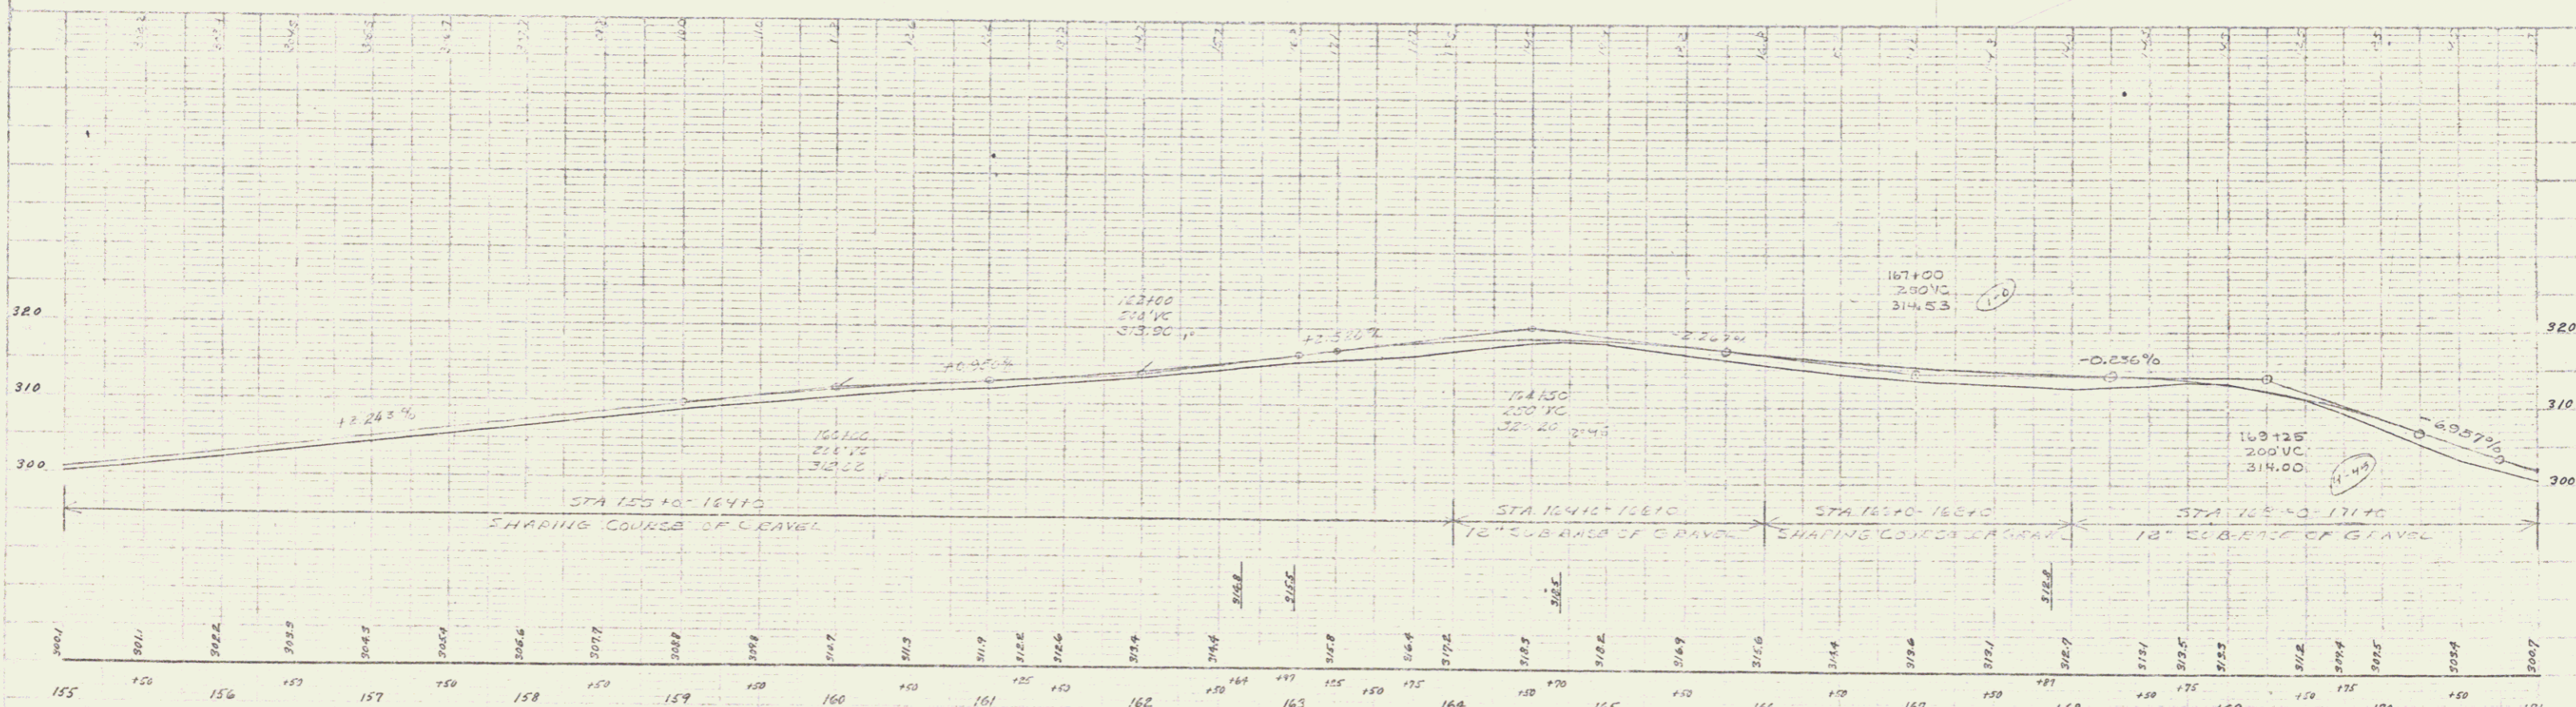

BM #17 SPIKE IN ROOT OF 26" ELM 15' HT. STA 155.72 EL. 302.37  
 BM #18 " " " 50" MAPLE 28' LT. STA 162.67 EL. 316.58  
 BM #19 " " " 14" ELM 26' LT. STA 170.70 EL. 303.20

SERIES NO. 114  
 SHEET 5 OF SHEETS

5