
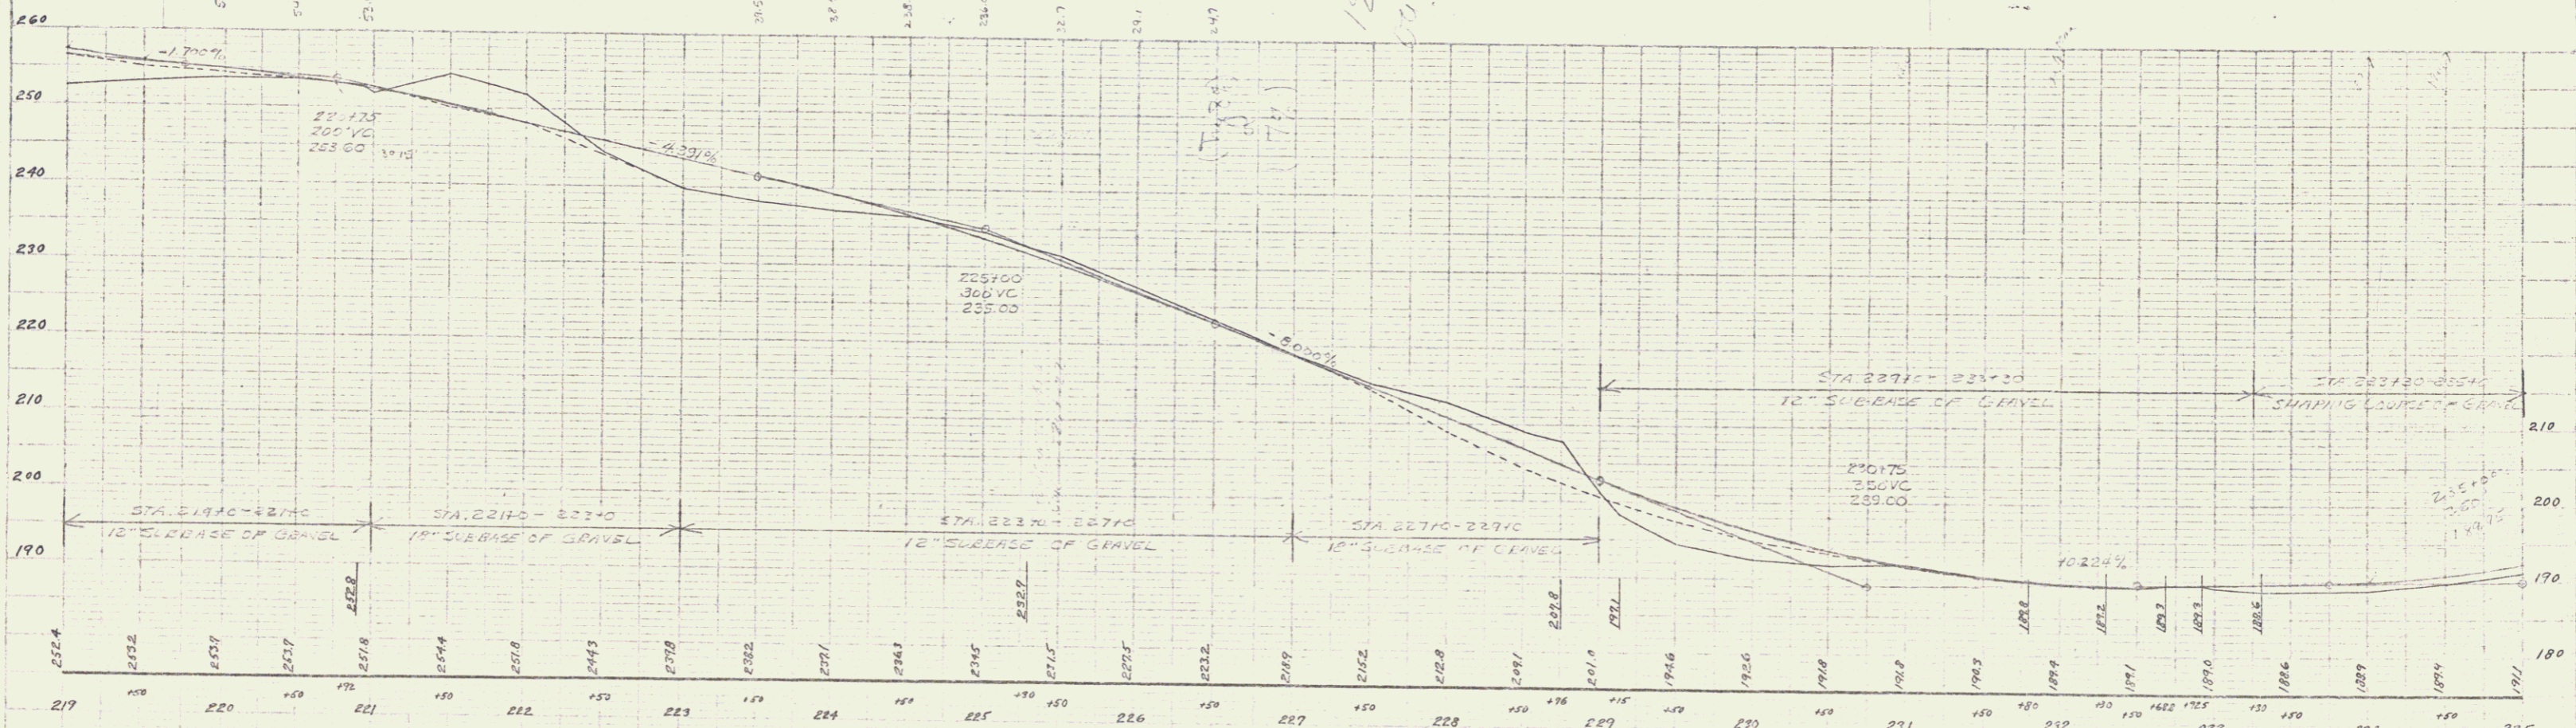


10

PLAN	1:1
SECTION	1:1
PROPOSED	1:1
EXISTING	1:1
DATE	
BY	
CHECKED	
APPROVED	

STATION	217	218	219	220	221	222	223	224	225	226	227	228	229	230	231	232	233	234	235	236
ELEVATION	190.0	191.0	192.0	193.0	194.0	195.0	196.0	197.0	198.0	199.0	200.0	201.0	202.0	203.0	204.0	205.0	206.0	207.0	208.0	209.0

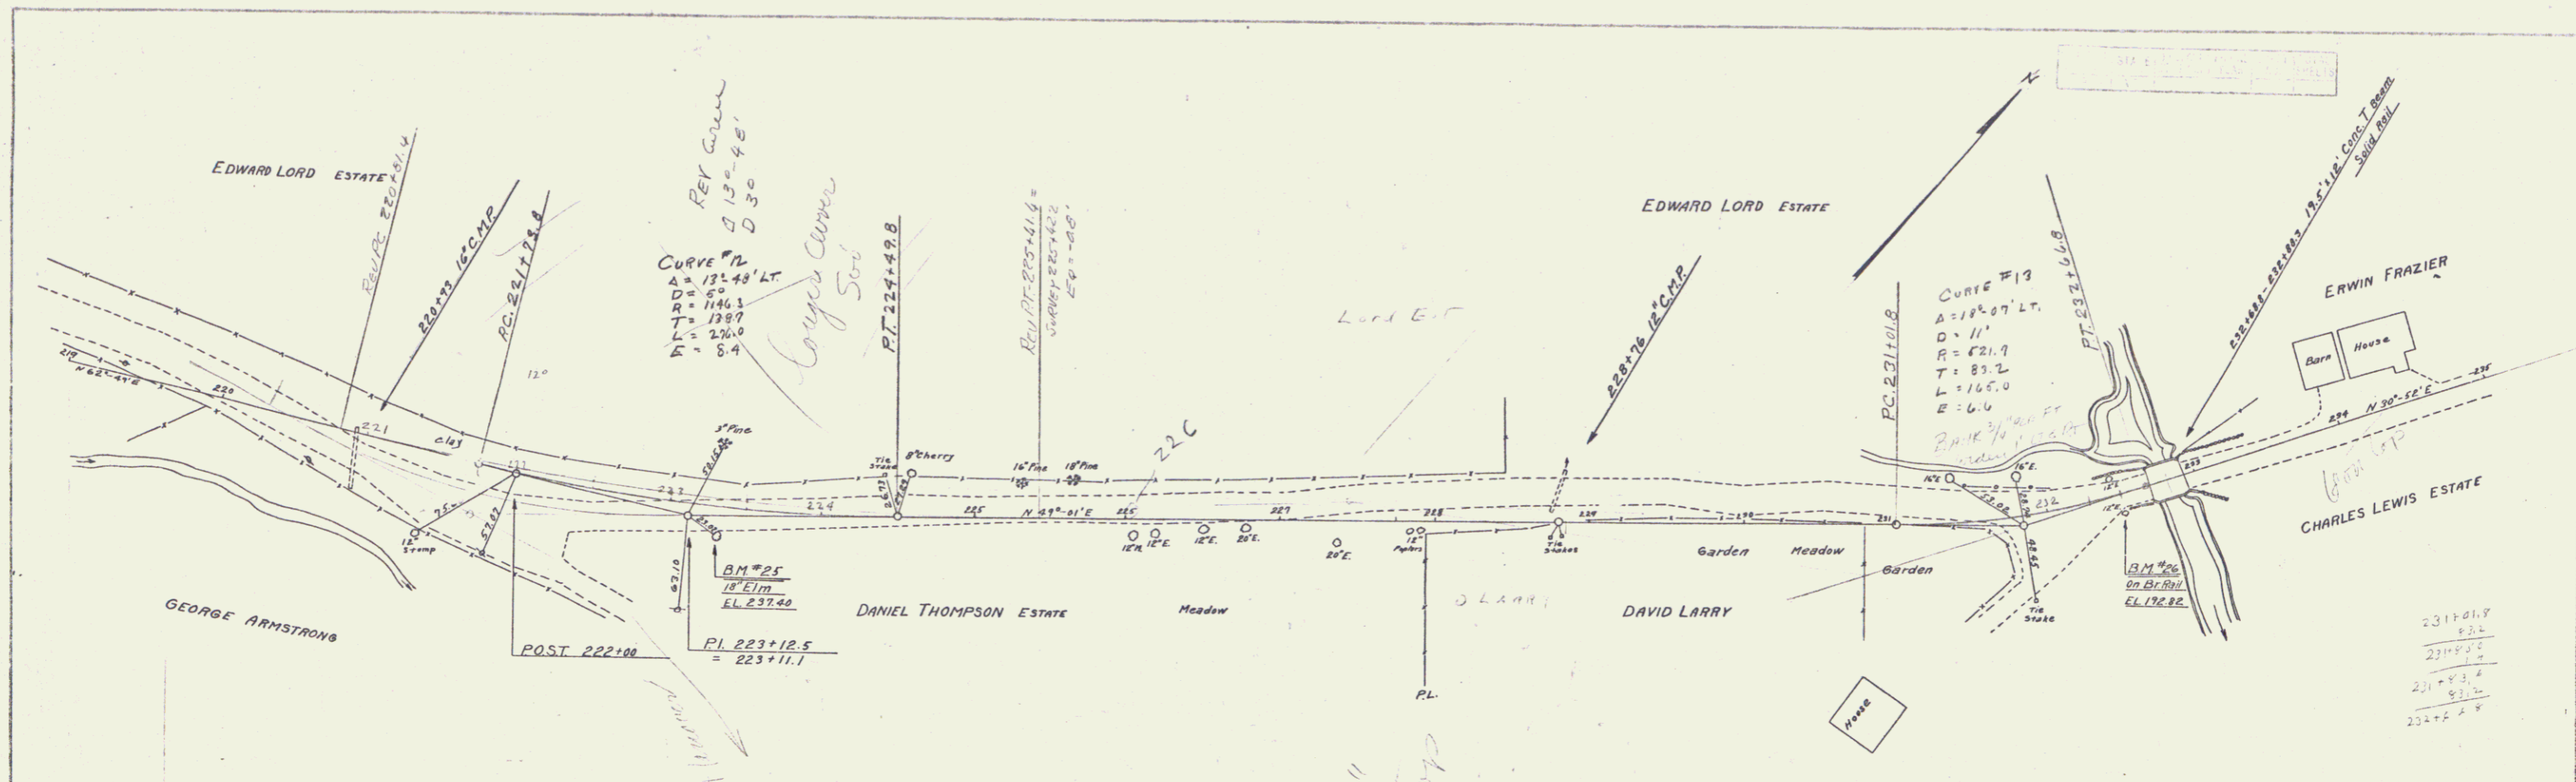

BM #25 SPIKE IN TRUNK 18" TWIN ELM 18' RT STA 223+92 EL 237.40
 BM #26 SPOT ON CONC. BRIDGE RAIL 11' RT STA 232+70 EL 192.82

SERIES NO. 114
 SHEET 9 OF SHEETS