



FED. ROAD DIST. NO.	STATE	FED. AID PROJ. NO.	FISCAL YEAR	SHEET NO.	TOTAL SHEETS
9	VT.				

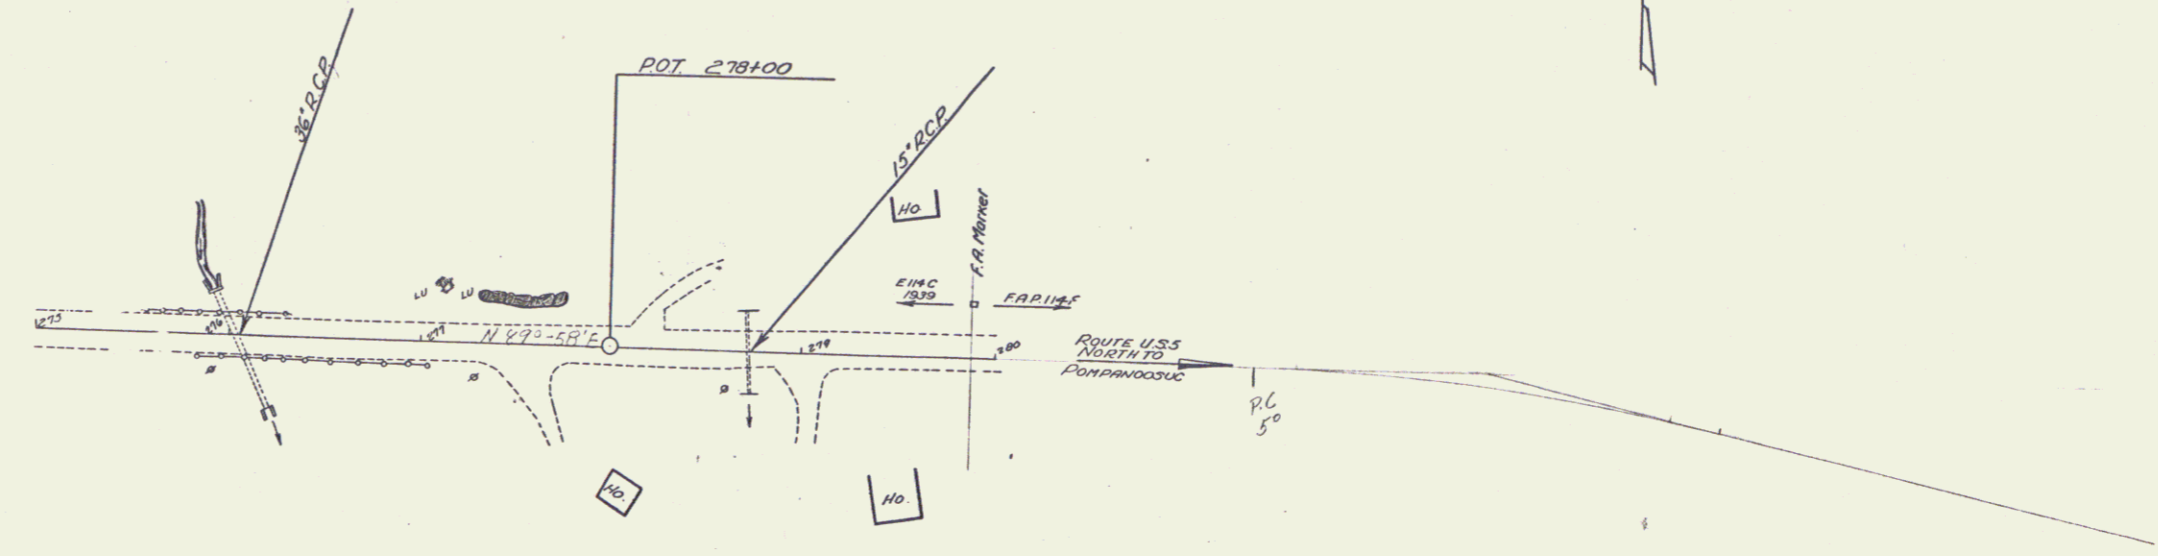

PLAN	DATE	BY	CHKD

PROJECT	NO.	DATE

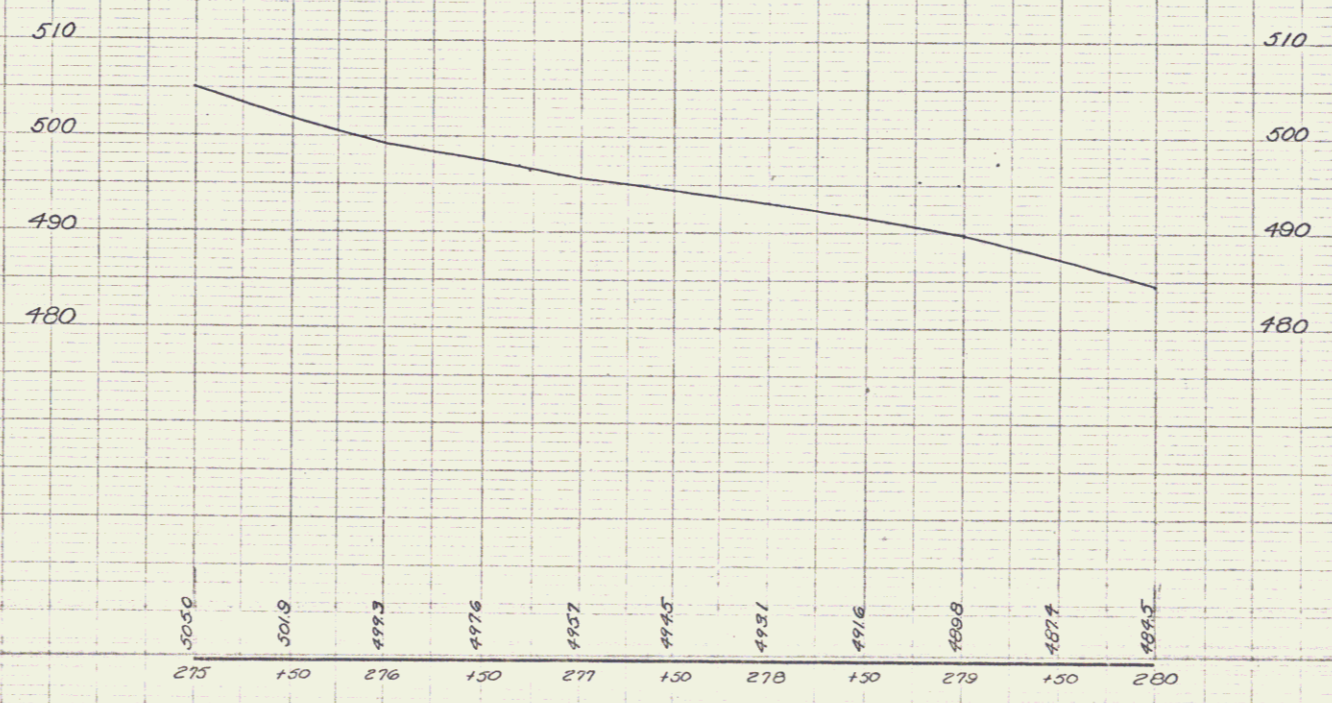

NORWICH STATE 1143

101

22