
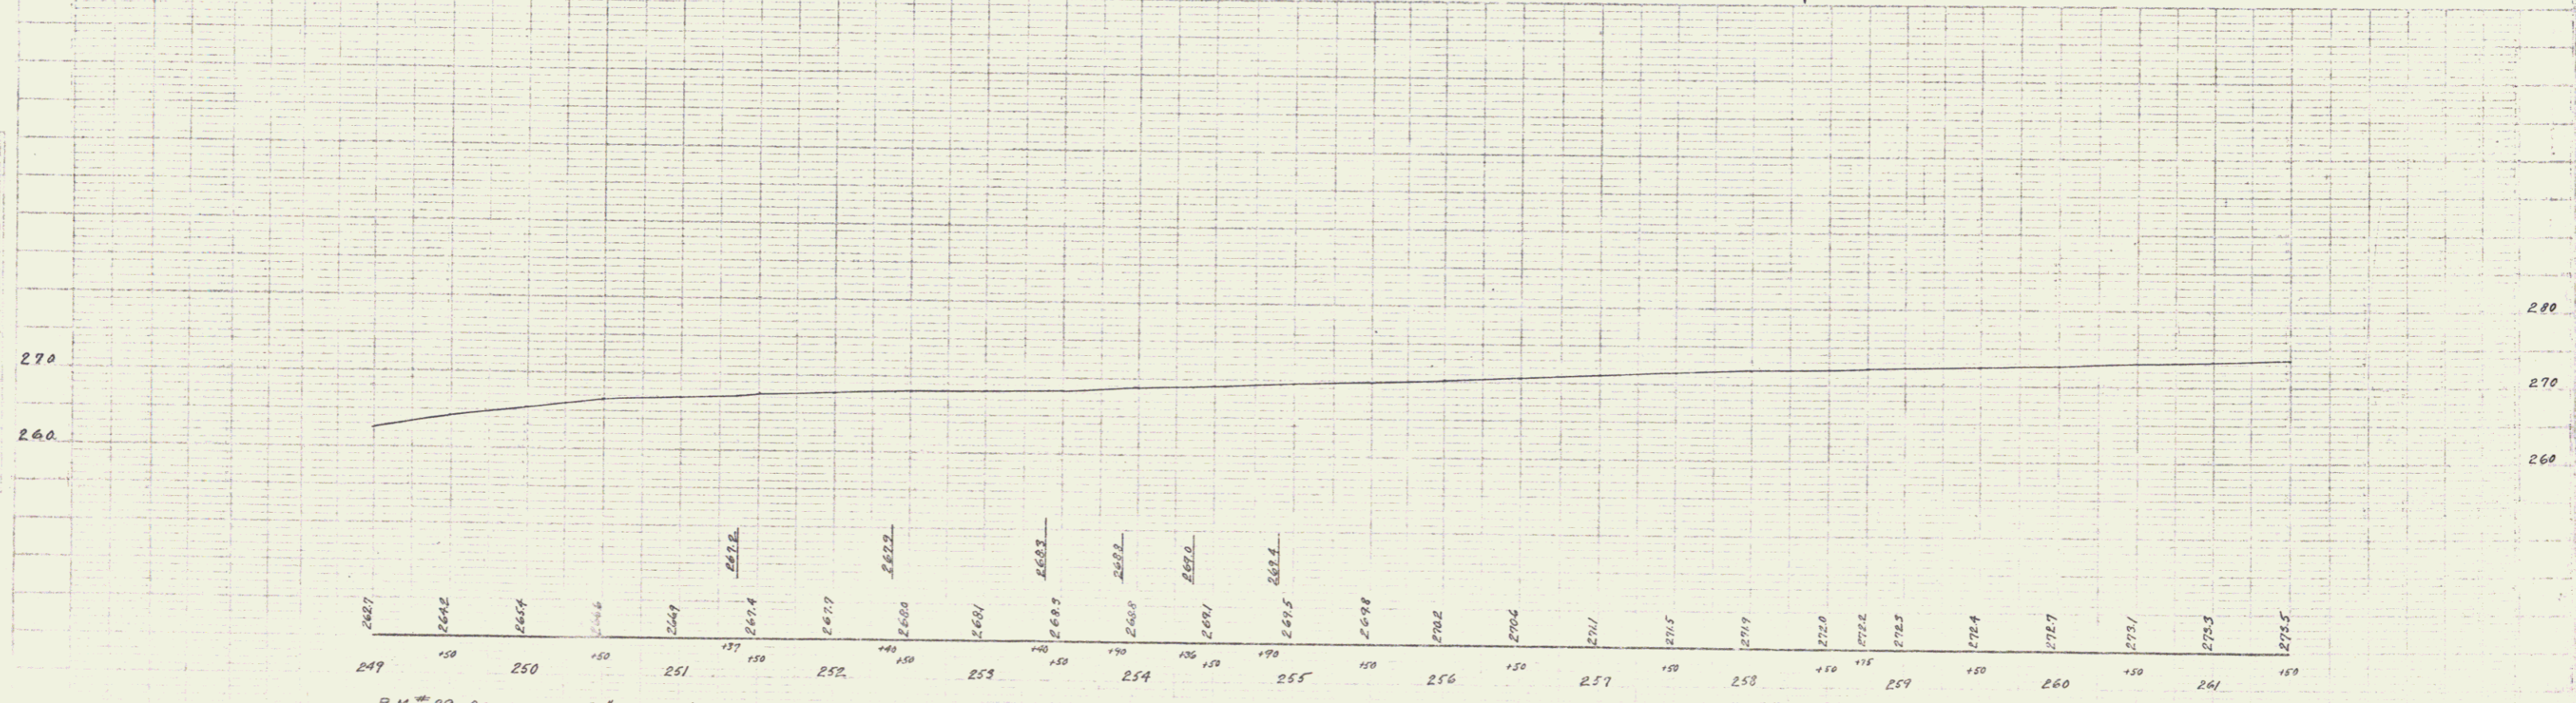


NAME
 DATE
 DRAWN BY
 CHECKED BY
 PROJECT NO.

WOOD
 ROAD
 MARKET
 MARKET
 MARKET

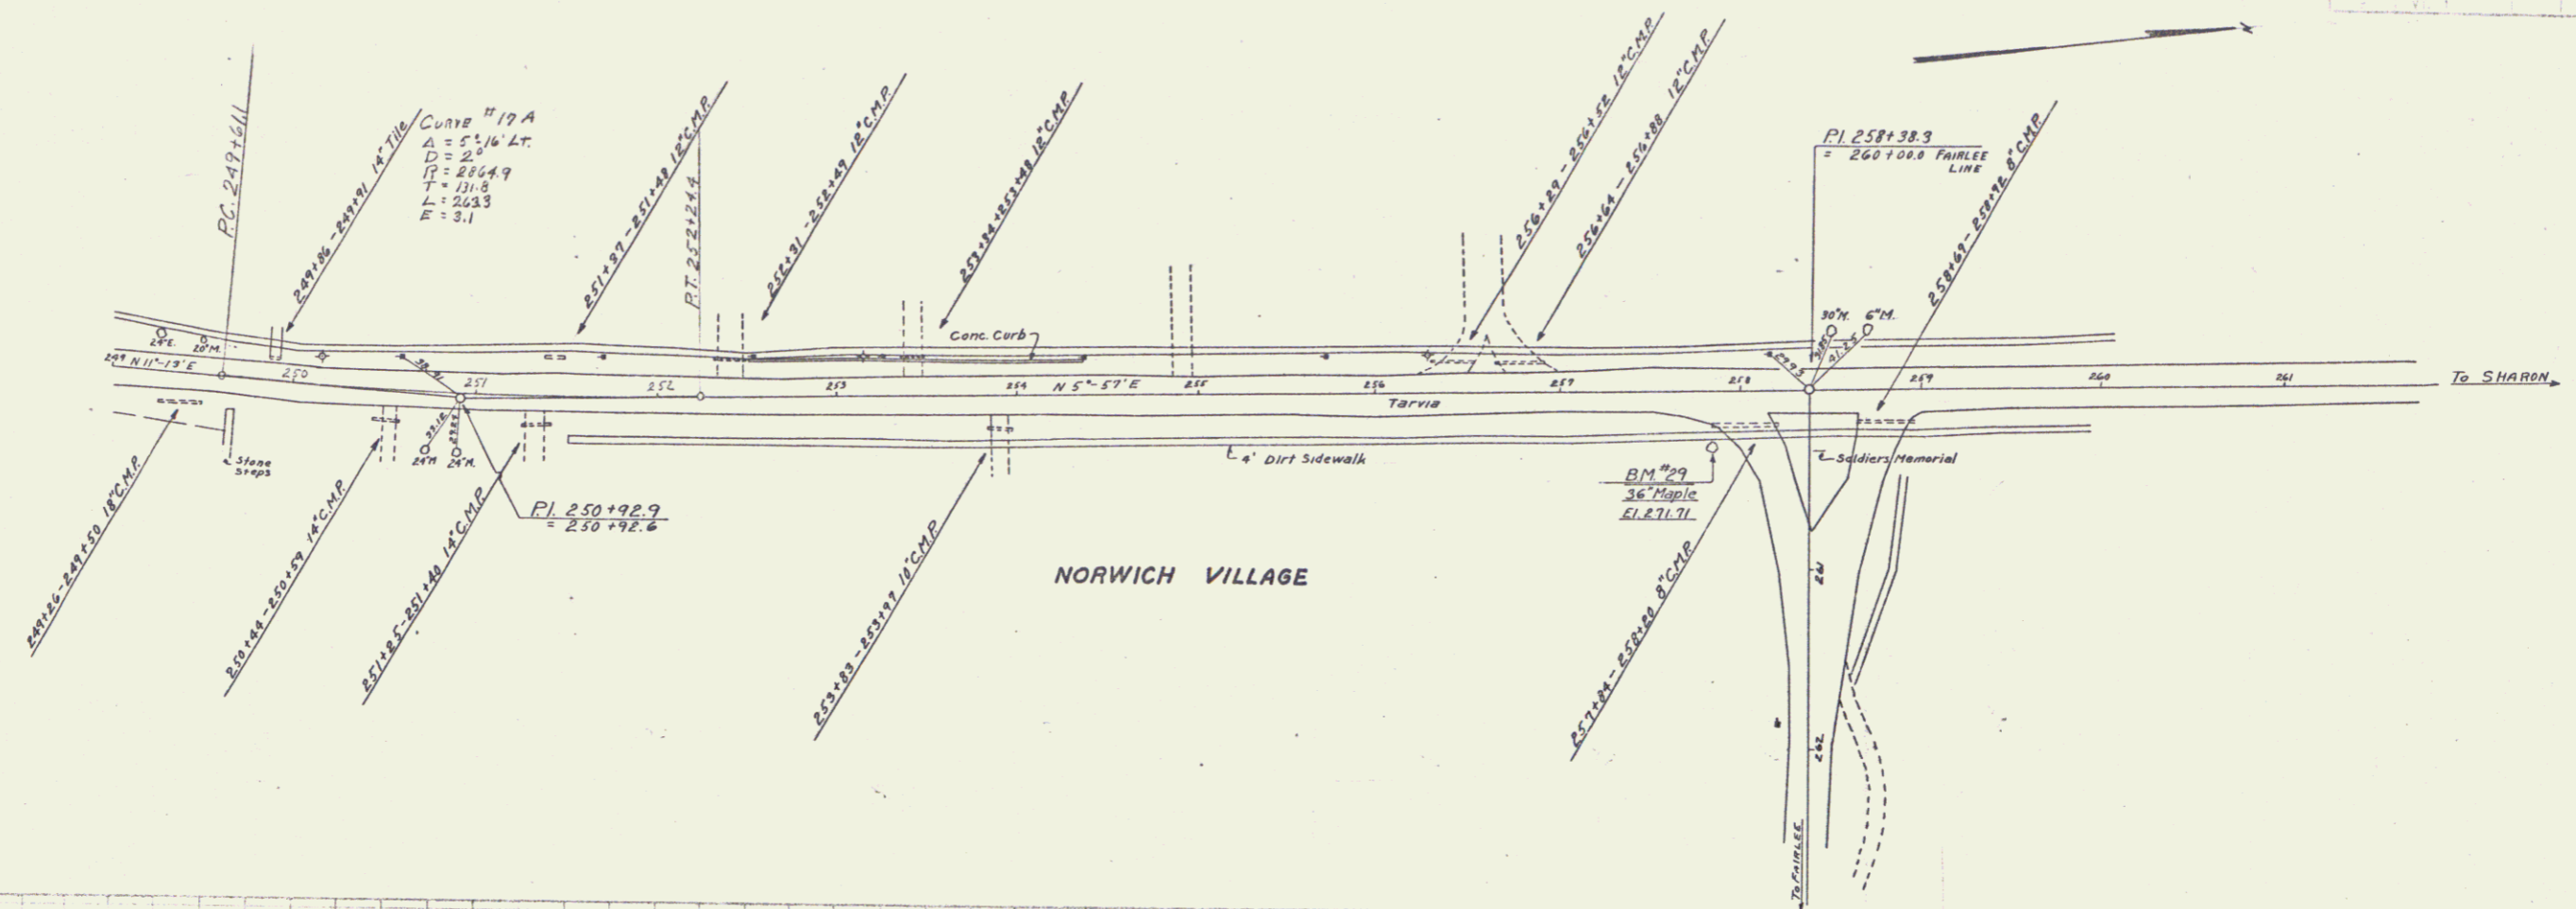

B.M. #29 SPIKE IN ROOT 30' MAPLE 26' HT. STA. 257+83 EL. 271.71

SERIES No. 114-1
SHEET 11 OF SHEETS

24