


PLAN
 DRAWN BY: W. J. BARNES
 CHECKED BY: H. B. BARRETT
 DATE: 11/17/1917

PROFILE
 DRAWN BY: W. J. BARNES
 CHECKED BY: H. B. BARRETT
 DATE: 11/17/1917

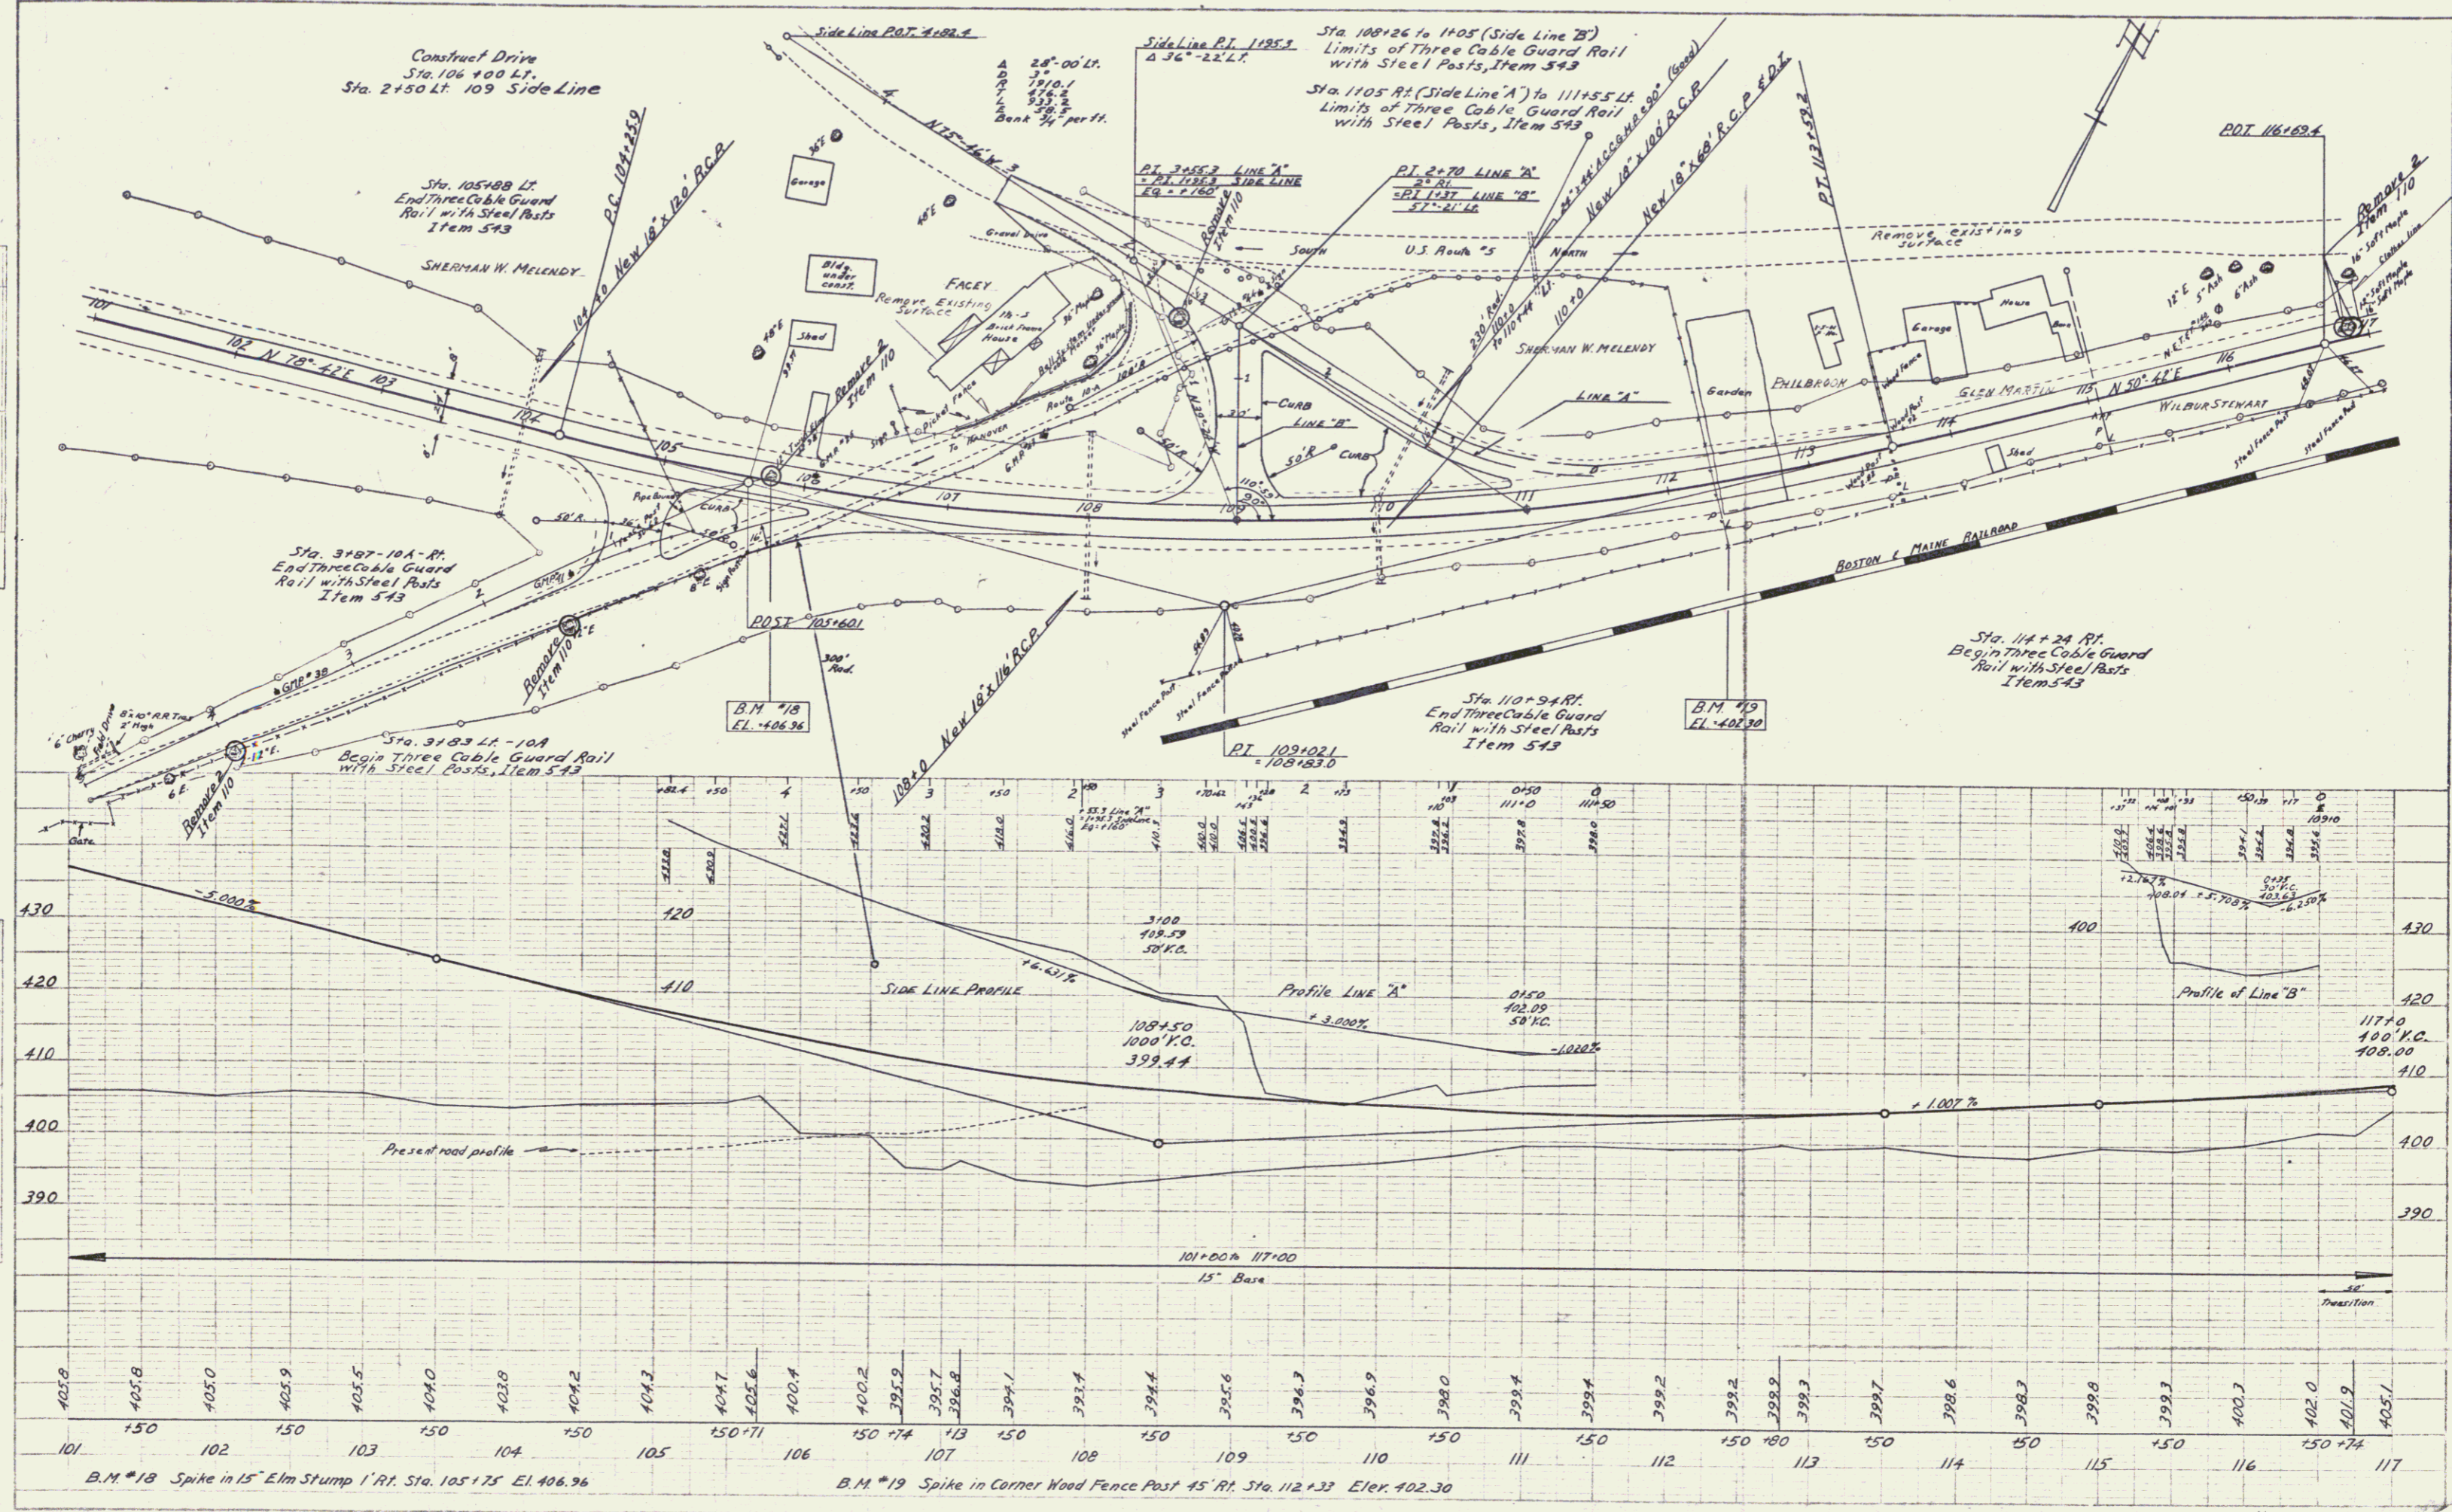

NORWICH
 Project F.L. No. 116 (105)
 Sheet 19 of 103