


OFFSETS FROM 3° CURVE

366+00	0'
130	0.5'
367+00	3.0'
150	4.5'
368+00	2.5'
150	0'

Parcel	Kind of Instrument	Date of Instrument	Grantor	Grantee	Recorded	Remarks
A-B	W.D.	9-16-35	Chris S. Susan Ladd	St. H. R. S.	240	9-16-35
A'	W.D.	1-11-36	Roy & Marie Chaffee	"	209	1-11-36
A''	W.D.	9-16-35	R. W. Chaffee & Mary J. July	"	199	9-16-35

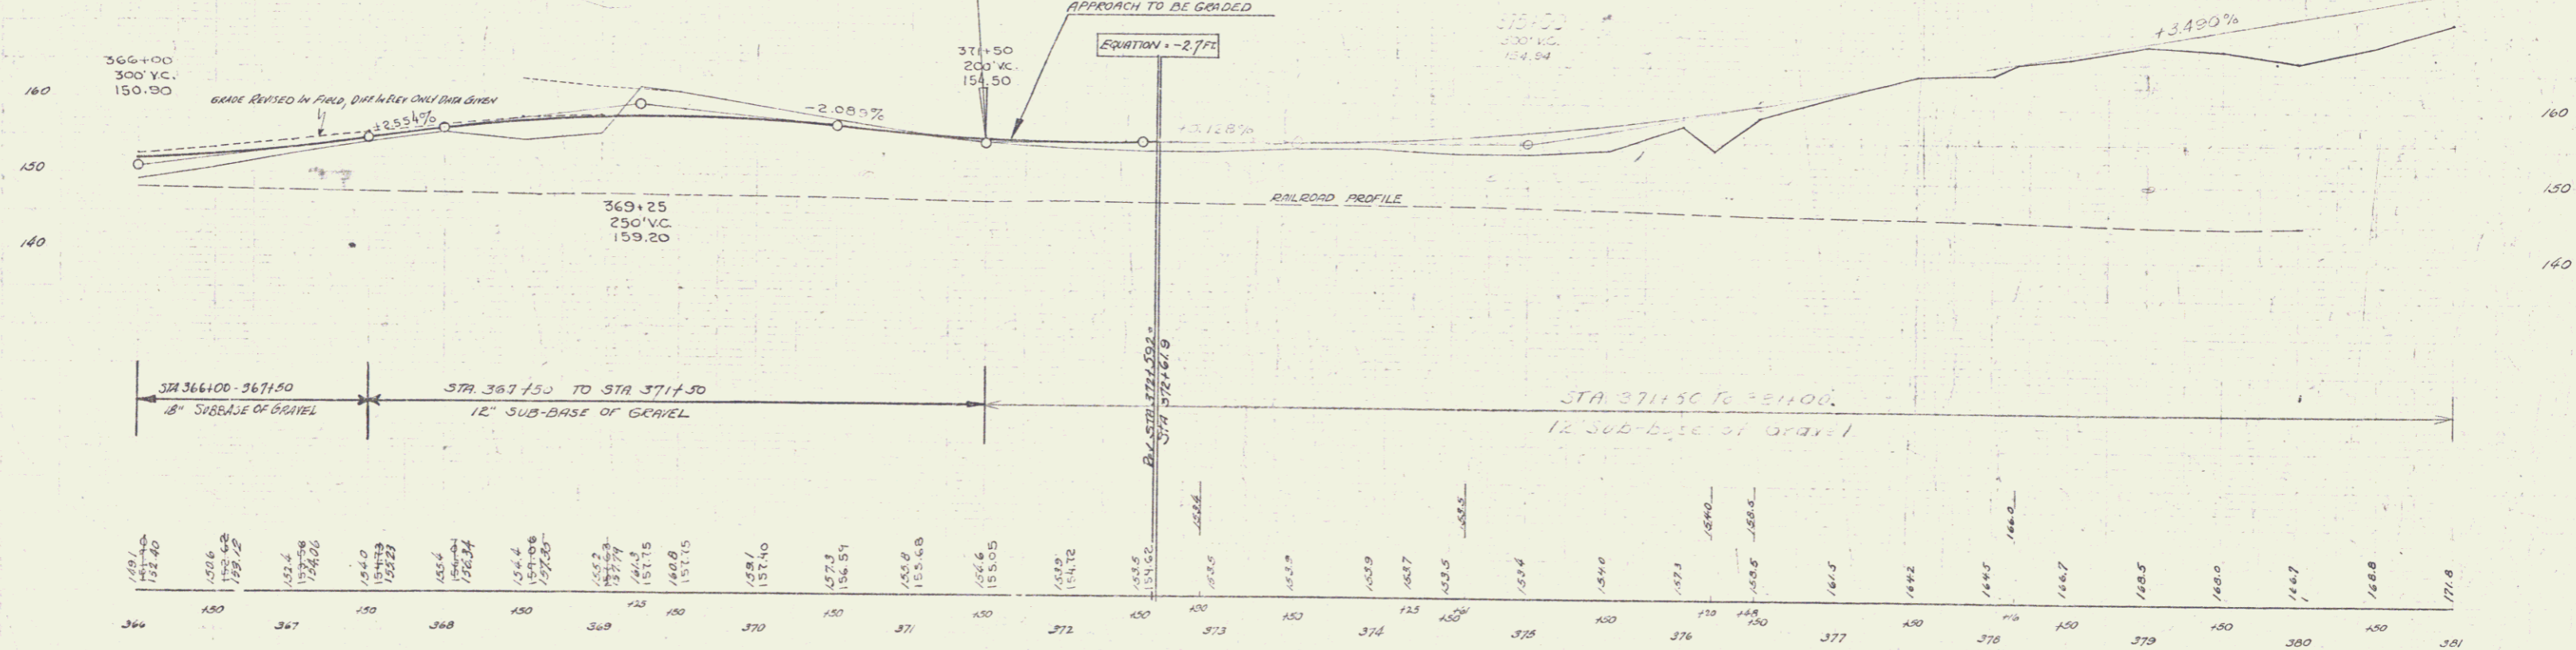

BM #44 SPOT ON CONC. GAS PUMP FOUN. 70' LT. OF STA 366+00 ELEV. 142.14  
 BM #45 BOLT ON TOP OF RR SIGNAL TOWER CASING 25 FT. RT. OF STA 375+30 ELEV. 152.46