



1" = 200'  
 Datum  
 RLW  
 ELEV  
 10/20/58  
 M. A. LOVELAND

1" = 200'  
 Datum  
 RLW  
 ELEV  
 10/20/58  
 M. A. LOVELAND

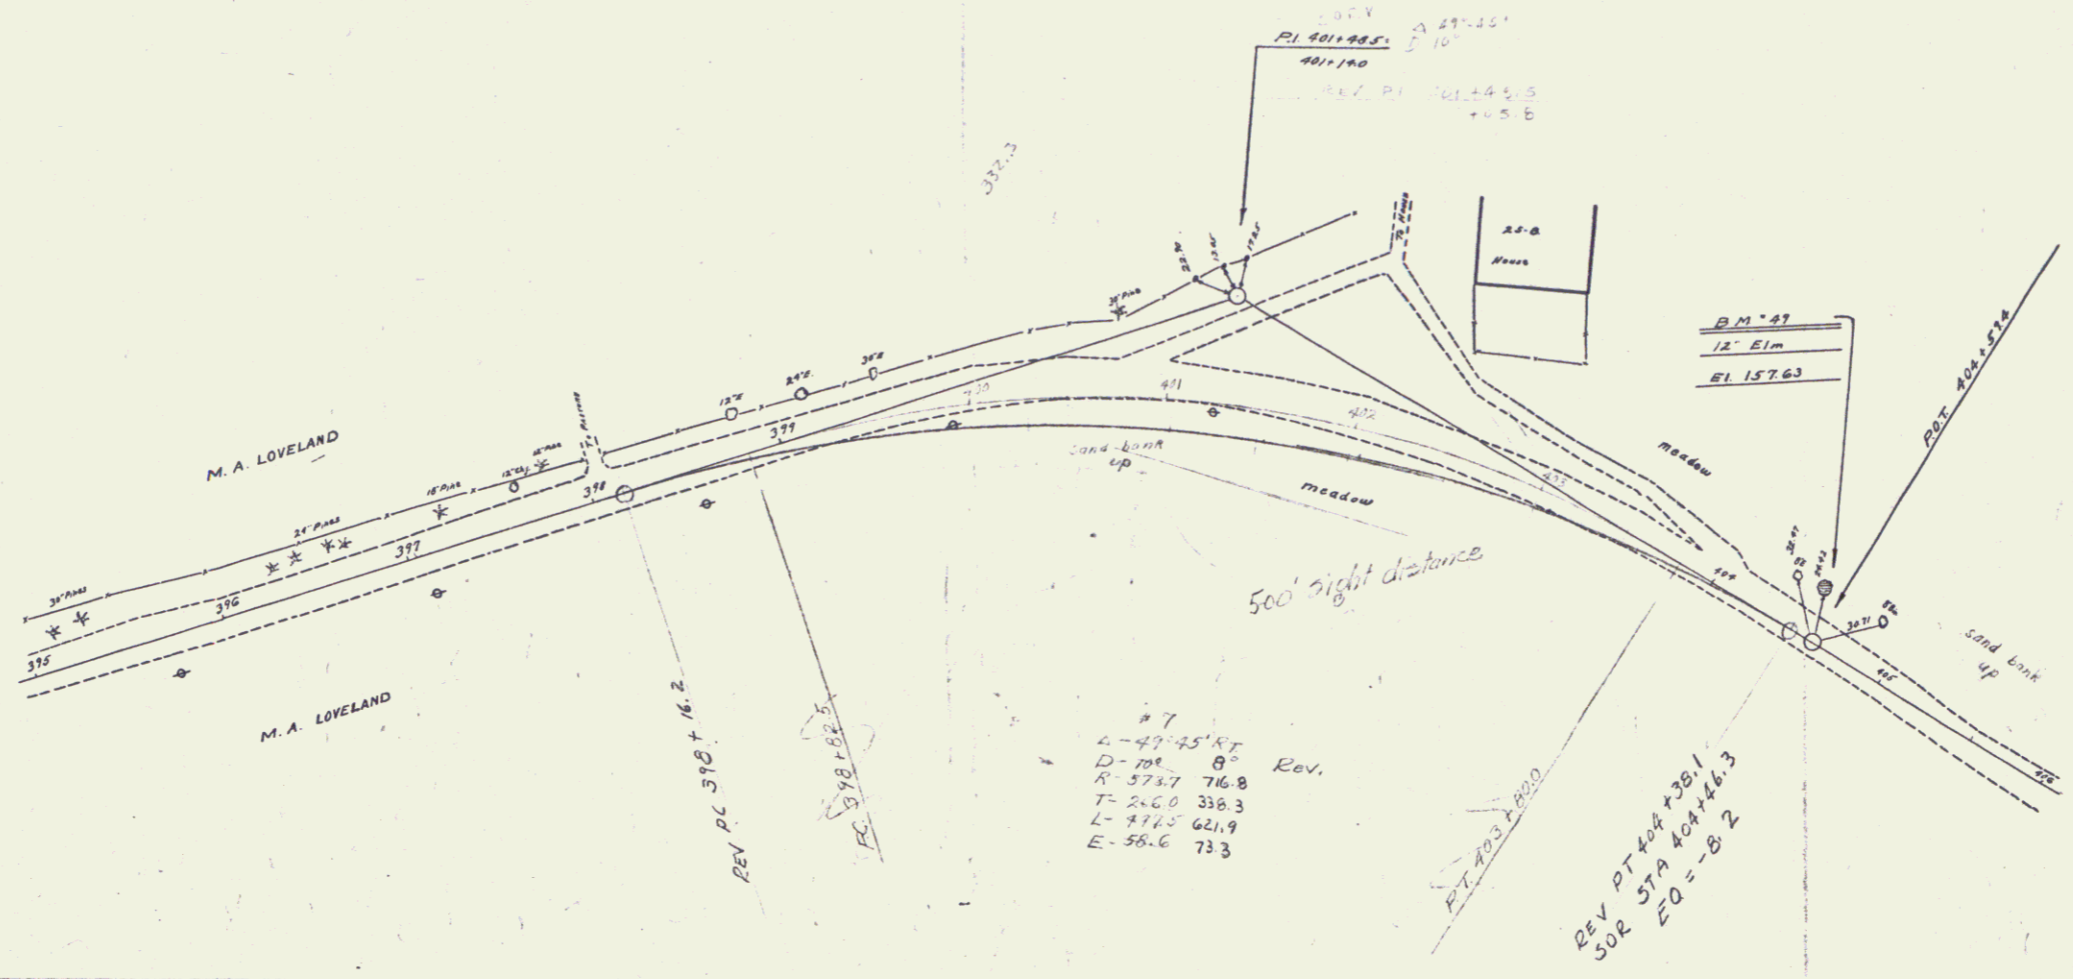

#7  
 L = 49.25' RT  
 D = 70' 8"  
 R = 573.7 716.8  
 T = 26.0 338.3  
 L = 97.5 661.9  
 E = 56.6 73.3  
 Rev.

REV. PT 404+38.1  
 SOE 404+46.3  
 ZO = -8.2

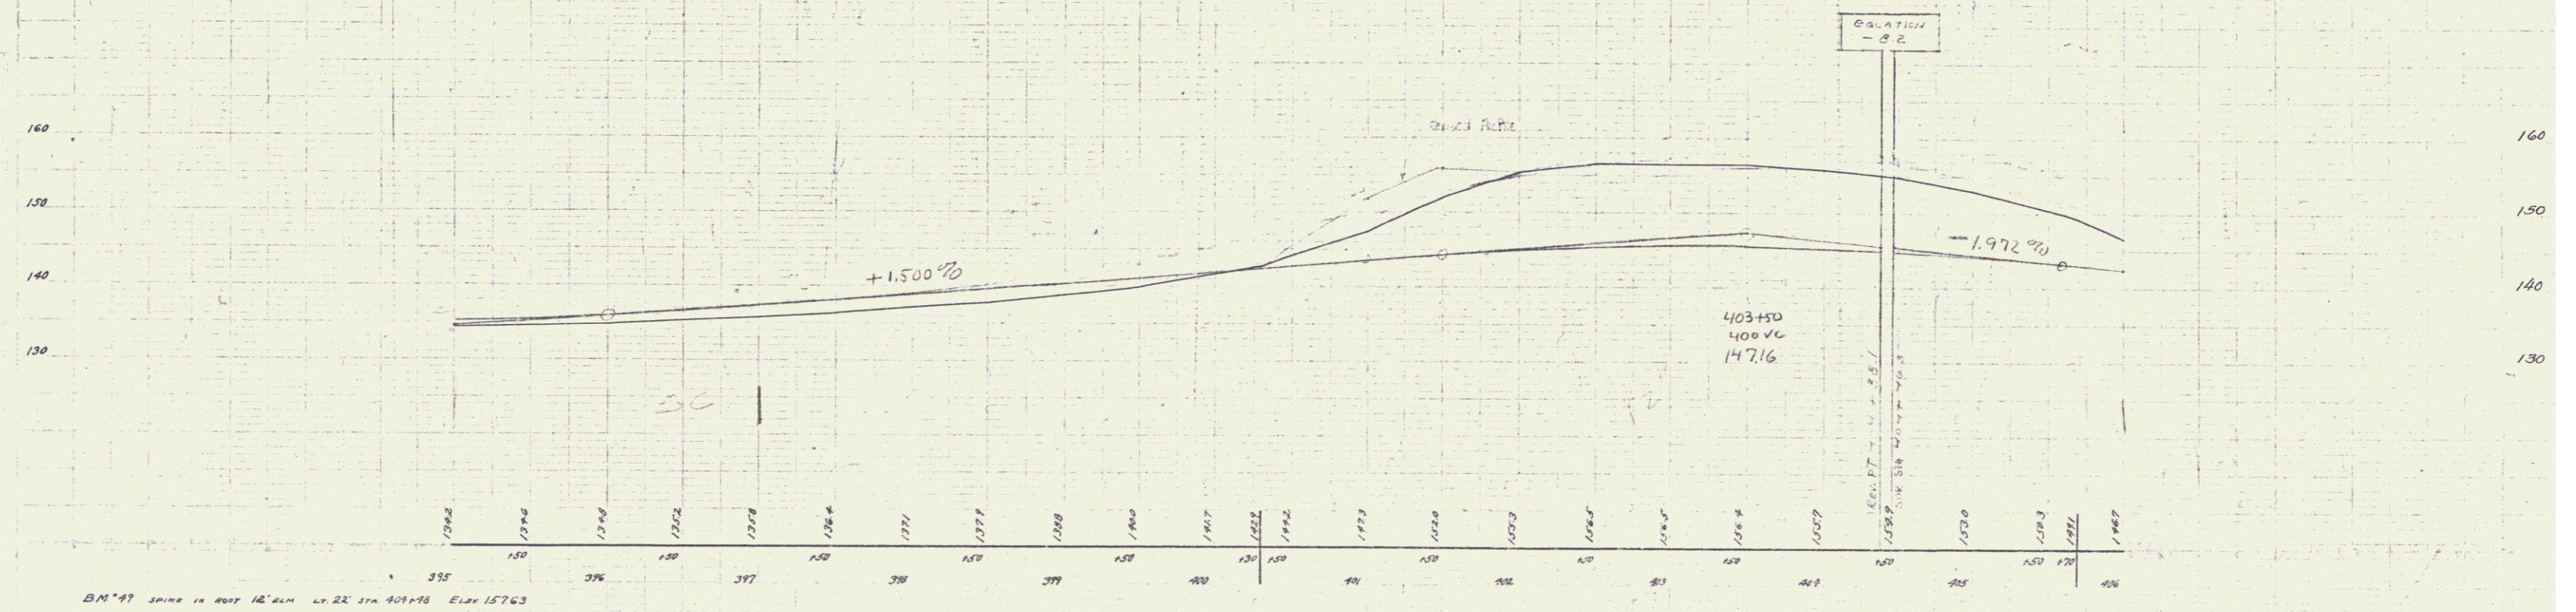

BM 47 spike in spot 12' EIM L.V. 22' STA 401+78 Elev 157.63