


PARCEL KIND OF DATE OF INSTRUMENT INSTRUMENT GRANTEE GRANTEE RECORDED REMARKS
 180 Q.C.D. 11-3-36 ANGLIA E. FOOTESTATE JOHN B. PAGE DAN
 181 Q.C.D. 11-3-36 W.H. M.M. HARRISON " " 26 449

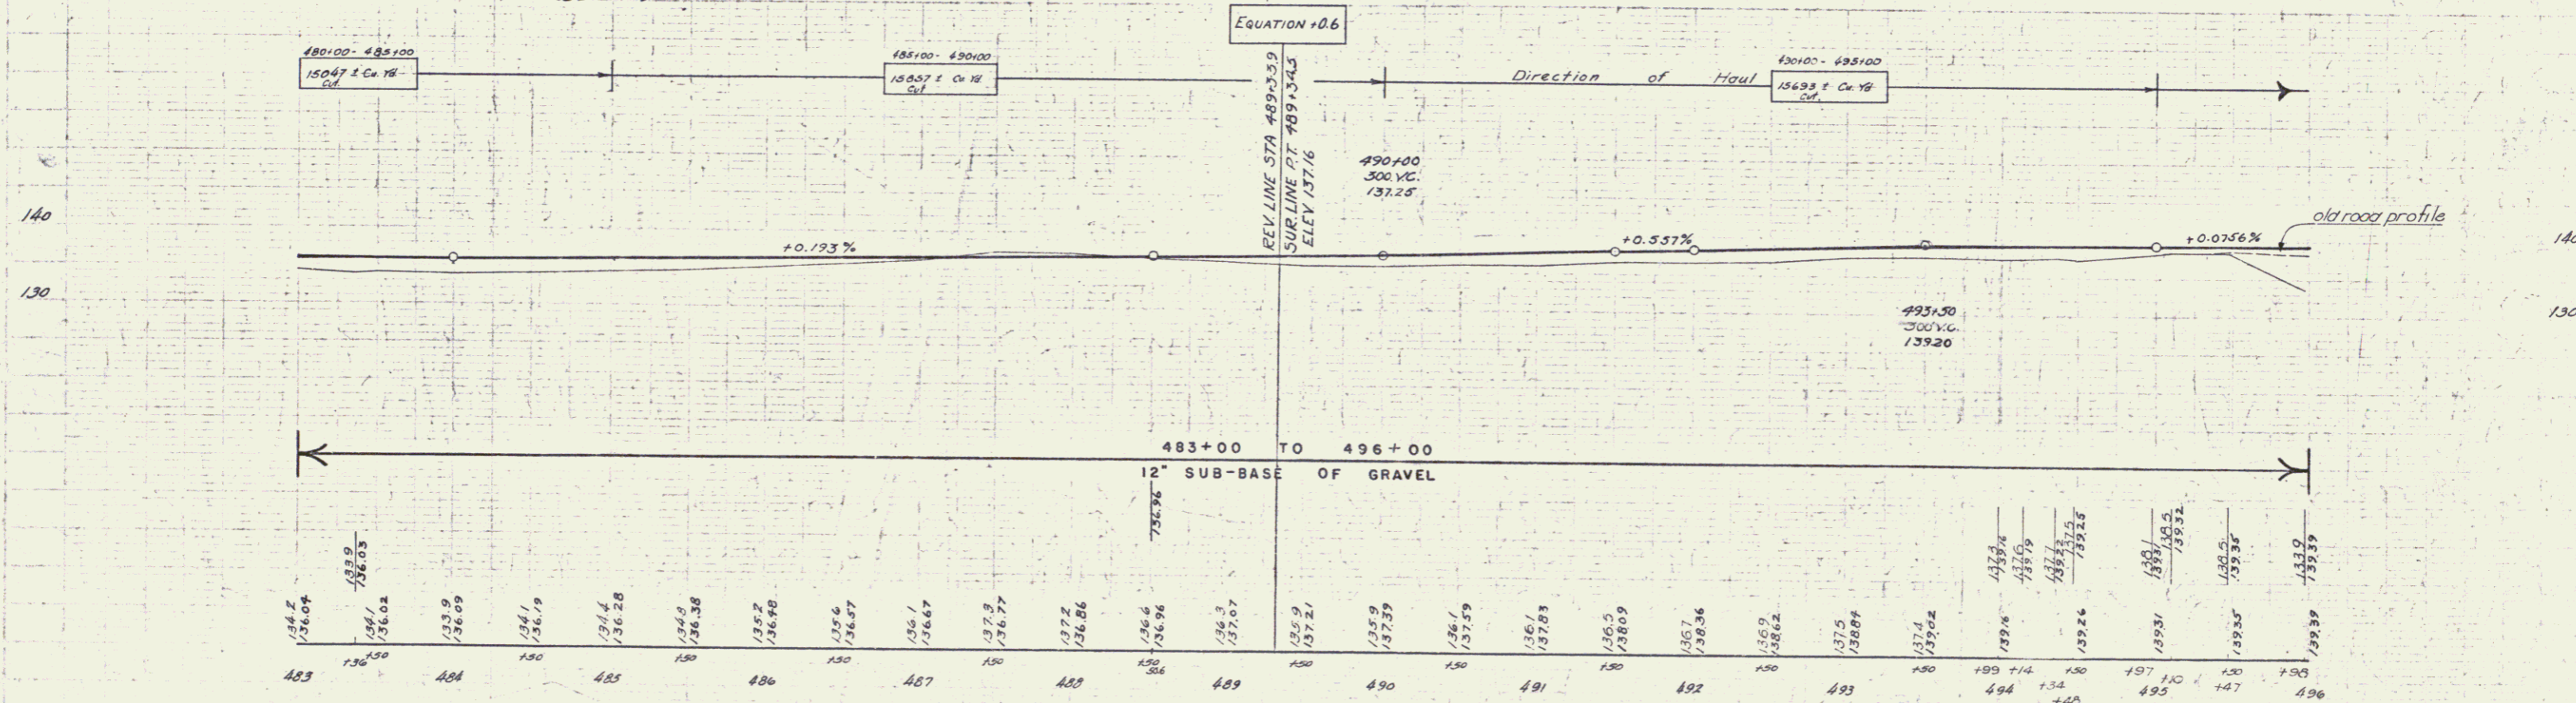

B 11' 53" SPIKE IN ROOF OF 30' ELM - 25' FT STA 494+24 - EL. 134.56