

INDEX OF SHEETS

SHEET NO. 1	TITLE PAGE
2	TYPICAL CROSS-SECTION OF IMPROVEMENT 1/2" GRISHED GRAVEL MIXED-IN-PLACE SURFACE COURSE WITH REFINED TAR, CLASS G, ITEM 341
3	BANKING AND WIDENING TABLES
4	QUANTITY SHEET (ITEMS AND DRAINAGE)
5	EARTHWORK SHEET
6-8	PLAN AND PROFILE
9	STANDARD STRUCTURE SHEET S-40 BARRICADES, SIGNS AND LIGHTS
10	STANDARD STRUCTURE SHEET S-41 ROUNDING OF SLOPES
11	STANDARD STRUCTURE SHEET S-46-45 BOUNDARY MARKERS
12	STANDARD STRUCTURE SHEET S-47-45 PIPE CULVERTS
13	STANDARD STRUCTURE SHEET S-48-46 GUARD RAIL
14-19	CROSS SECTIONS
19-A	ABUTMENT PROTECTION 534+92

STANDARD STRUCTURE SHEETS APPROVED BY THE CHIEF ENGINEER, VERMONT STATE DEPARTMENT OF HIGHWAYS

S-40 FEB. 28, 1949
 S-46-45 FEB. 28, 1949
 S-47-45 FEB. 28, 1949
 S-48-46 MAY 13, 1946

STATE OF VERMONT
 STATE HIGHWAY DEPARTMENT
 PLAN AND PROFILE OF PROPOSED
 STATE HIGHWAY

STATE AID PROJECT

TOWN OF NORWICH


COUNTY OF WINDSOR
 WHITE RIVER JCT.-BRADFORD ROAD
 U.S. ROUTE 5

Pin# 990314

BEGINNING AT A POINT 458 FEET NORTHERLY FROM THE BRIDGE OVER THE OMPOMPANOOSUC RIVER AND EXTENDING NORTHEASTERLY 2,300 FEET.


LENGTH OF PROJECT 2,300 = 0.436 MILE

FED. ROAD DIST. NO.	STATE	PROJ. NO.	FISCAL YEAR	SHEET NO.	TOTAL SHEETS
1	Vt.	BT 114(X)	WAR	1	20

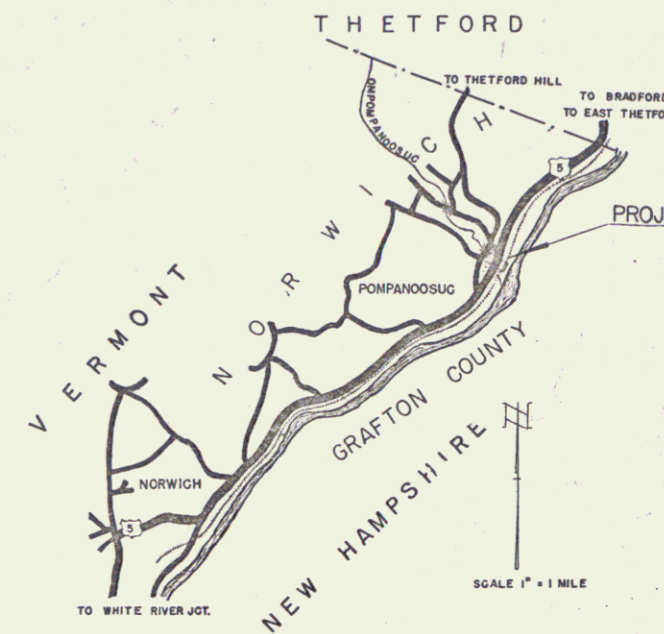

Norwich 57

NO. 114 (X)
 TOWN OF NORWICH
 COUNTY OF WINDSOR
 WHITE RIVER JCT.-BRADFORD ROAD
 U.S. ROUTE 5
 CONTRACTOR: Lucien Demers
 LOCATION: White River Jct.-Bradford Rd.
 DATE: July 31, 1951

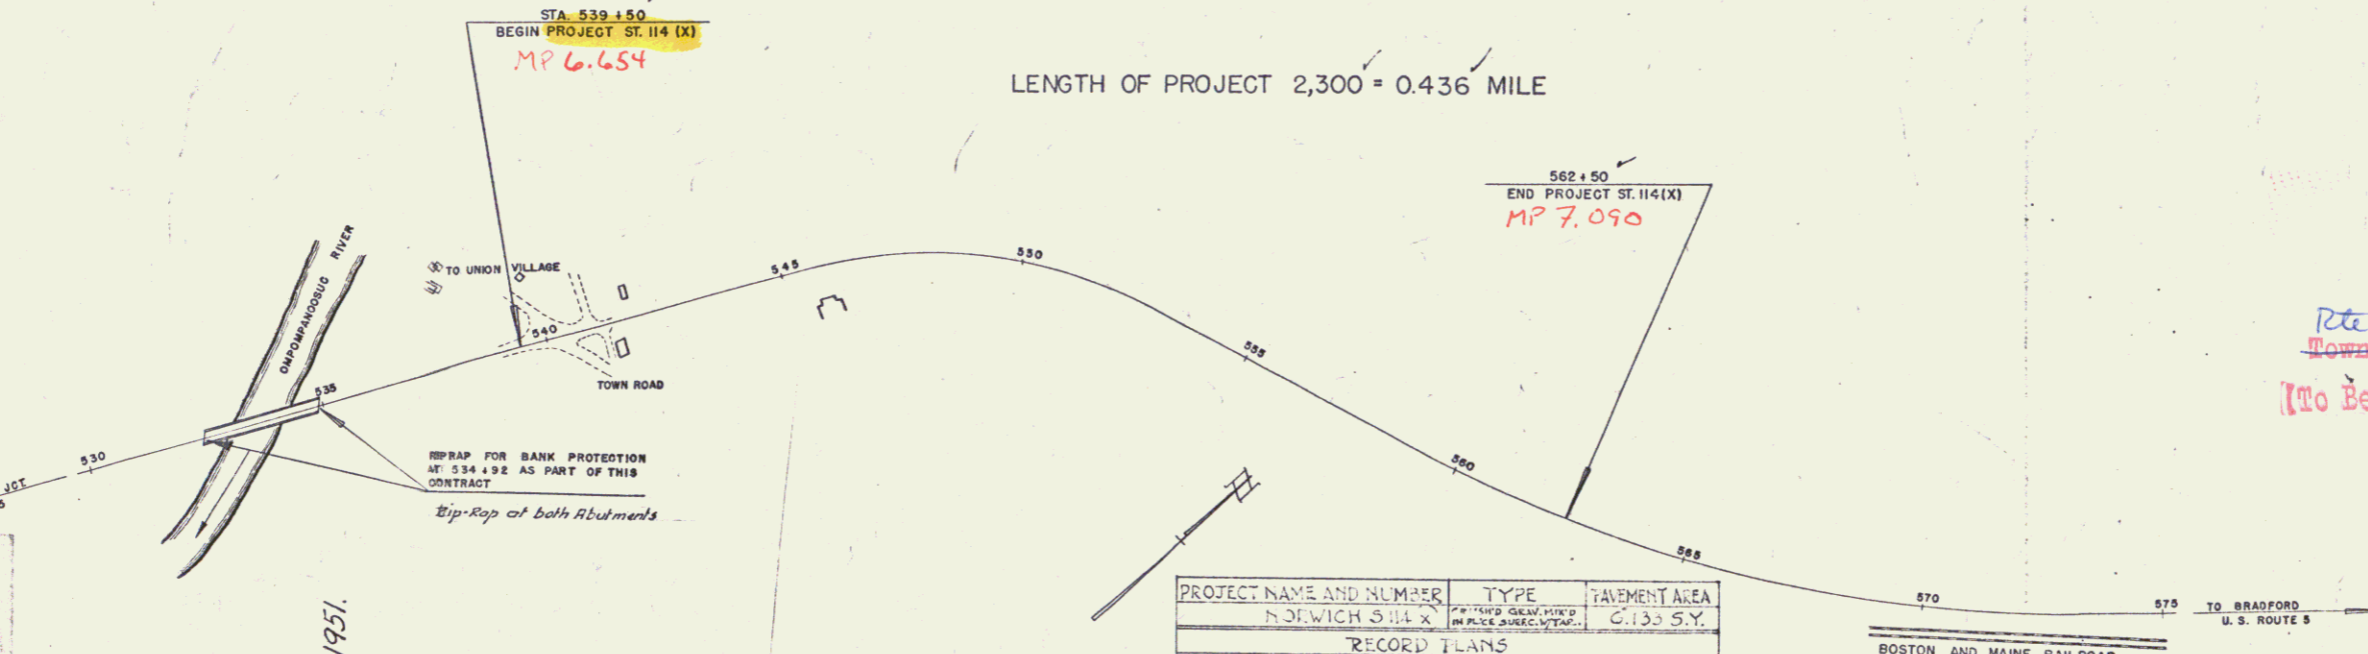

GROUND ELEVATION..... DATUM..... LINE.....

GRADE ELEVATION..... DATUM..... LINE.....

CURVE DATA

DEFLECTION ANGLE.....	Δ
DEGREE OF CURVE.....	D
RADIUS OF CURVE.....	R
TANGENT DISTANCE.....	T
LENGTH OF CURVE.....	L
EXTERNAL DISTANCE.....	E
POINT OF INTERSECTION.....	P.I.
POINT OF CURVE.....	P.C.
POINT OF TANGENT.....	P.T.
POINT ON TANGENT.....	P.O.T.

NORWICH 56.14 (X)
 Contractor: Lucien Demers
 Record Plans
 Construction Completed July 31, 1951.

SCALES

TITLE	1" = 200'
TYPICAL	1" = 5'
PLAN	1" = 50'
PROFILE HORIZONTAL	1" = 50'
PROFILE VERTICAL	1" = 10'
CROSS SECTIONS	1" = 5'

PROJECT NAME AND NUMBER	NORWICH 56.14 (X)	TYPE	TYPE GRAVEL MIXED IN PLACE SURFACE	PAVEMENT AREA	6.133 S.Y.
RECORD PLANS					
MATERIALS					
GRAVEL	GOODSELL PIT NORWICH	COMPACT	BERGER METAL PIPE CO. TOMCAR.		
TAR	TARVIA, BARRETT CO. WINDSOR, VT.	STONE	ABUNDANT VERMONT COPPER MINES, STAFFORD, VT.		
STONE	ROAD-TOWN STATE SAND & GRAVEL WINDSOR H.N.	GUARD RAIL CABLE	DETHELEIGH STEEL CO.		
CEMENT	PORTLAND CEMENT LOWESTAR				
R.O.P.	VERMONT PIPE CO. WINDSOR, VT.				
CONTRACTOR	LUCIEN DEMERS	CONTRACT DATED	APR. 19, 1950		
RESIDENT ENGR.	DR. R. BURENE	CONTRACT STARTED	AUG. 19, 1950		
INSPECTOR		CONTRACT COMPLETED	JULY 31, 51		
RECORD PLANS BY	E. E. BRIZONE E.S. MAIN	CONTRACT ACCEPTED	JULY 31, 51		

ANY FURTHER INFORMATION CONCERNING FINAL QUANTITIES AMOUNTS OR OTHER DETAILS RELATIVE TO THIS PROJECT MAY BE FOUND IN EITHER THE FIELD BOOK OR THE ESTIMATE FILE.

RIGHT-OF-WAY DIVISION
 TOWN FILE
 PERPETUAL
 Rte. of U.S. 5
 (To Be Returned To R.O.W. Division)

APPROVED: JUNE 9, 1950
 H.E. Langue
 CHIEF ENGINEER

SUBMITTED BY ORDER OF THE STATE HIGHWAY BOARD

APPROVED: JUNE 9, 1950 H.E. Langue HIGHWAY ENGINEER	APPROVED: JUNE 23, 1950 R.B. Conwell DISTRICT HIGHWAY COMMISSIONER	SERIES ST. NO. 114 (X) FILED SHEET 1 OF 19
---	--	---