


PLAN
 DRAWN BY
 CHECKED BY
 DATE
 SCALE

PROFILE
 DRAWN BY
 CHECKED BY
 DATE
 SCALE

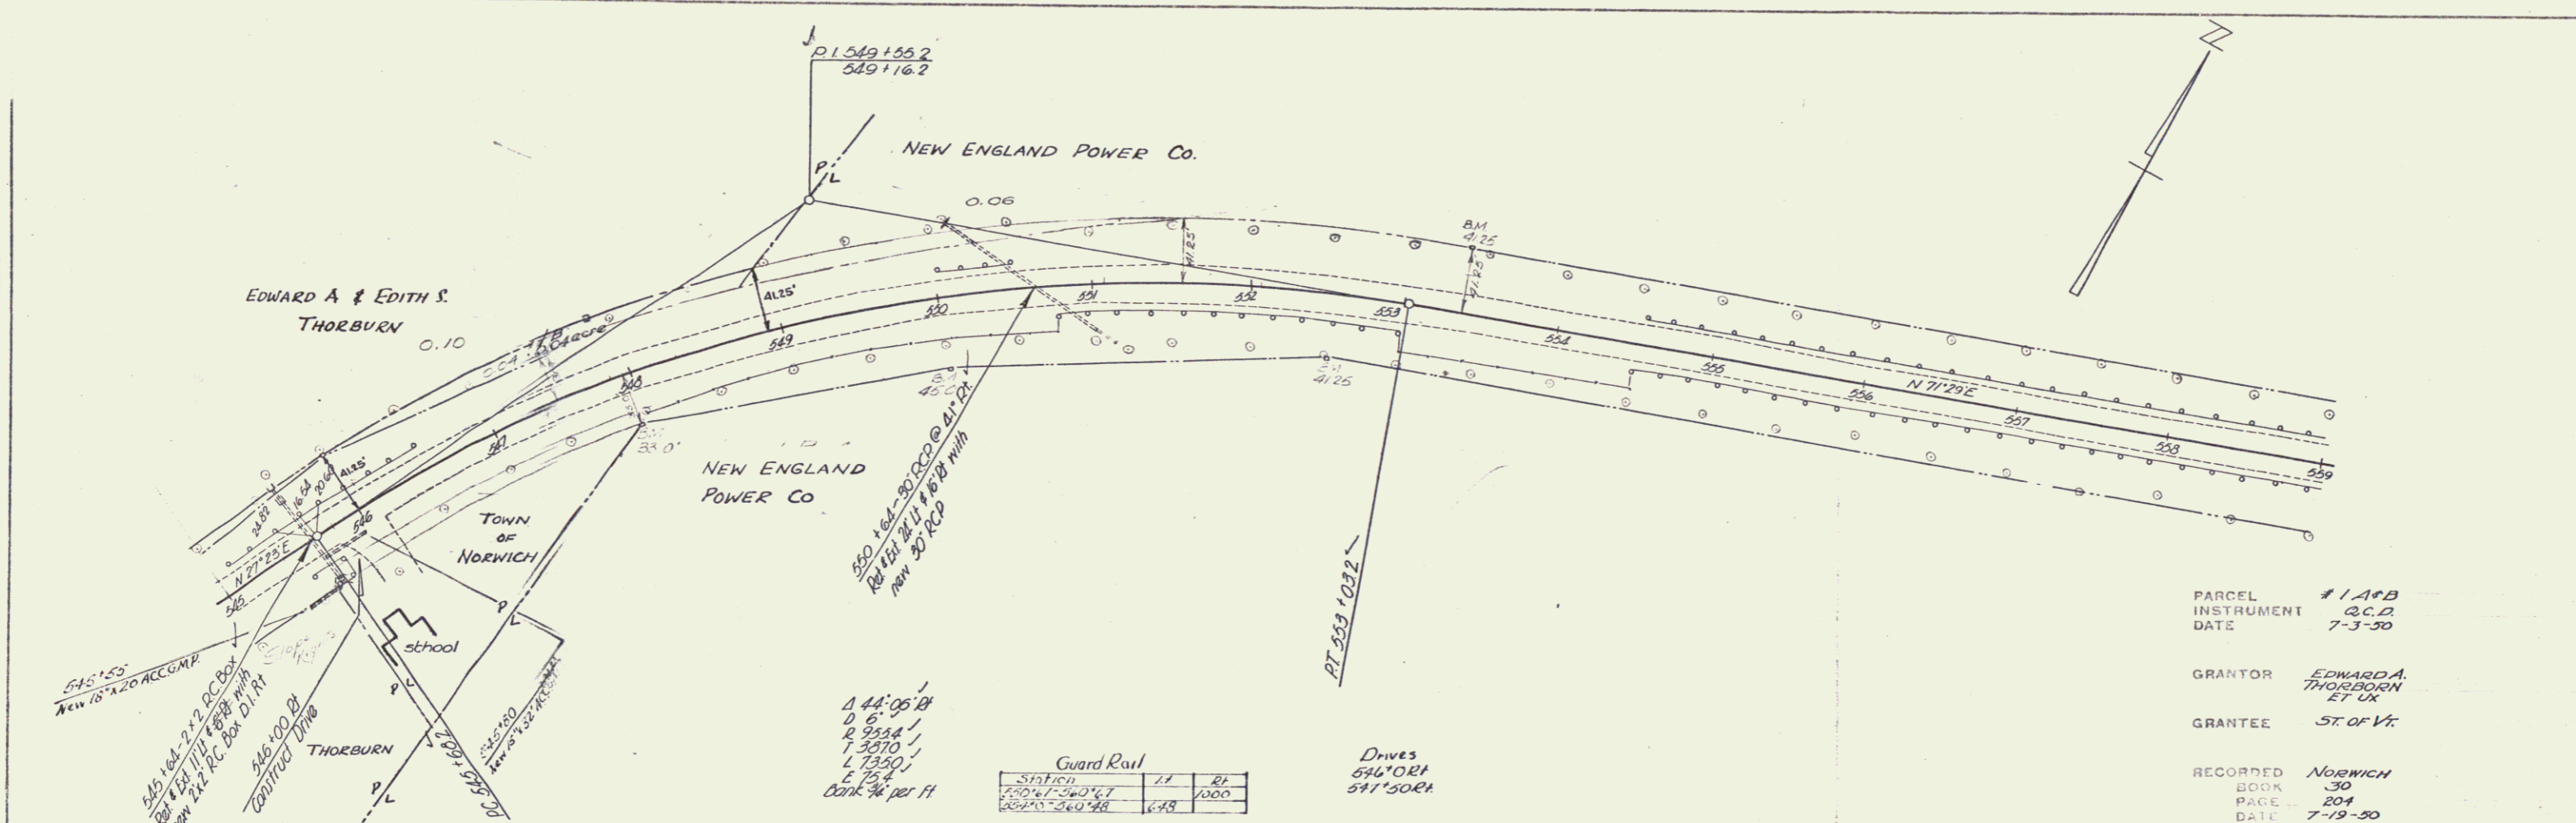


44.05' H
 0.6'
 0.554'
 1.330'
 2.754'
 4.408'
 6.062'
 143.344'
 145.000'

Station	Left	Right
545+00	150	150
546+00	150	150
547+00	150	150
Drives
 546+00 to
 547+00

PARCEL # 1 AFB
 INSTRUMENT Q.C.D.
 DATE 7-3-50
 GRANTOR EDWARD A. THORBURN ET UX
 GRANTEE ST. OF VT.
 RECORDED NORWICH
 BOOK 30
 PAGE 204
 DATE 7-19-50
 REMARKS #11A05HT 6

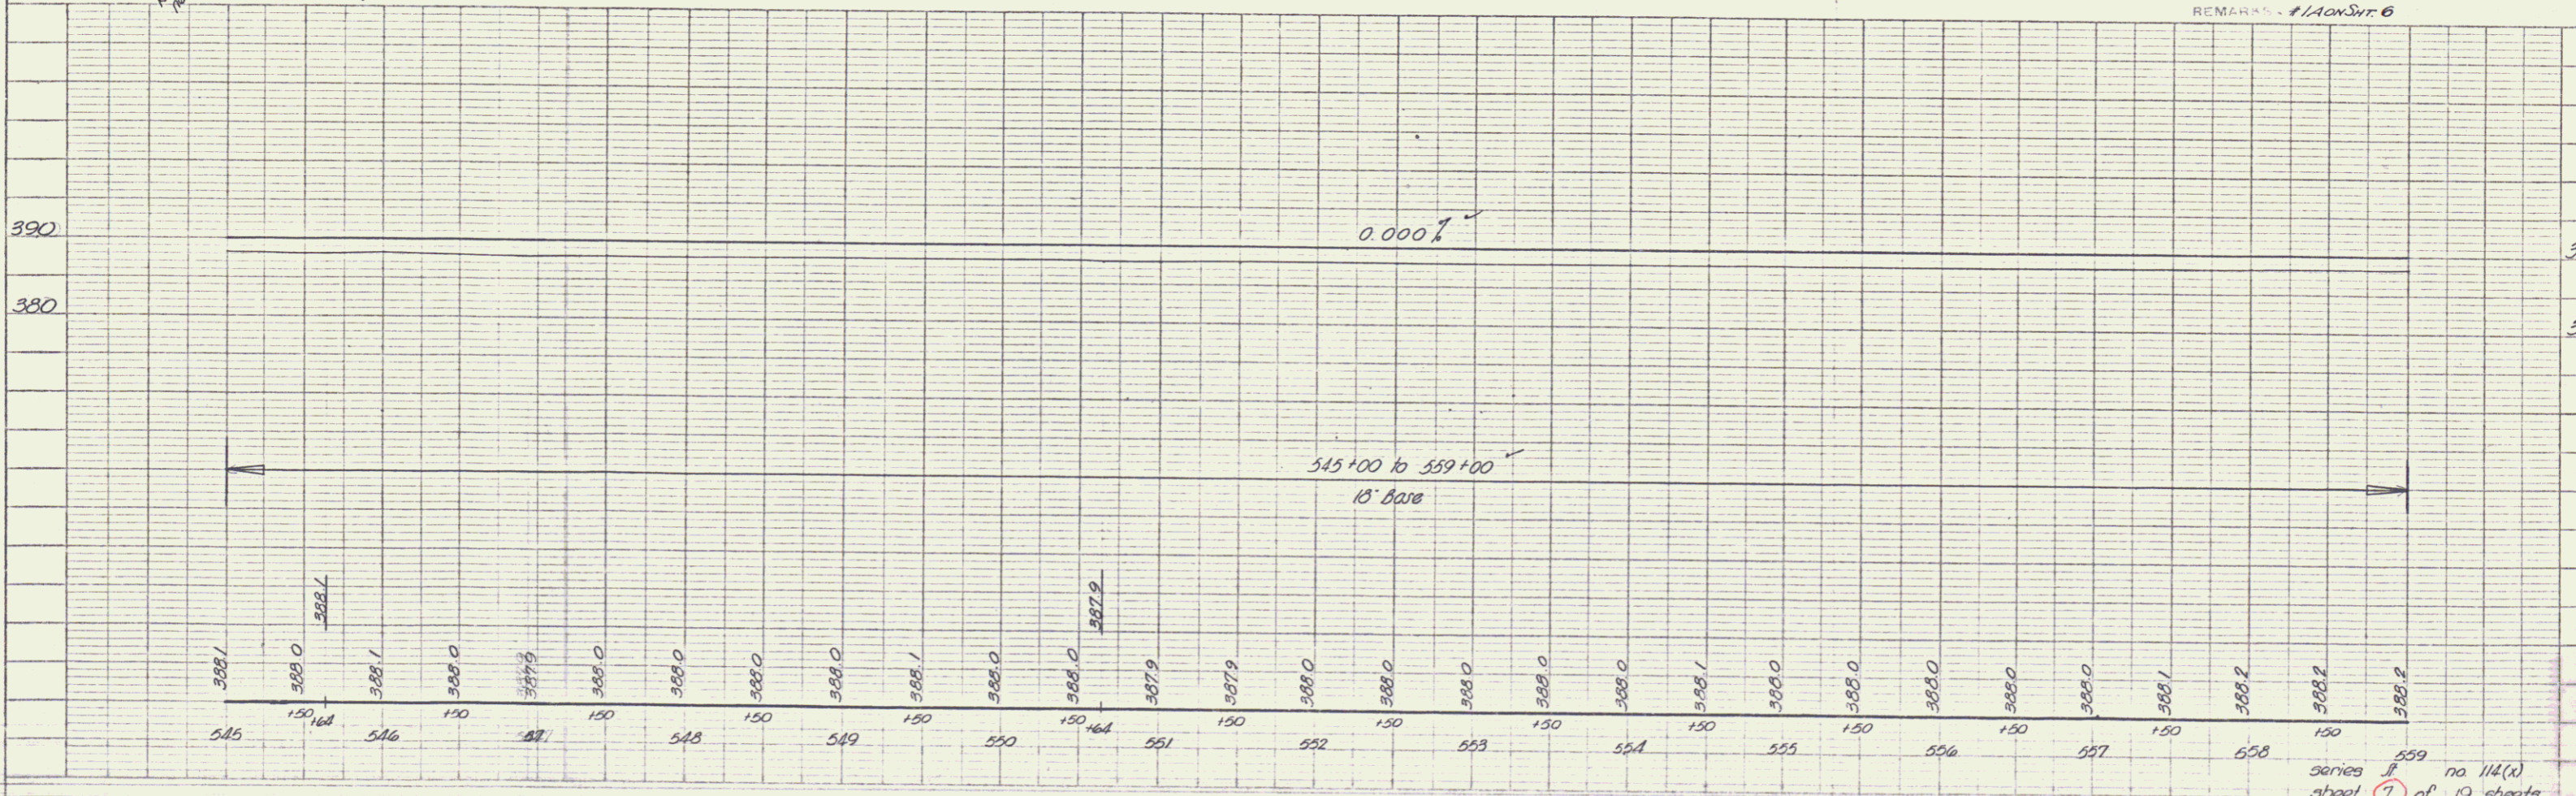

series 11 no 114(x)
 sheet 7 of 10 sheets
 Norwich