
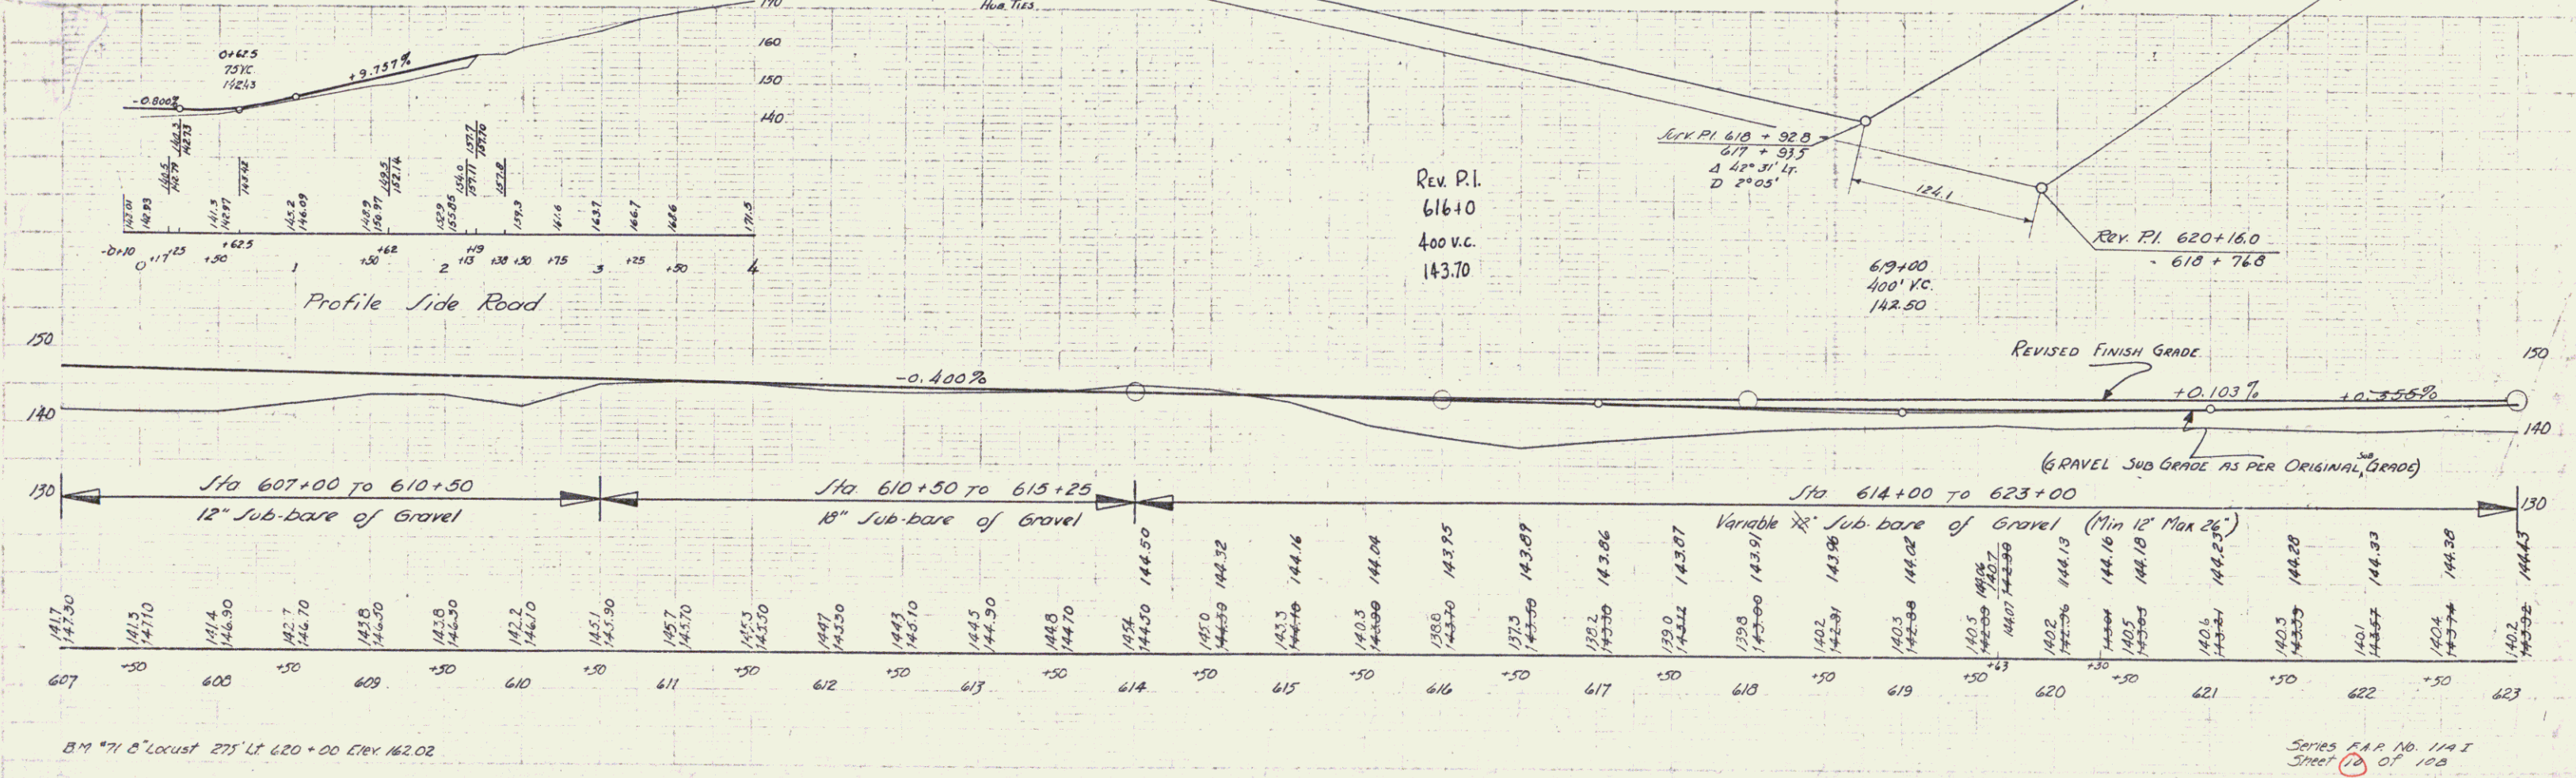


PART: INSTRUMENT DATE GRANTOR GRANTEE RECORDED REMARKS
 A-B W.O. 8-29-37 W.M. McAllister B. B. HOWE LUMBER ESTATE 37 OF VT. 300K PAGE DATE CUL-STA.
 26 45 6-31-37 18 53+00
 18 60+50
 30 67+50

FED. ROAD STATE AID LOCAL SHARE
 DIST. NO. 114-1 1936 70 100
 PROJ. NO. 114-1 1936 70 100

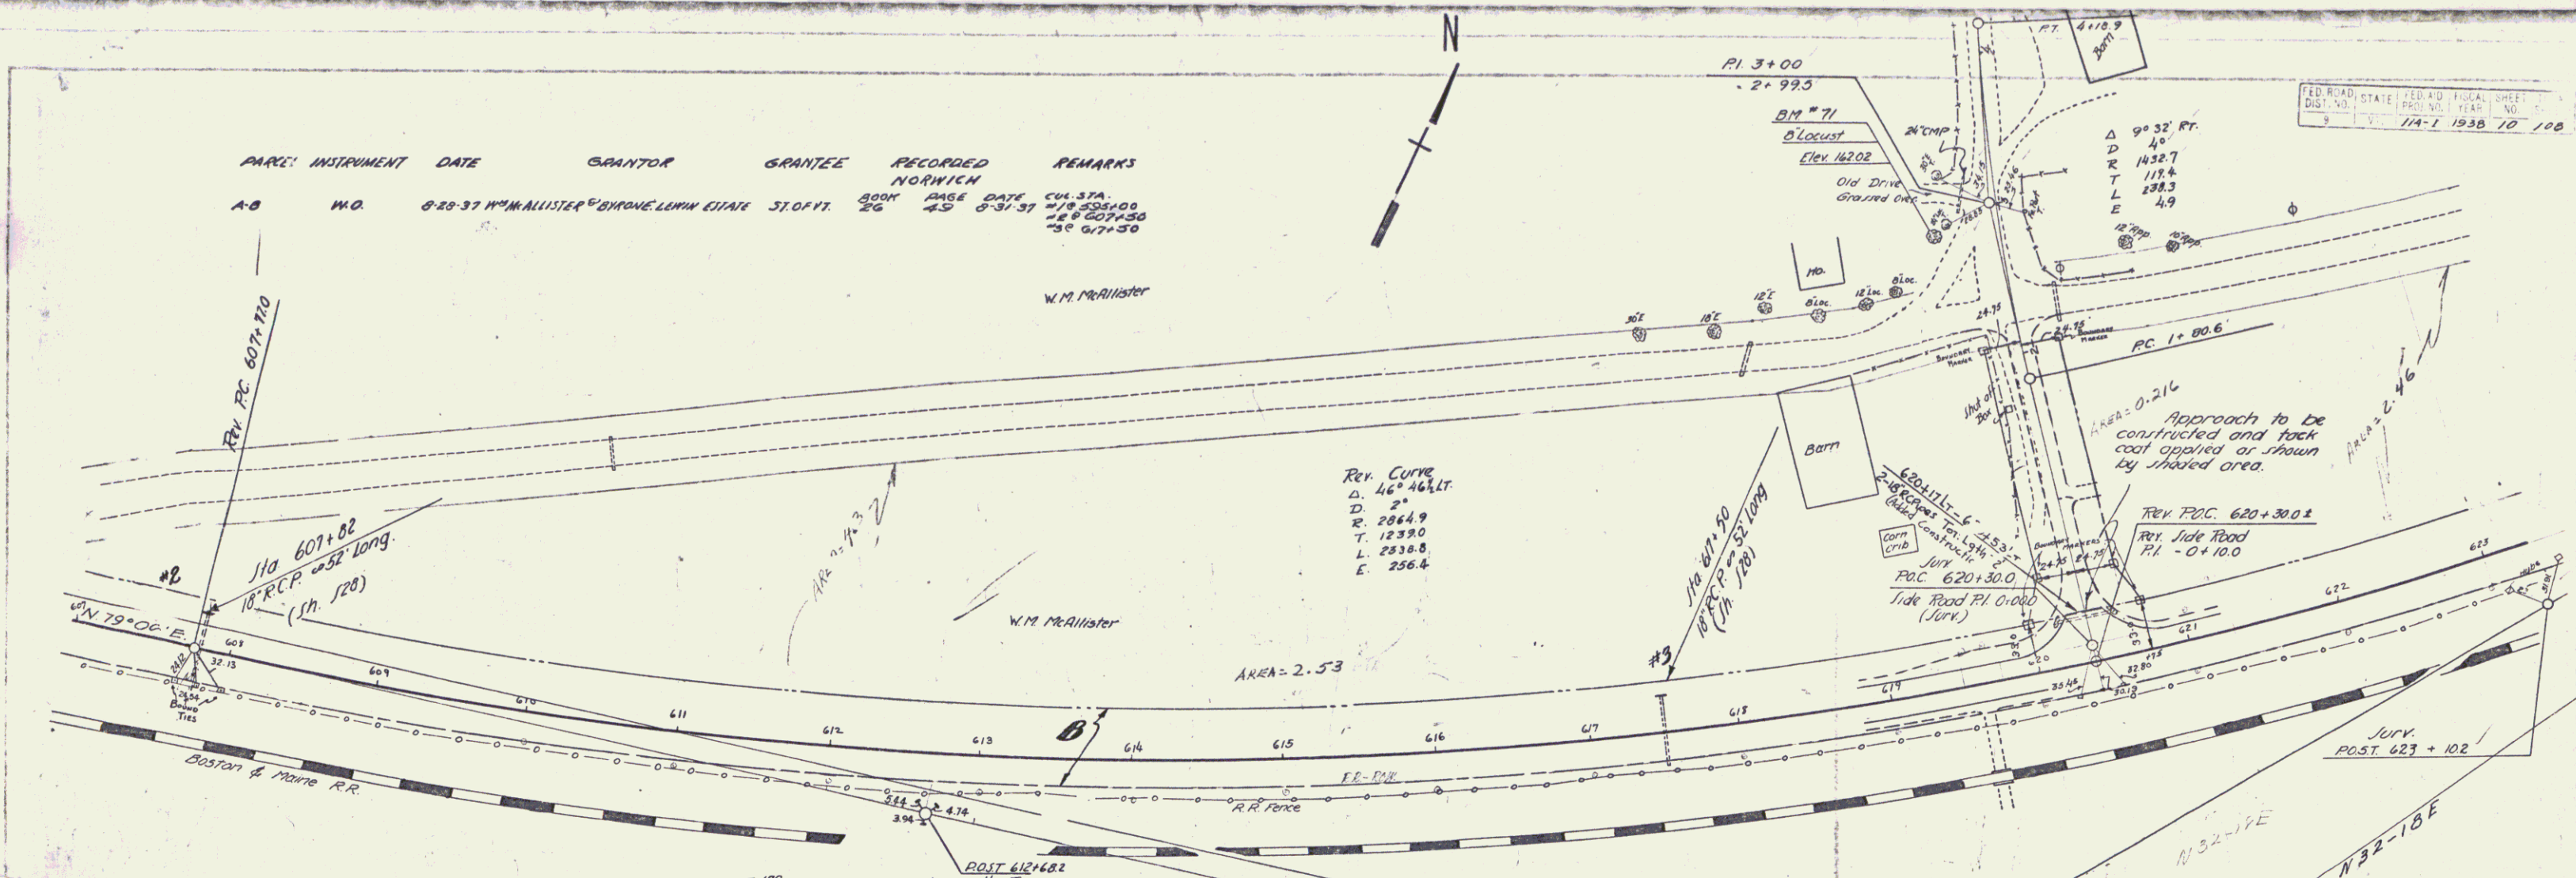

BM #71 6 Locust 275' Lt 620+00 Elev 162.02

Series P.A.R. No. 114 I
Sheet 10 of 100

8