


PARCEL	INSTRUMENT	DATE	GRANTOR	GRANTEE	RECORDED	REMARKS
A-B	W.O.	8-28-57	M. HAUSTER	BIRNIE LEWIN EST.	BOOK PAGE DATE 26 8-31-57 535+00 607+50 617+50	
A'	O.C.D.	8-28-57	E.H. & I.D.A. SARGENT	"	32 406-7 8-31-57	
A''	O.C.D.	8-28-57	C.L. SARGENT	"	32 407-8 8-31-57	

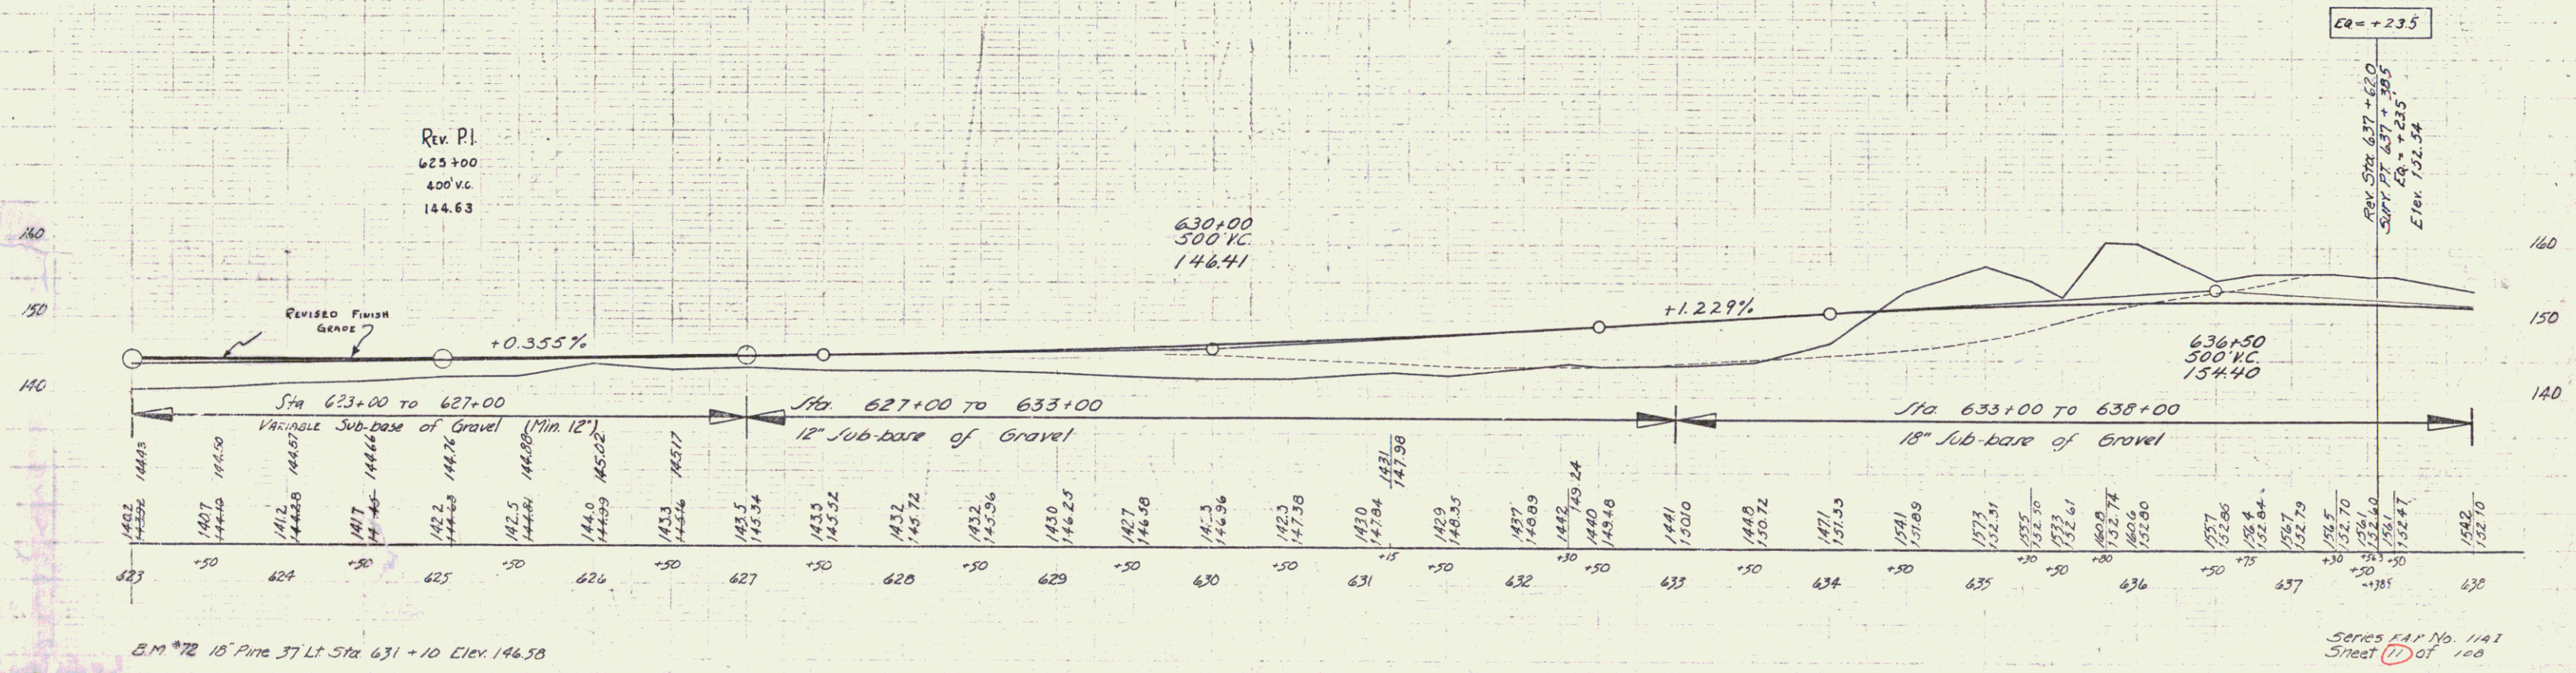

Series E.P. No. 1141
Sheet 17 of 100

9