
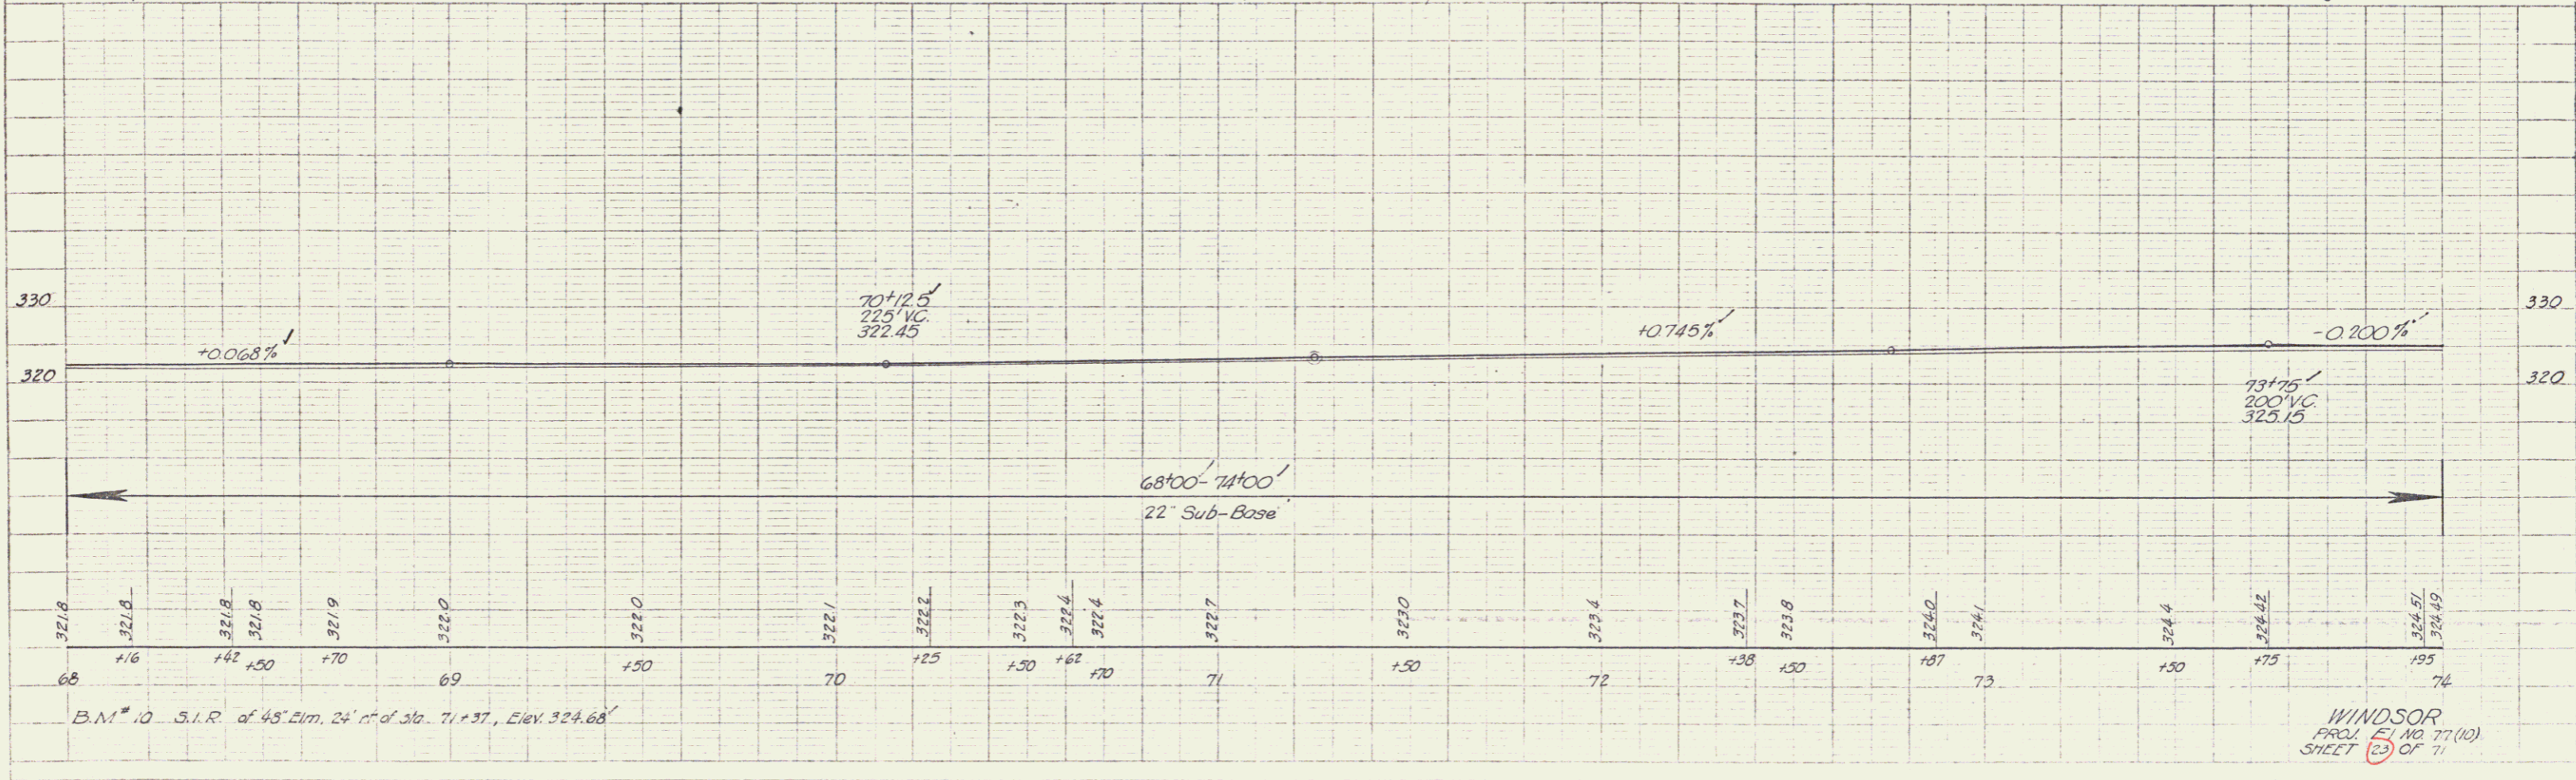


PLAN
 PREPARED BY
 DATE 1938
 TRACED
 S. Miller
 4/29

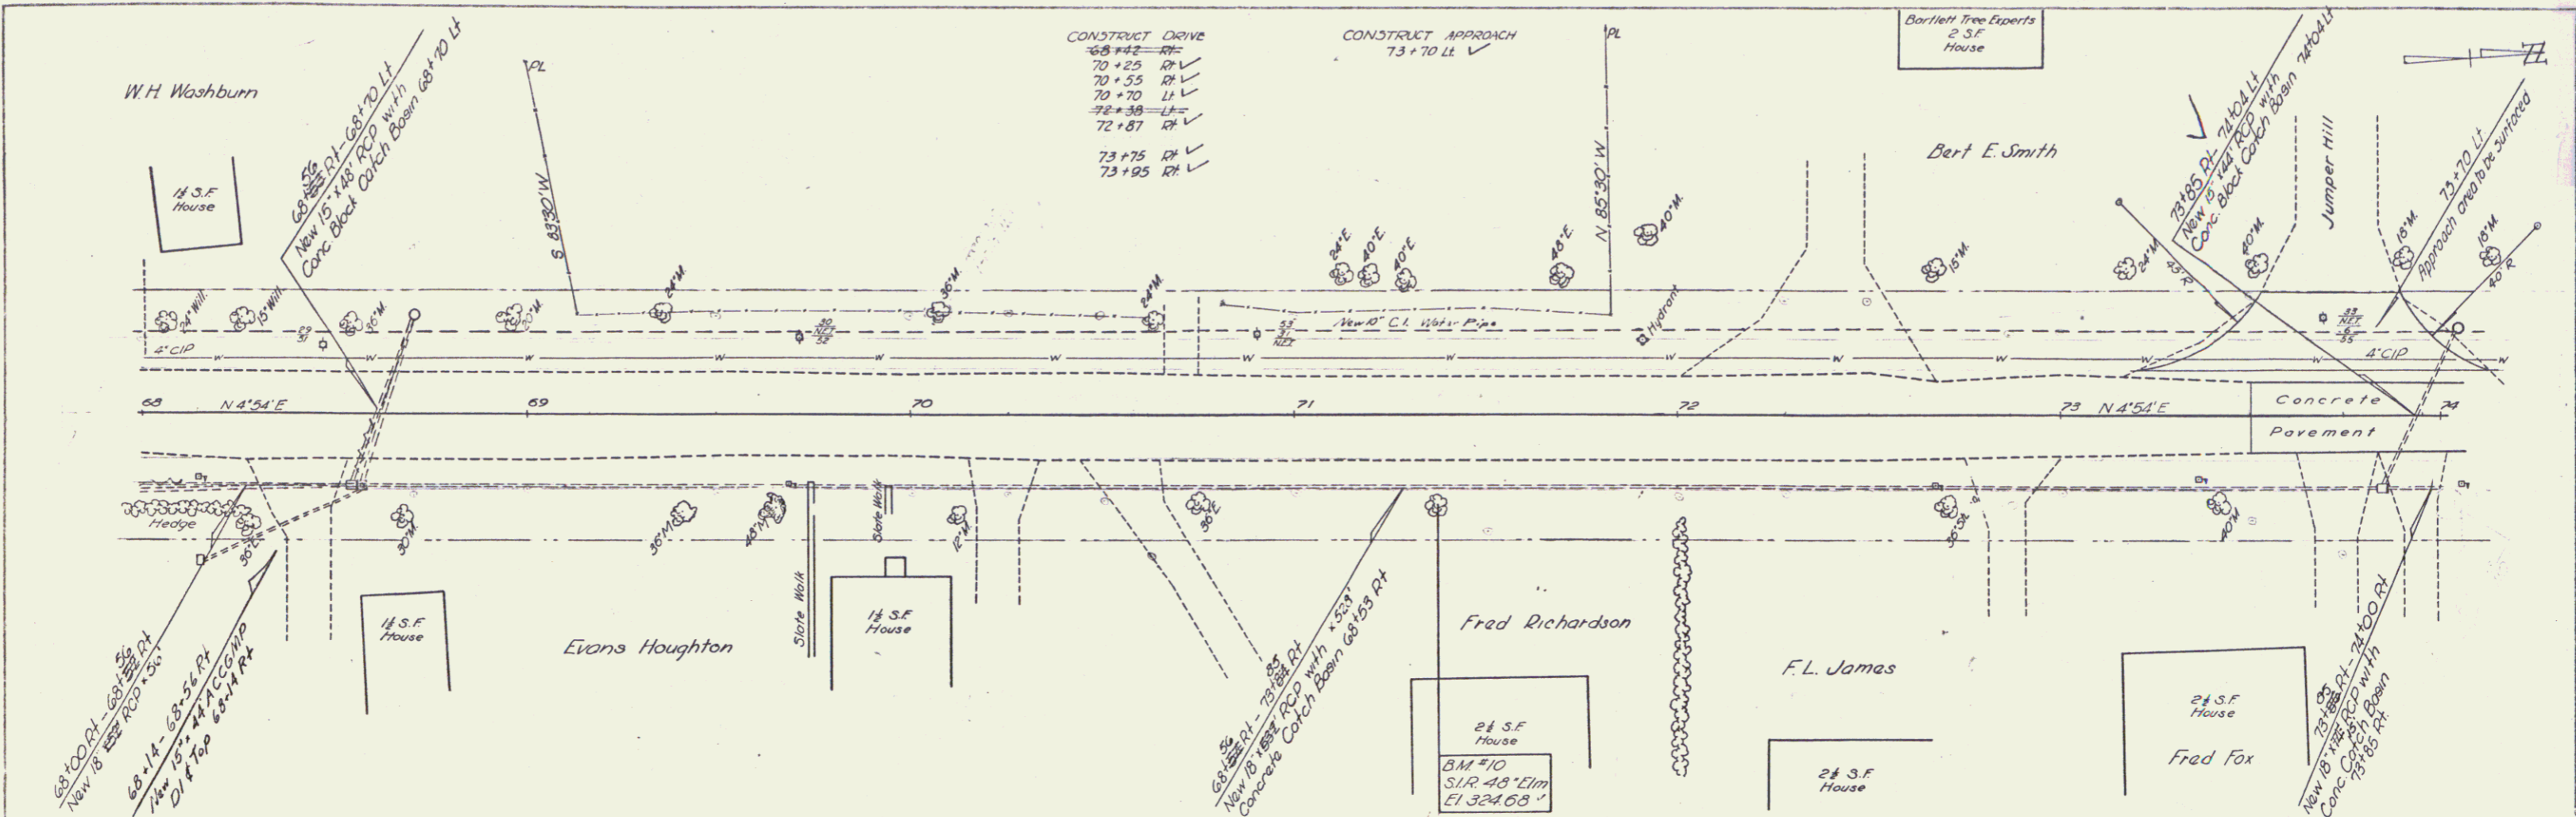

B.M. 10 S.I.R. of 45' Elm, 24' rd of Sta. 71+37, Elev. 324.68'

WINDSOR
 PROJ. 151 NO. 77 (10)
 SHEET 23 OF 71

6