
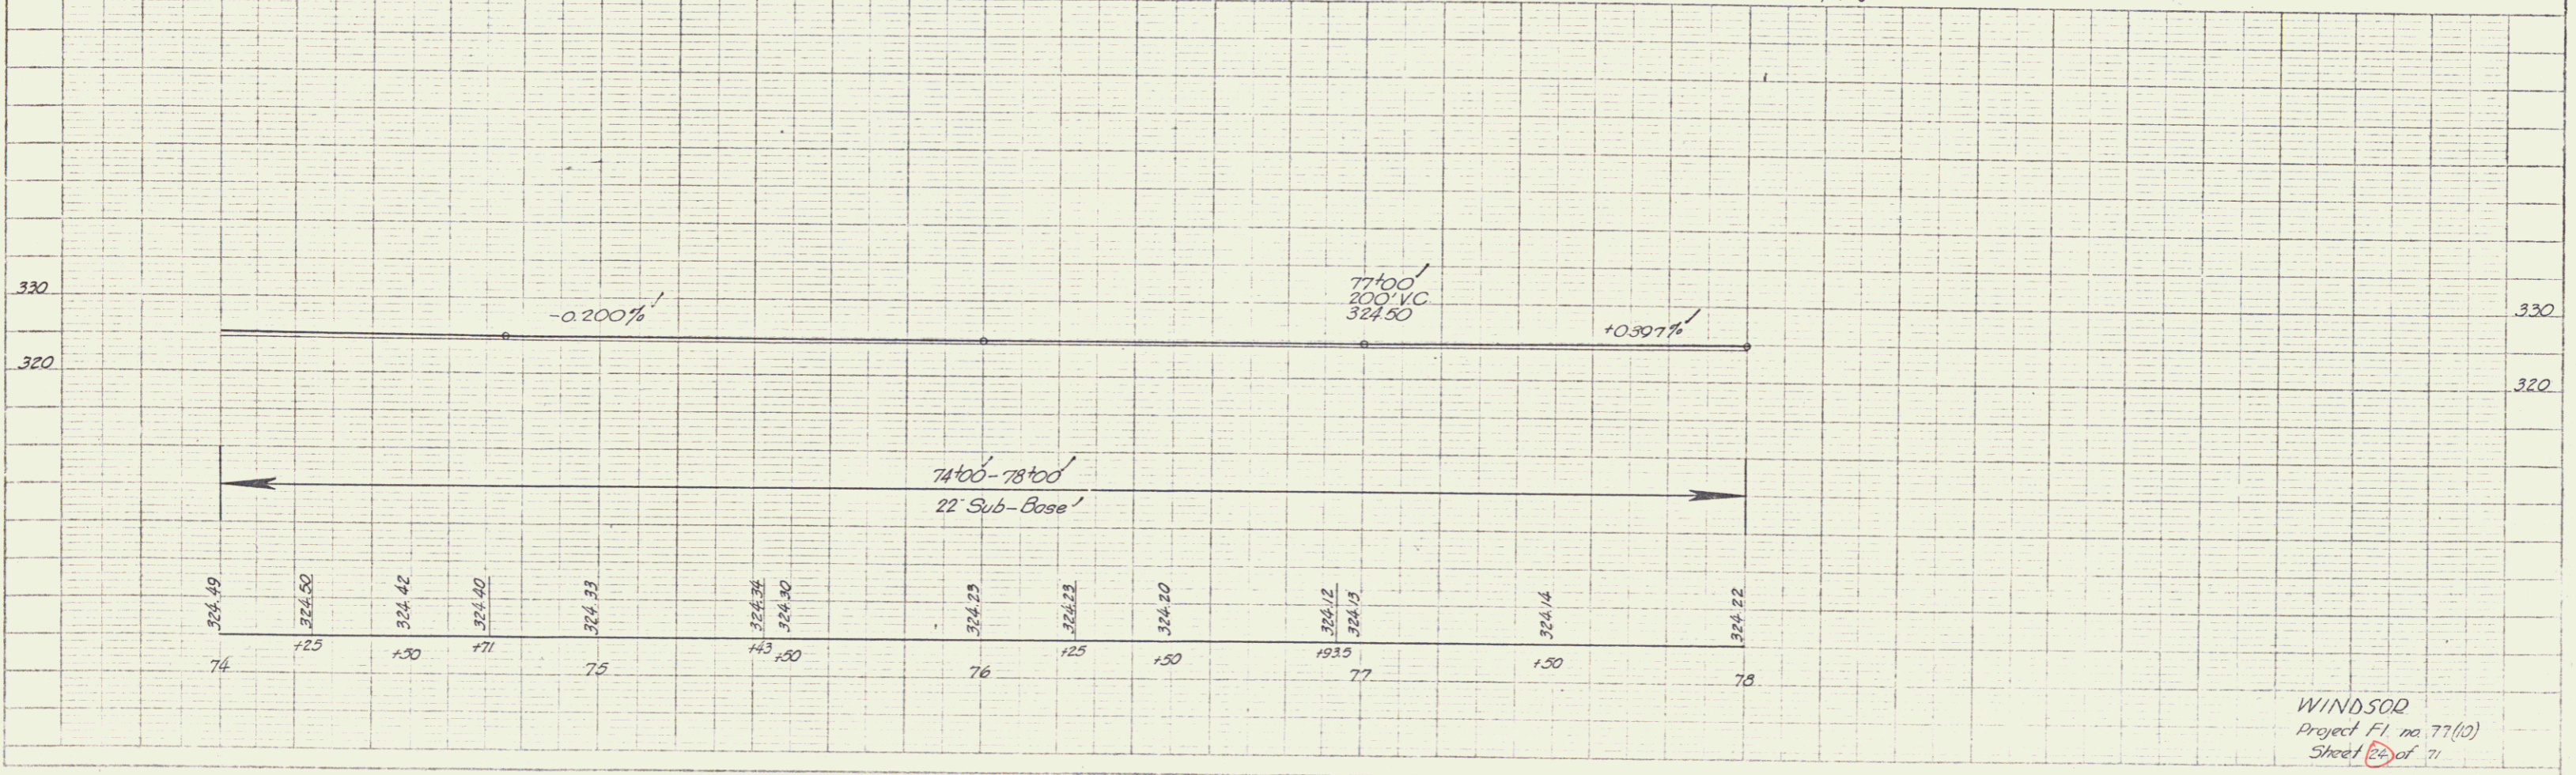


PLAN	DATE	BY
NOTE BOOK	NO.	
REVISIONS		
1		
2		
3		
4		
5		
6		
7		
8		
9		
10		

PROJ. NO.	
PROJ. NAME	
DATE	
BY	
CHECKED	
SCALE	
DATE	
BY	
CHECKED	

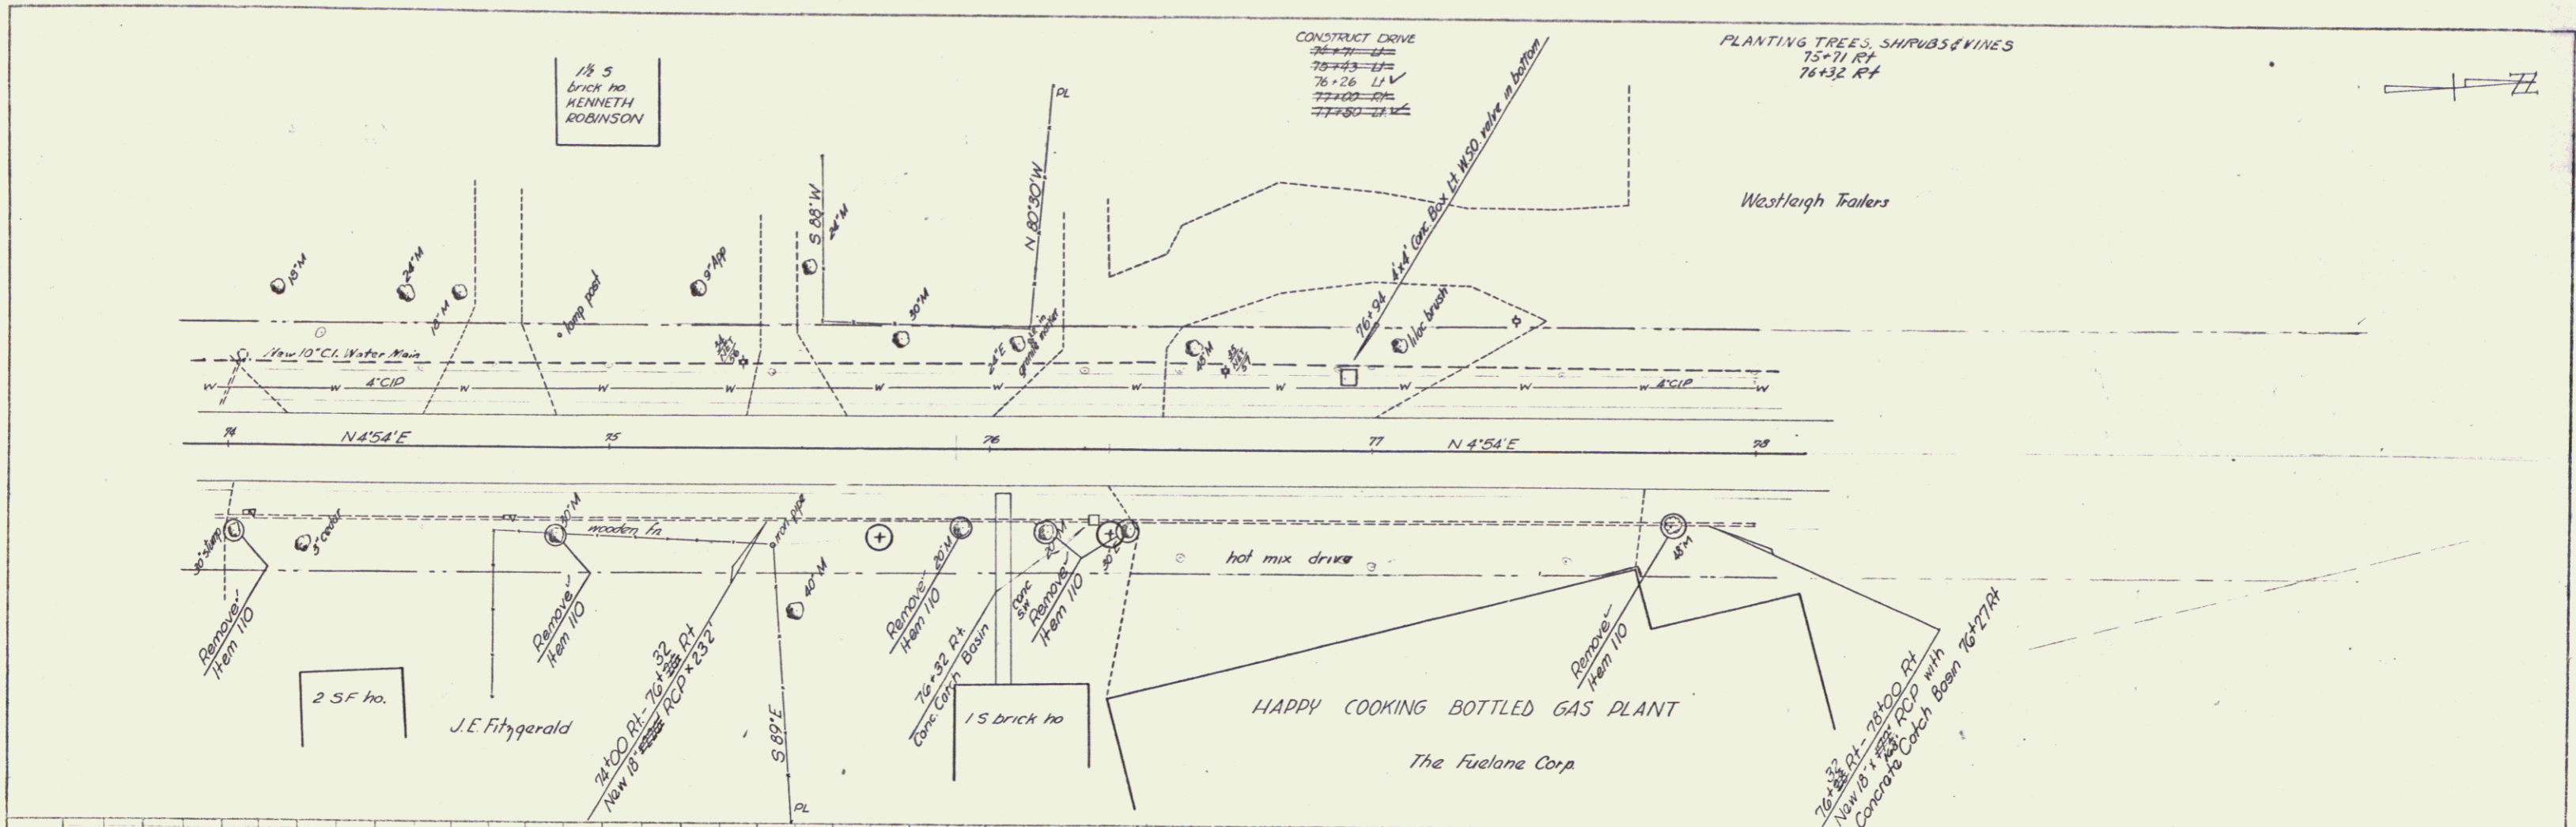

WINDSOR
Project F1 no. 77(12)
Sheet 6 of 71