



PLAN  
 DATE 1/23  
 DRAWN BY JAG  
 CHECKED BY JAG  
 SCALE 1" = 40'

PROFILE  
 DATE 1/23  
 DRAWN BY JAG  
 CHECKED BY JAG  
 SCALE 1" = 40'

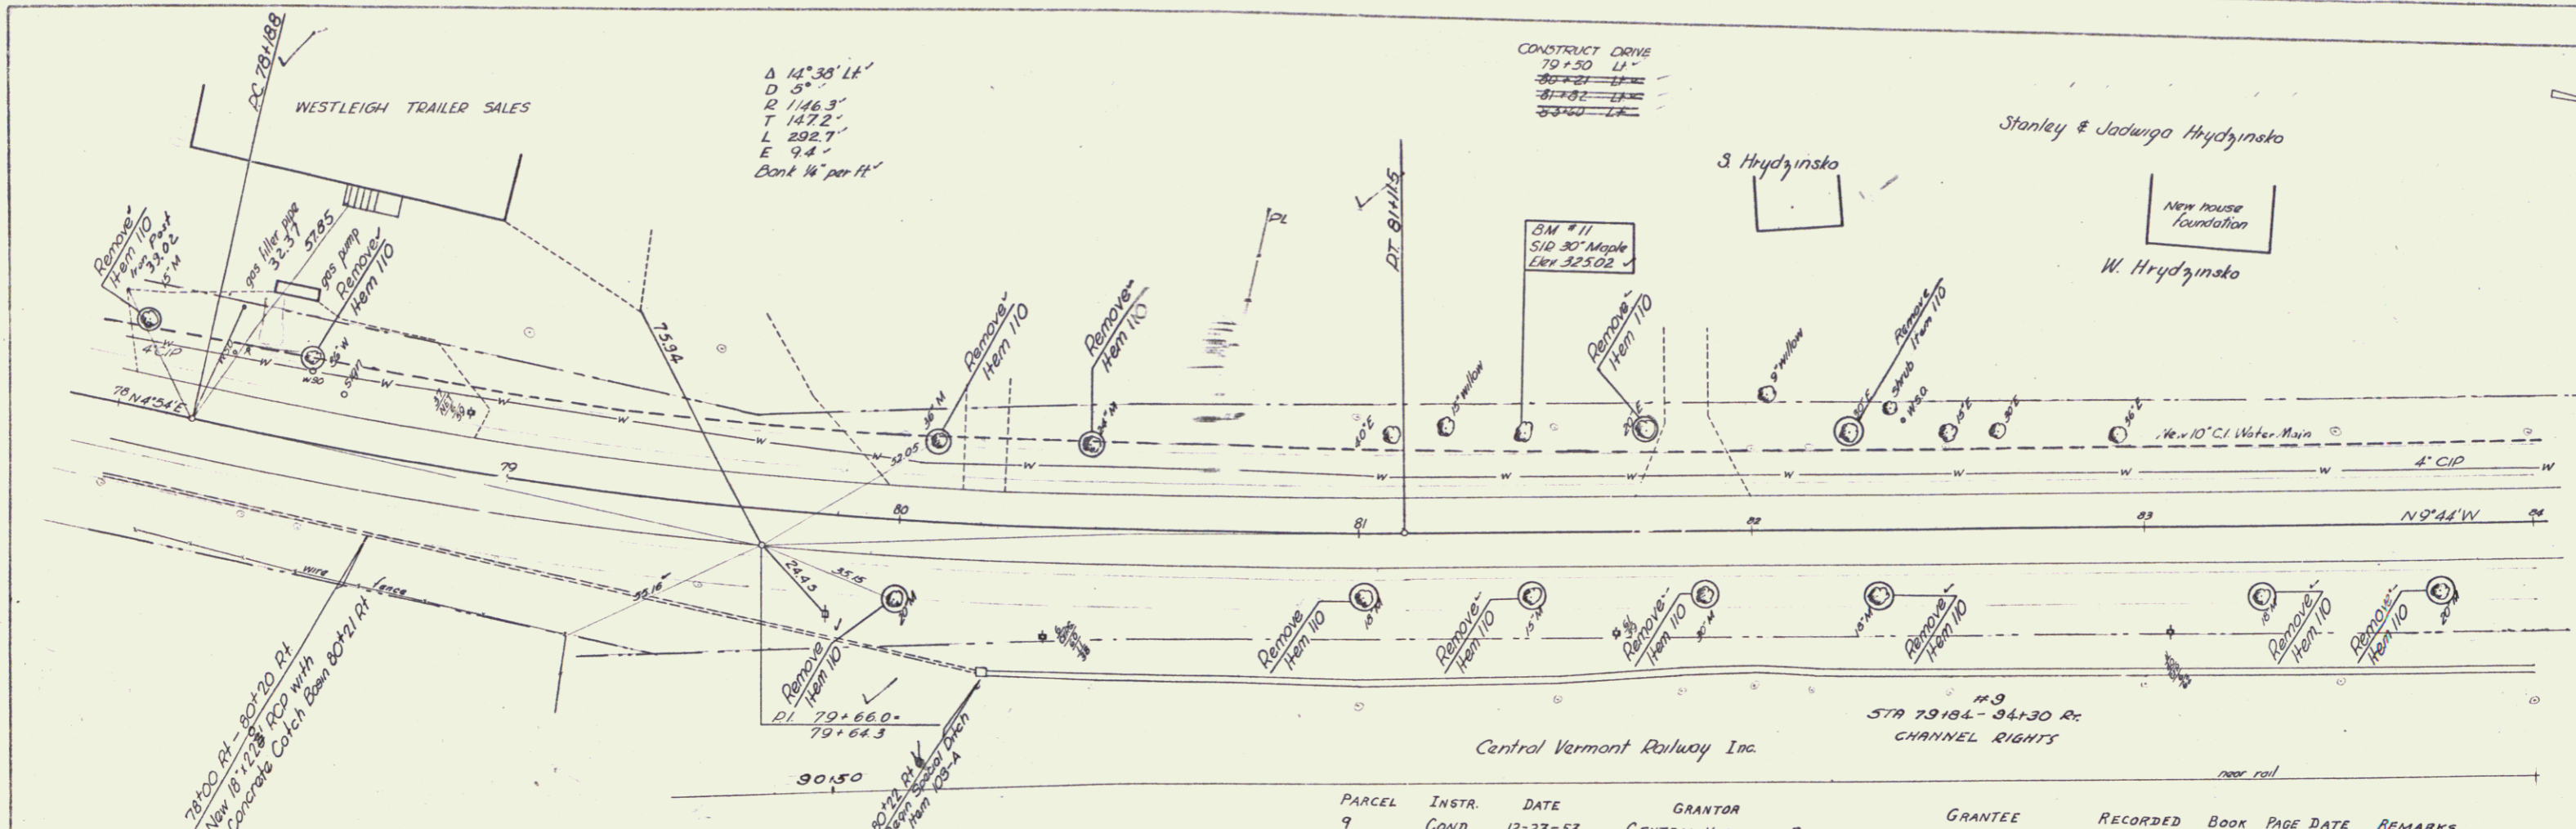

PARCEL	INSTR.	DATE	GRANTOR	GRANTEE	RECORDED	BOOK	PAGE	DATE	REMARKS
9	COND.	12-23-53	CENTRAL VERMONT RAILWAY INC.	ST. OF VT.	WINDSOR	54	208	11-12-23-53	SEE ALSO SHEET 26,27.

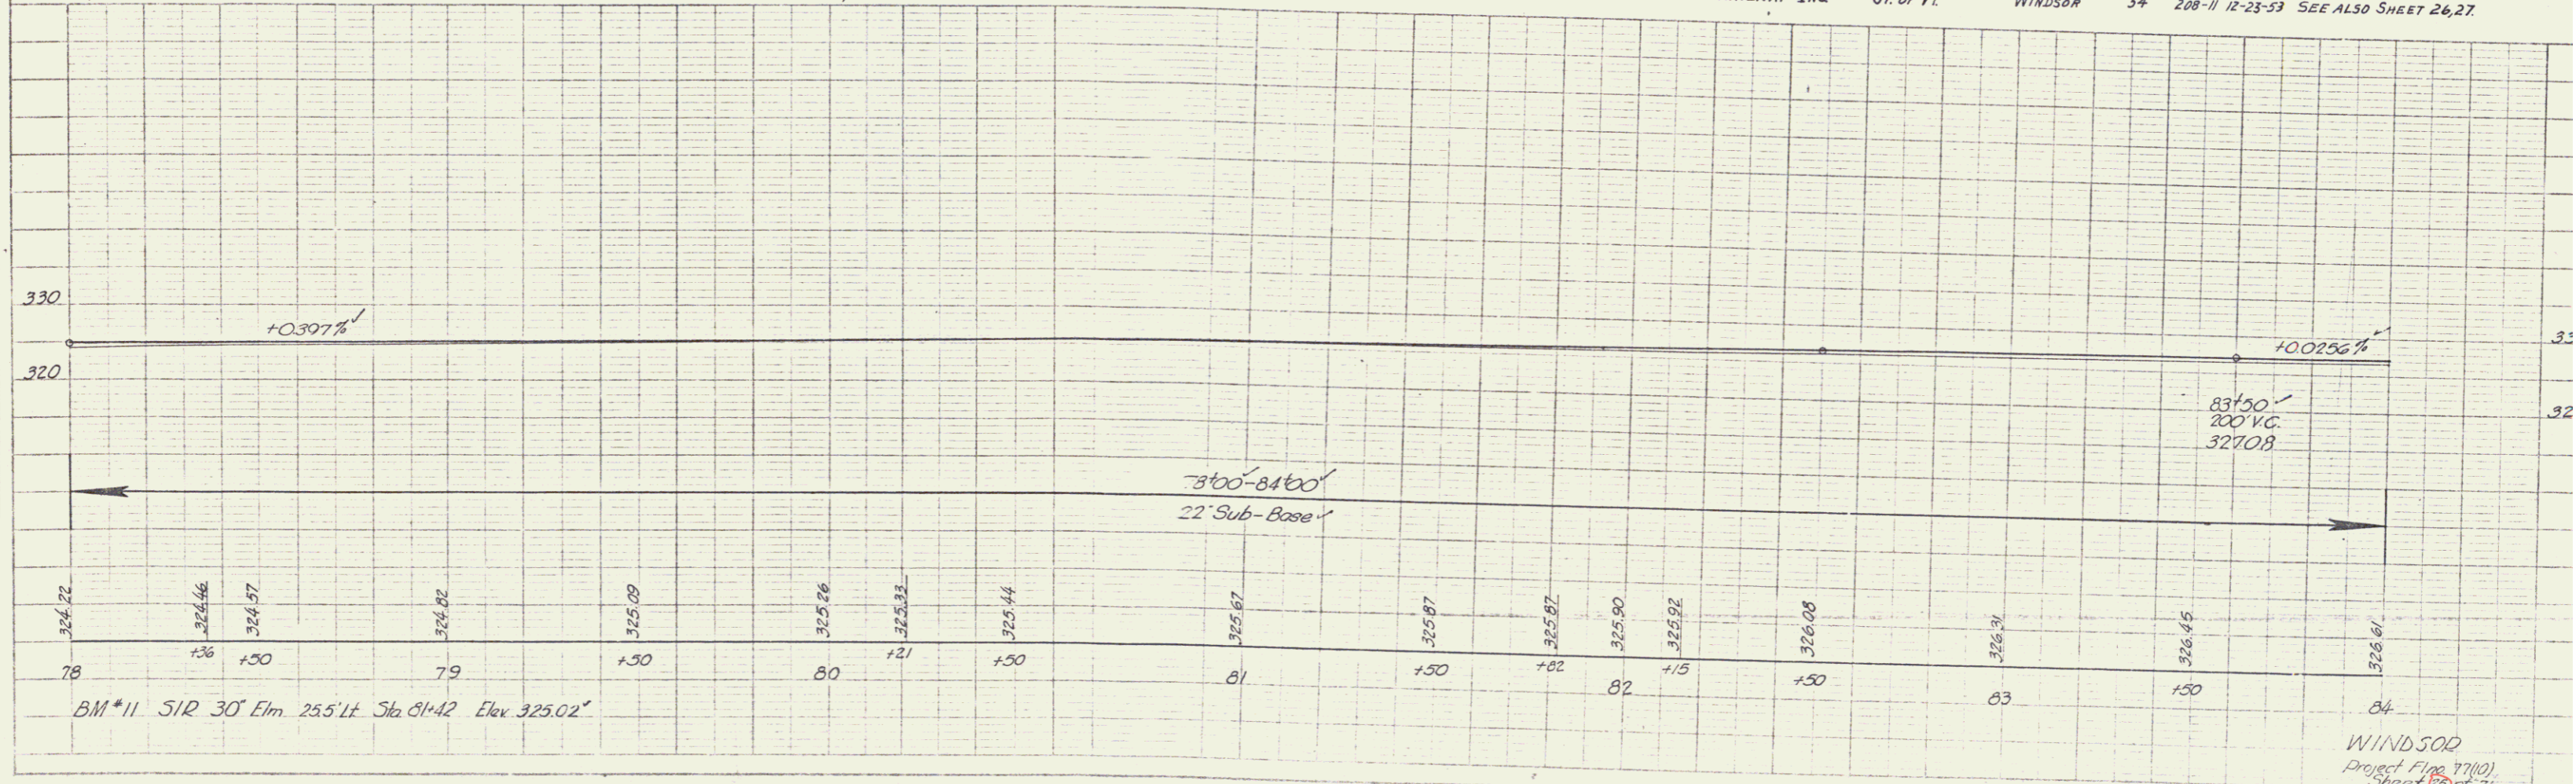

WINDSOR  
 Project File 77(10)  
 Sheet 2 of 71

8