
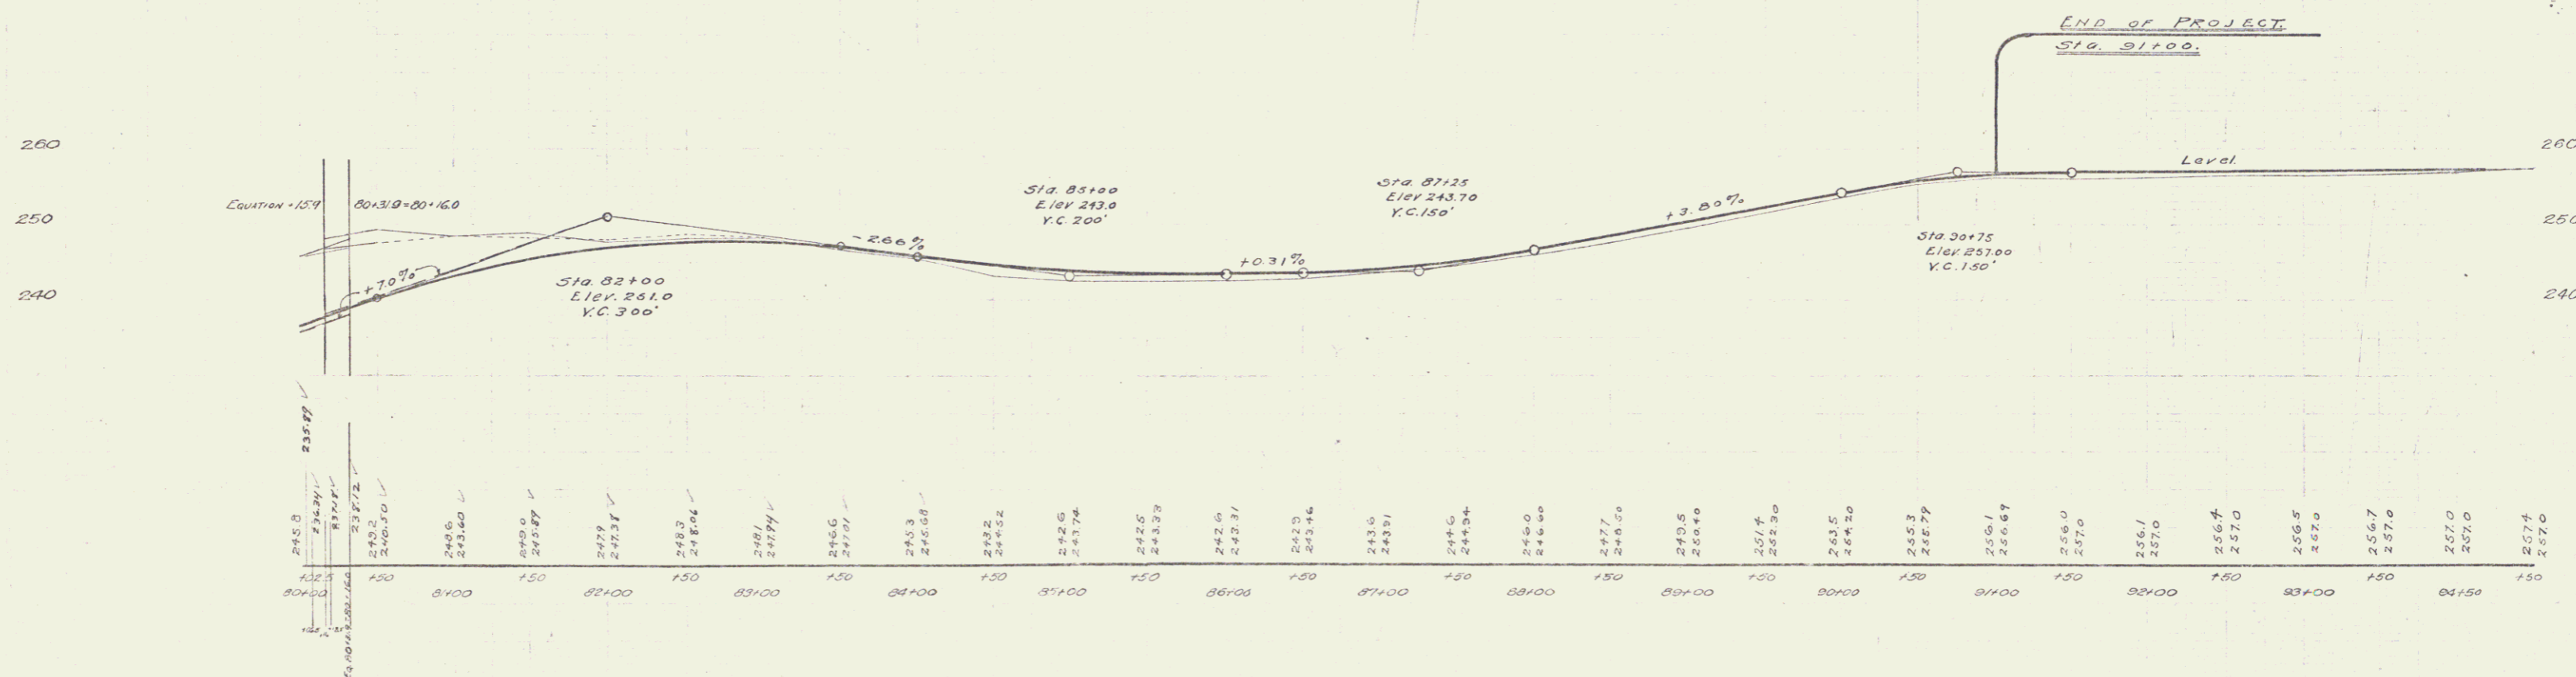


WOOD GUARD RAIL REQUIRED.
LEFT
STA. 85+87 to STA. 85+81 = 24 FT.
TOTAL THIS SHEET 24 FT.

CABLE GUARD RAIL REQUIRED.
RIGHT
STA. 85+24 to 86+82 = 108 FT.
TOTAL THIS SHEET 108 FT.

NEW CULVERTS REQUIRED.
STA. 85+69 - 30" RING CONC PIPE, LENGTH 52 FT.
REINFORCING STEEL 66 LBS.
CONCRETE (CLASS R2) 3.8 CU YD.

FED. ROAD DIST. NO.	STATE	FED. AID PROJ. NO.	FISCAL YEAR	SHEET NO.	TOTAL SHEETS
3	VT	77-C	1927	6	

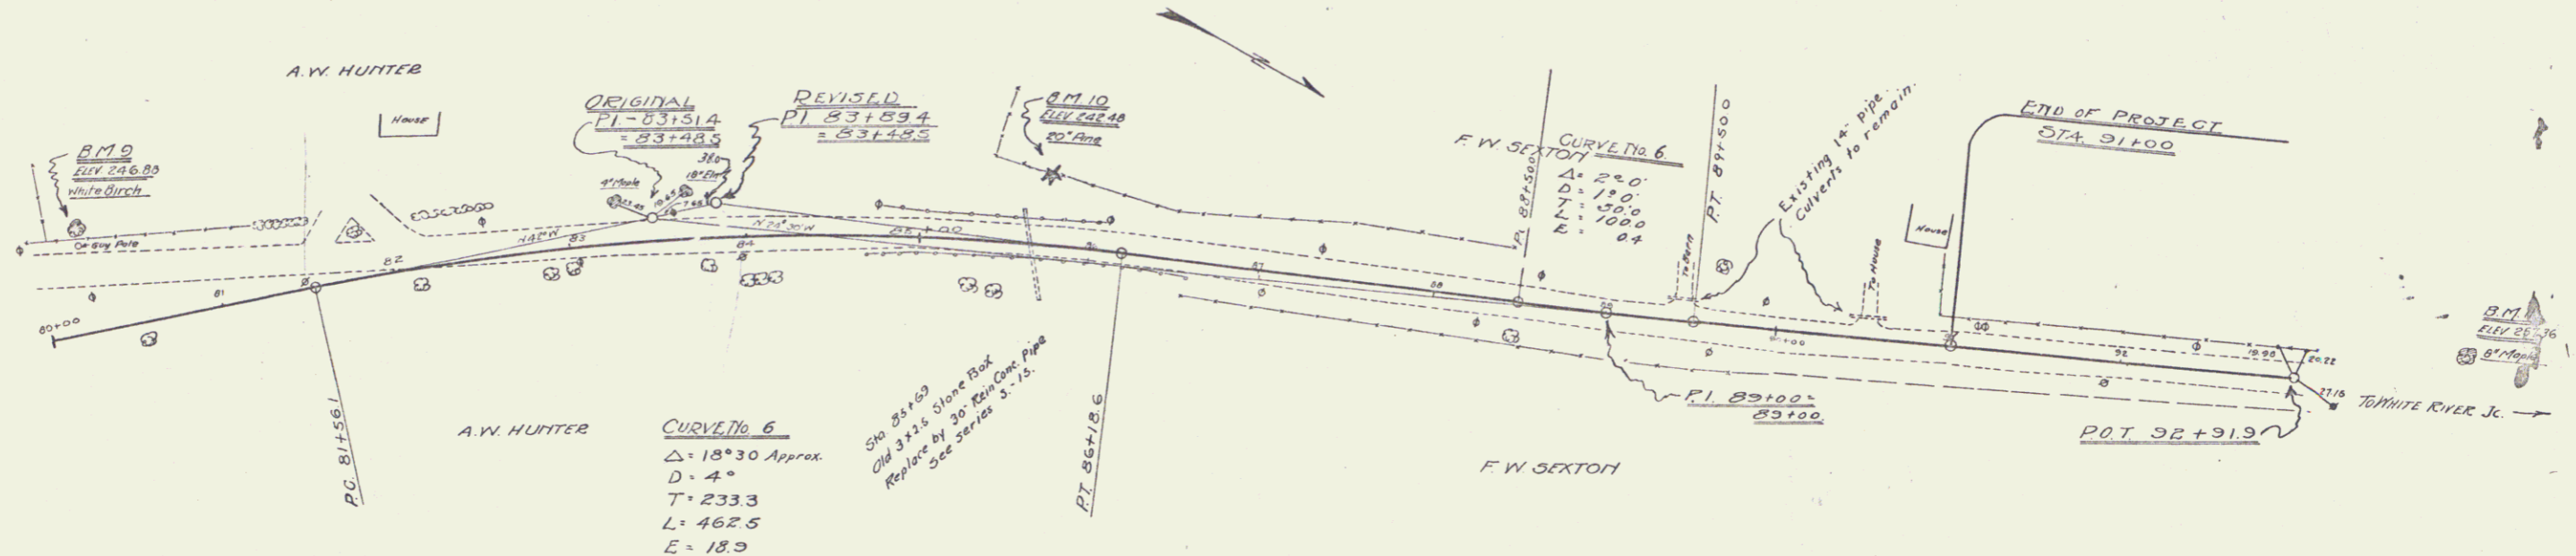

B.M. 10 - CORNER IN WHITE BIRCH LEFT STA. 80+35 - ELEV. 248.66
 B.M. 11 - CORNER IN WHITE BIRCH LEFT STA. 80+15 - ELEV. 248.66
 B.M. 12 - CORNER IN WHITE BIRCH LEFT STA. 80+15 - ELEV. 248.66
 B.M. 13 - CORNER IN WHITE BIRCH LEFT STA. 80+15 - ELEV. 248.66
 B.M. 100 - CORNER IN WHITE BIRCH LEFT STA. 80+15 - ELEV. 248.66

Series F, No. 71C
 Sheet 6 of 11

5