

81+50
 82+00
 83+50
 86+25
 89+60
 90+60

85+74 (Rise) 30" RCP (Left) to Pit
 New 30" Existing D.I. into Conc. Cover to Pit
 Box - Constructed at Point

P L
 DOWNWOOD
 SMITH

P L

New 15" x 10" GRCP, (1060")
 81+30 - 82+30 (1060")
 CARLETON SMITH
 P.L. 80+25.50

50" GRCP, (1064")

MATCH LINE


11

2 Sty. W.F. House

P.L. 83+96.17 =
 83+91.80

B.M. #6
 Elev. 469.84
 S.I.R. 48" Pine

86+25
 New 15"

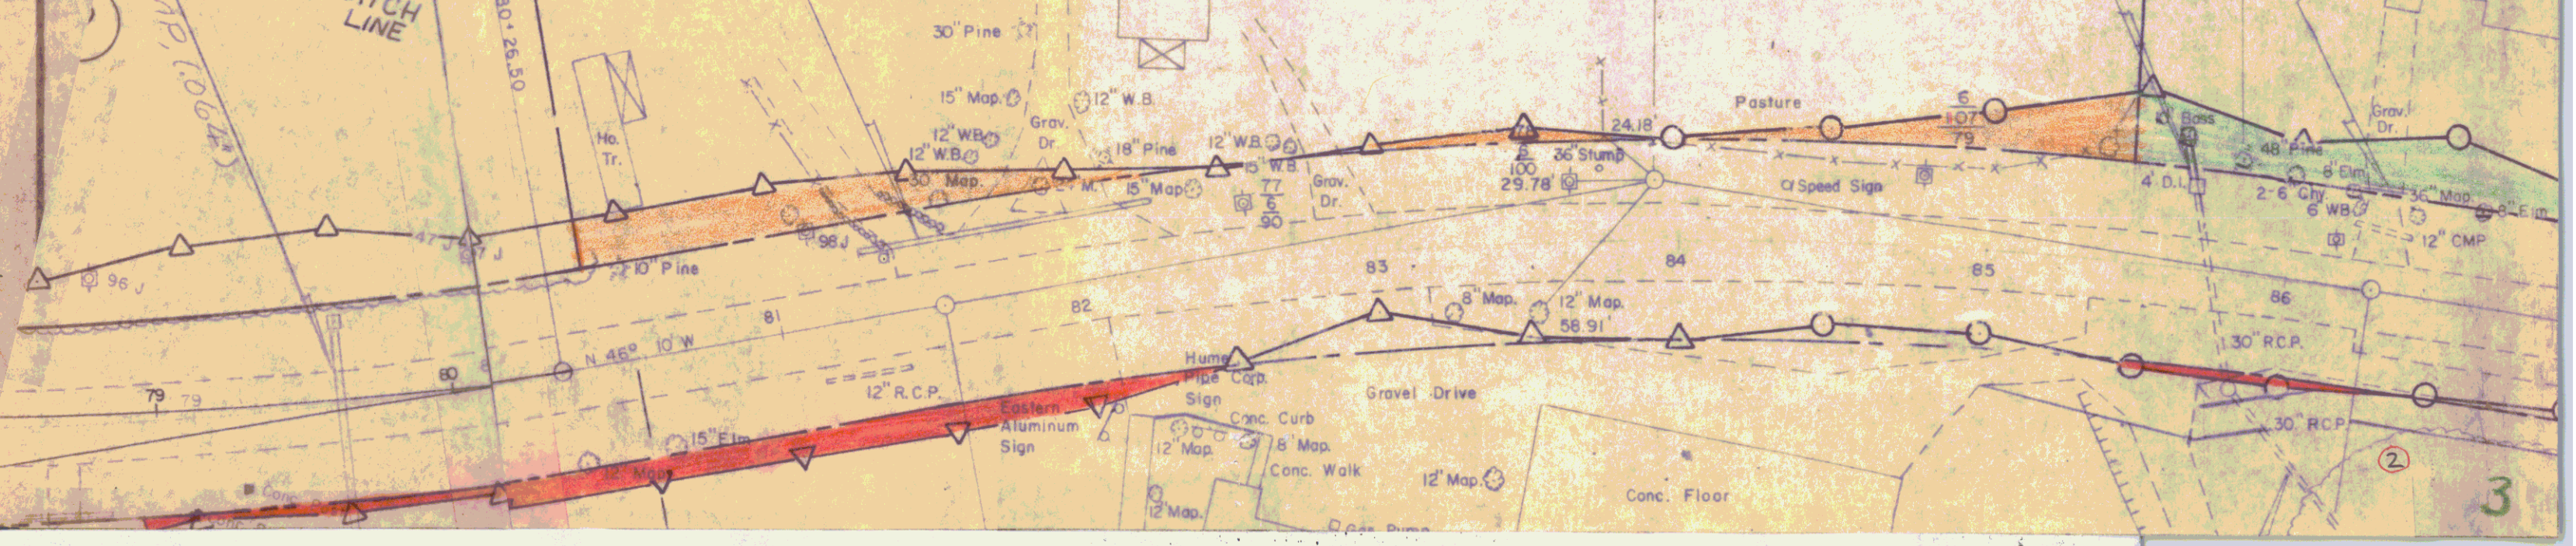

3