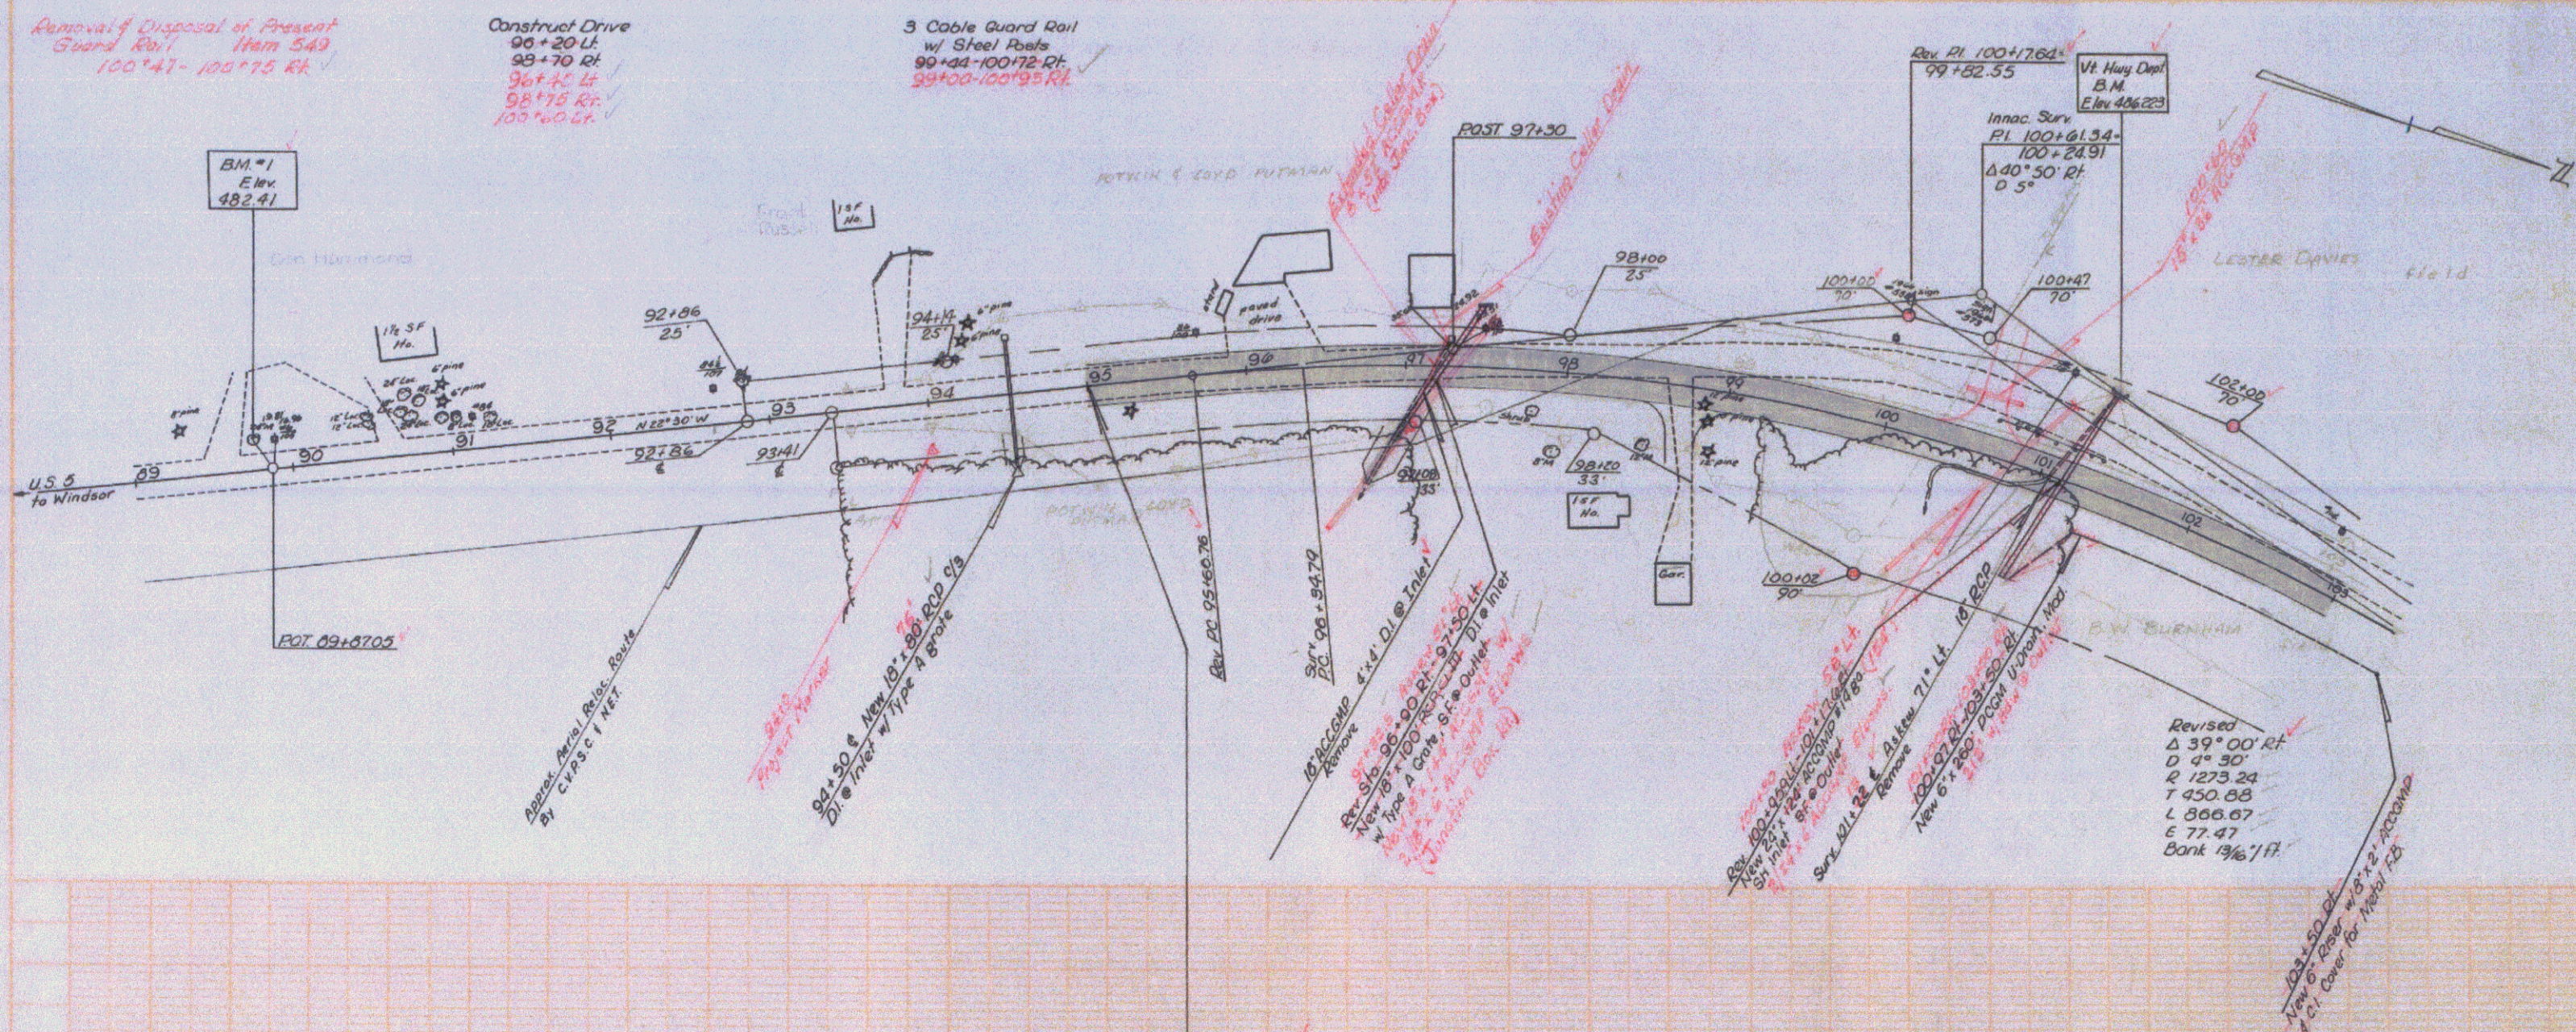


WINDSOR
BP 041-2-6704
Sheet (9) of 57 Sheets