

POOR ORIGINAL COPY

**WOOD GUARD RAIL REQUIRED**

Station	Left	Right
320145	24 ft	
320150	24 ft	


**SABLE GUARD RAIL REQUIRED**

Station	Left	Right
320150-320120	48 ft	
320126-320180	144 ft	
320190	48 ft	

**NEW HEAVY CONC. BOX CULVERTS REQUIRED**

Station	Size	Comp. A	Steel	DI	Per Collar
320150	4'x4'	29.704	1978		
320156	3'x3'	10.7	754		

77-G 1930 7 67

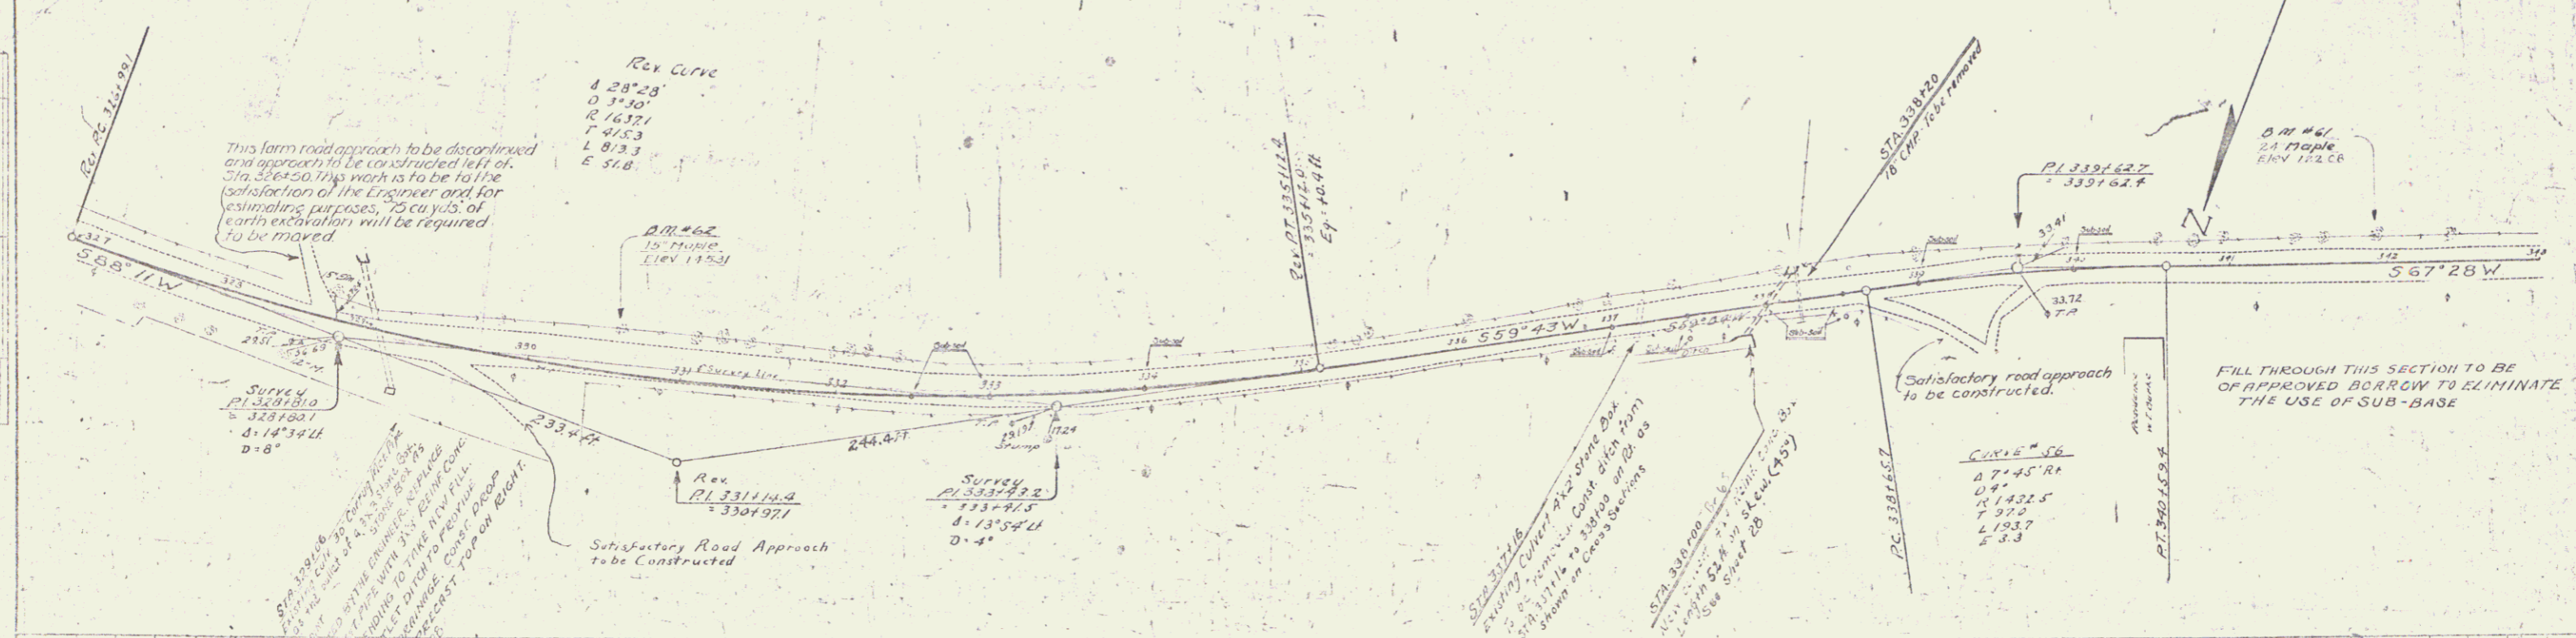

DATE	BY	CHKD.
12/1/57	J. J. [unclear]	[unclear]
12/1/57	[unclear]	[unclear]

DATE	BY	CHKD.
12/1/57	[unclear]	[unclear]
12/1/57	[unclear]	[unclear]