


POOR ORIGINAL COPY

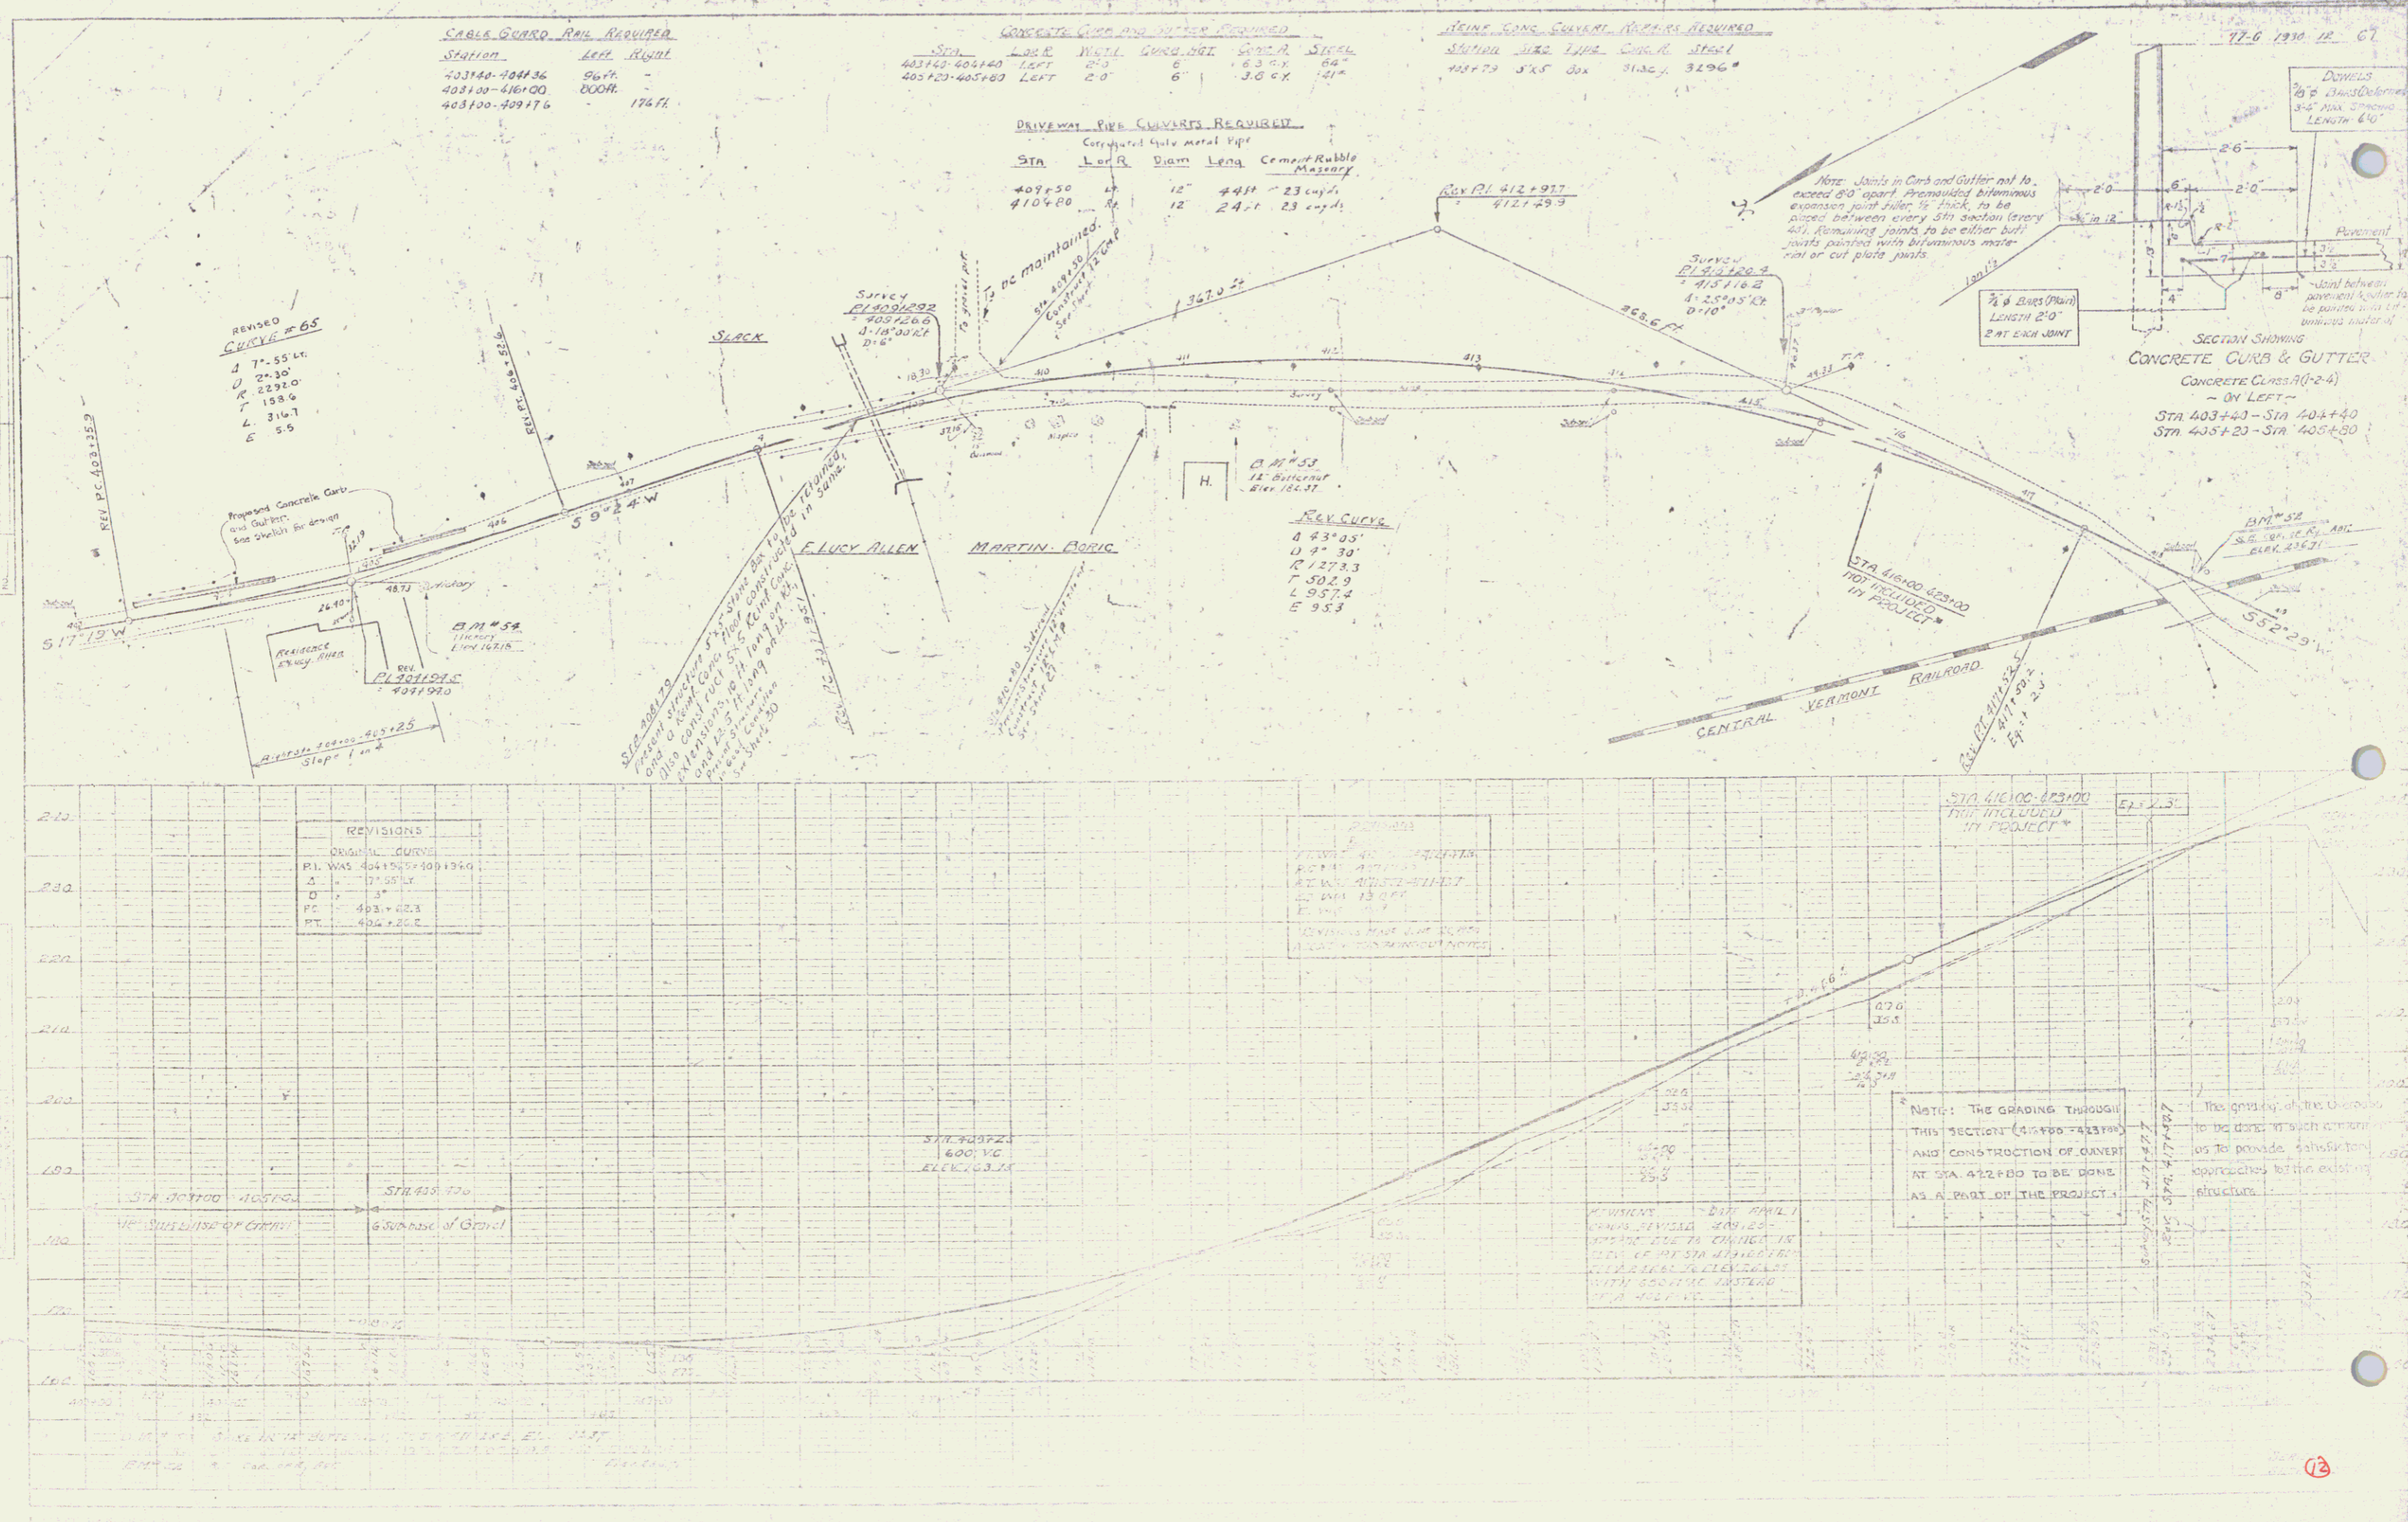

13

9