


POOR ORIGINAL COPY

WOOD GUARD RAIL REQUIRED	CABLE GUARD RAIL REQUIRED	NEW GUARD RAIL SIDEWAY REQUIRED	PROPOSED CRUTCH CABLE CUTTER	STEEL CING. CURREST BARRIERS REQUIRED												
Station	Left	Right	Station	Left	Right	Station	Left	Right	Station	Left	Right	Station	Left	Right		
421100	✓	24' 21"	421124-421180	156 ft		421100	10'	44'	180y	57"	12y 1'	421100	3'x4	Box	12.30y	278"
			421130-421100	120 ft												
			421176-421132	56 ft												

WOOD GUARD POSTS REQUIRED

Station	Left	Right
425134	10"	

77-G 1936 13 67

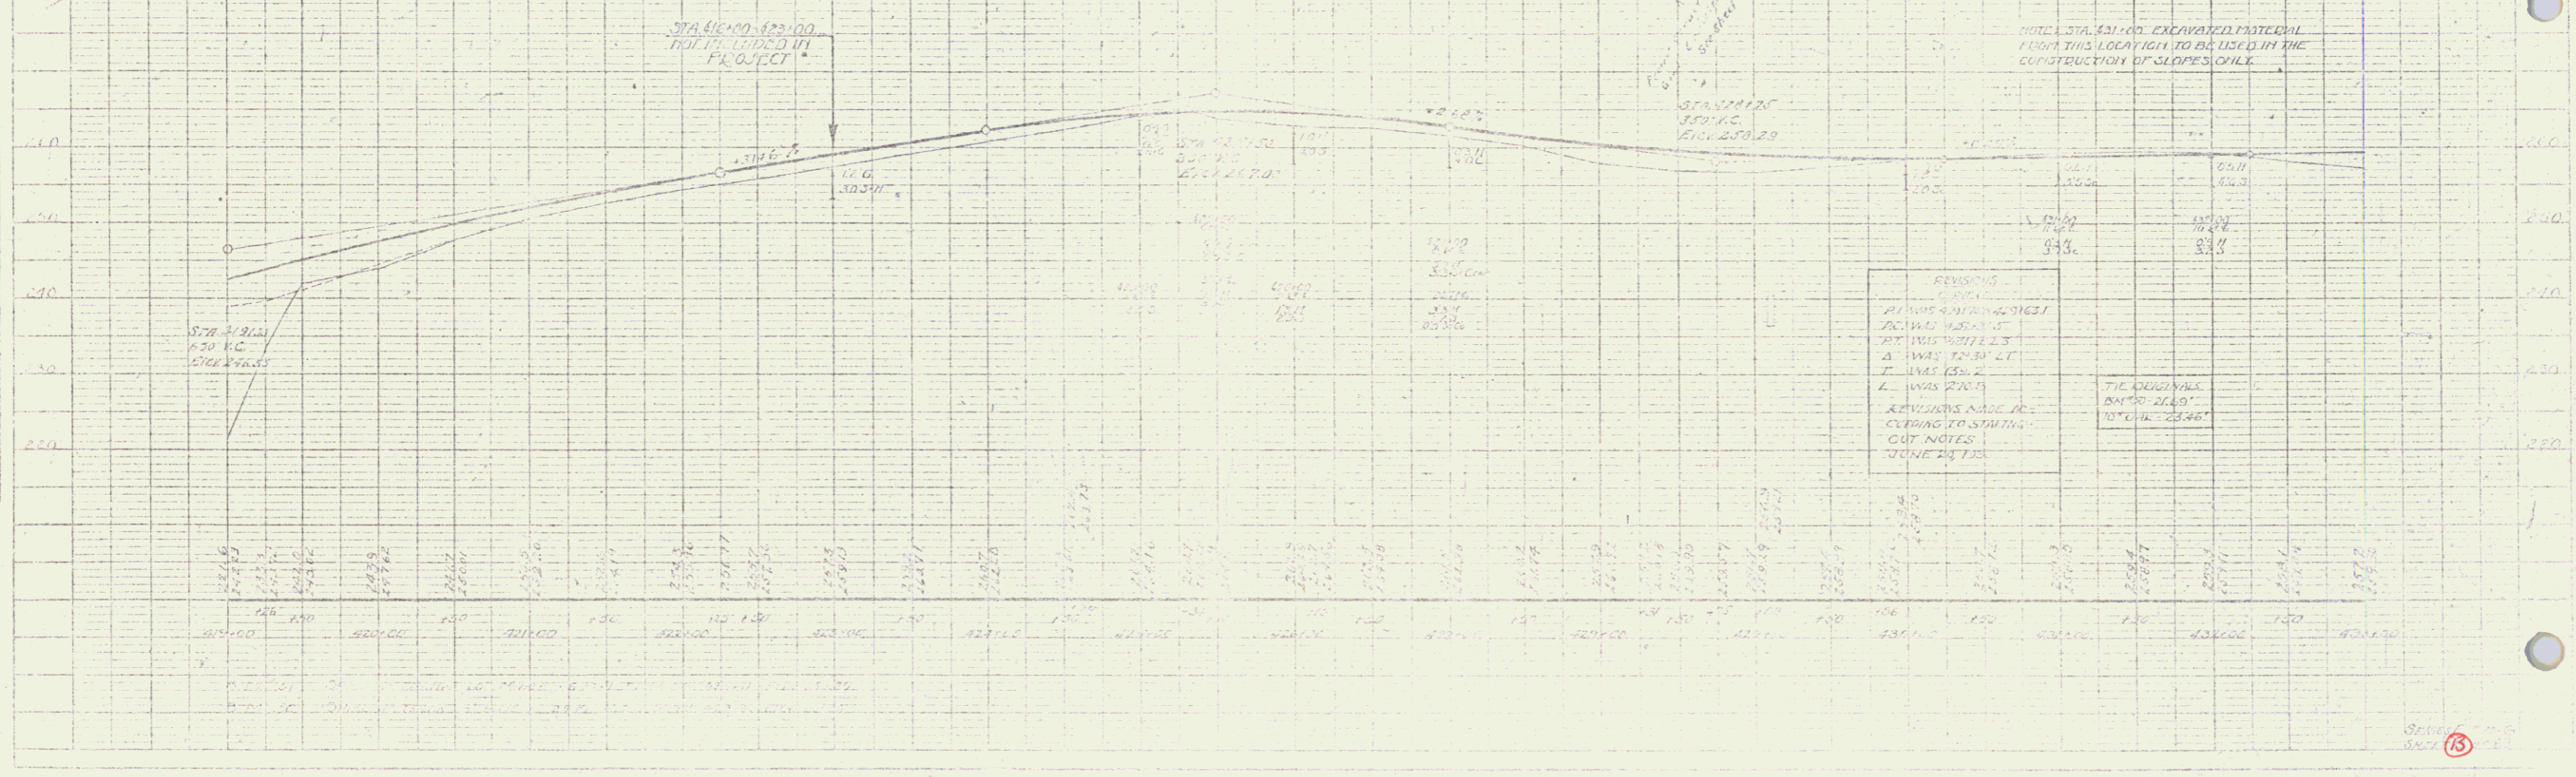

REVISIONS

- 1. AS SHOWN
- 2. AS SHOWN
- 3. AS SHOWN
THE ORIGINAL ON 10-26-36

REVISED AS SHOWN ON 10-26-36

OUT NOTES

JUNE 24 1936

13

11