


Δ - 73° 41' Lt.  
D - 18°  
R - 318.3  
T - 236.3  
L - 406.6  
E - 78.1  
P.C. 536+35.0  
P.T. 540+41.6

(To Be Returned To R.O.M. Division)  
Town of  
US-5  
PERPETUAL  
R.O.M. FILE  
RIGHT-OF-WAY DIVISION  
M.P. 1.60

*Handwritten notes:*  
near front  
Backfill  
1-3-79  
the back log  
Dillon

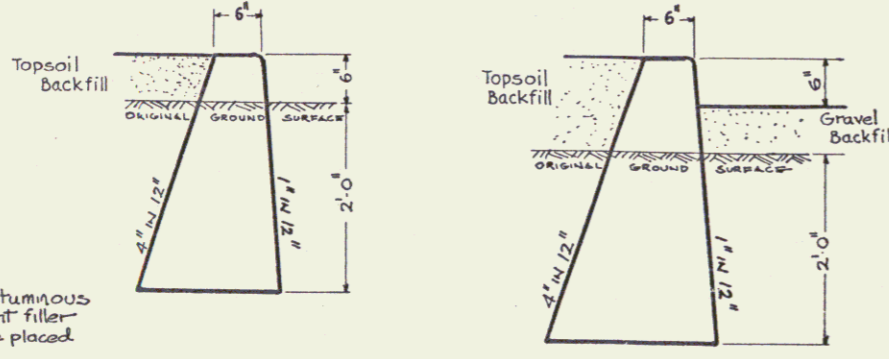

DETAILS of CONCRETE CURB  
SCALE: 1" = 1 FT.

6-2-76