

WOOD BOARD ARE REQUIRED

STATION	LEFT	RIGHT
576100	24.8	24.8

CABLE GUARD RAIL REQUIRED

STATION	LEFT	RIGHT
576172-580100	318.8	
576160-579196	136.8	

NEW REINFORCED CONCRETE PIPE CONCRETE REQUIRED

STATION	PIPE DIA.	CONC. STEEL
576100	18"	40# 30cy 33#

NEW REINFORCED CONCRETE BOX CONCRETE REQUIRED

STATION	SIZE	CONC.	STEEL
579125	4'x3'	39.7cy	3# 30#

GRADED COBBLE GUTTER REQUIRED

STATIONS	LEAK	WIDTH	LENGTH	AREA
576125-576135	3.0"	3.0"	110.0'	360 sq ft
577135-578108	3.0"	3.0"	705.1'	233.7 sq ft

Delivery Pipe Culverts Required


Station	Length	Width	Depth	Area	D.I.S. #
576125	12'	36"	12"	1	
580175	12'	24"	12"	2	

Cement/Pavement Material

Material	Quantity
12" cy	12 cy
4.3 cy	4.3 cy

77.6 1938 23 67

PLAN
DATE: 10/15/50
SCALE: AS SHOWN
PROJECT: BRIDGE
DRAWN BY: [Name]
CHECKED BY: [Name]

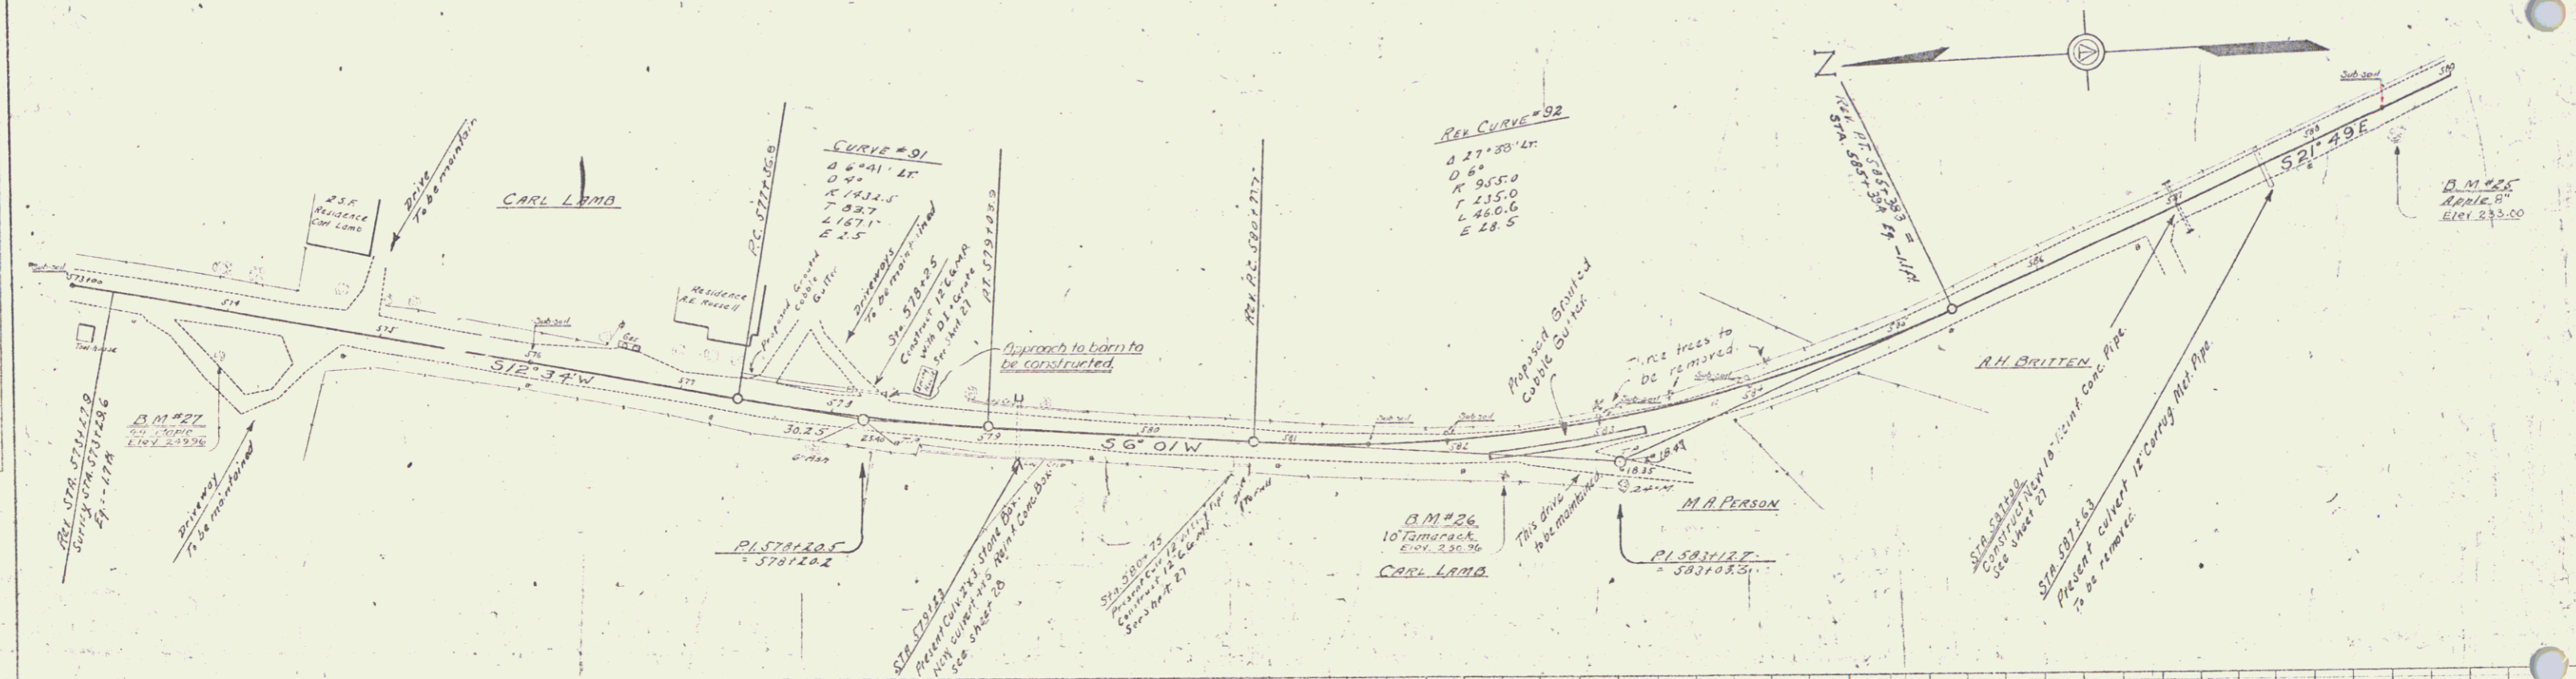


REVISIONS

REV.	DATE	BY	DESCRIPTION
1	10/15/50	[Name]	Initial drawing
2	10/15/50	[Name]	Revisions made June 20, 1950 according to staking out notes

GRADE REVISIONS

Station	Length	Elev.
583100	250' VC	250.00

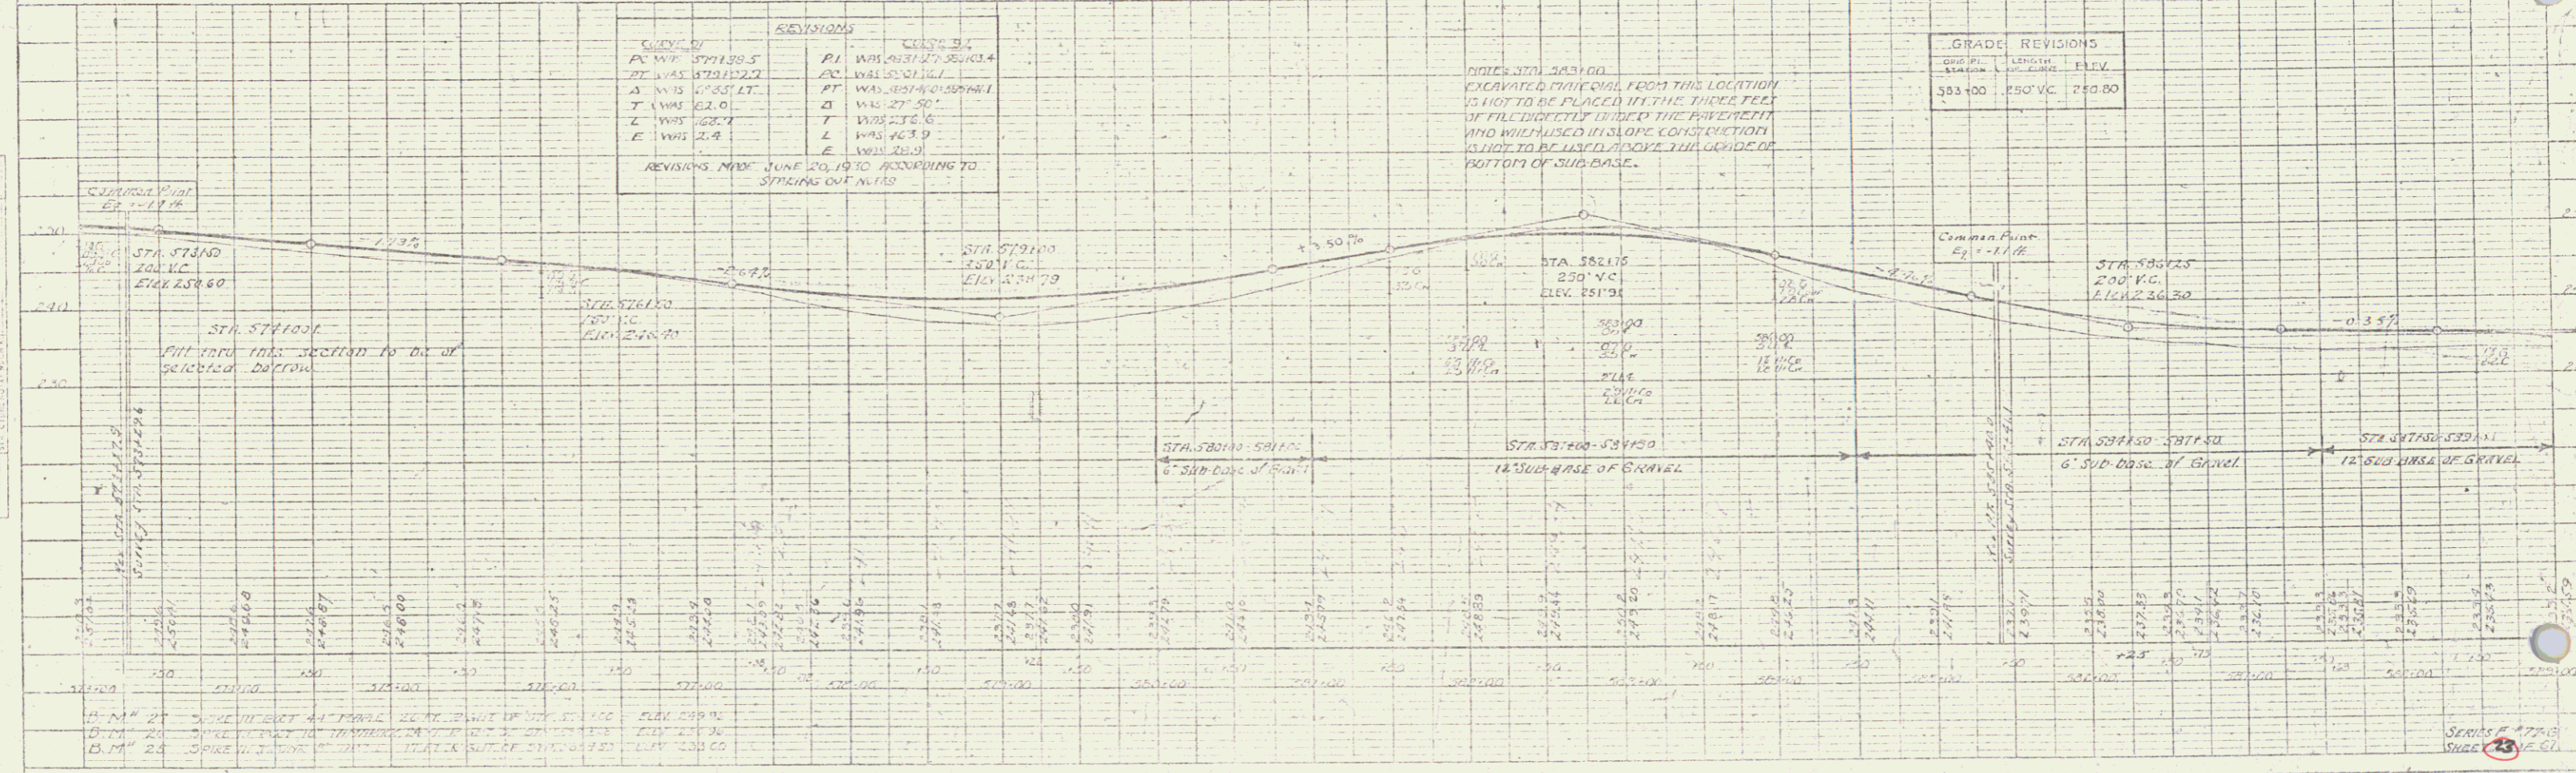

NOTE: INTERSECT ALL PARALLEL TO THE CENTERLINE OF THE ROAD AND ALL OTHER LINES TO BE SHOWN IN THE PLAN VIEW.

SERIES # 477-6
SCALE 1" = 40'