
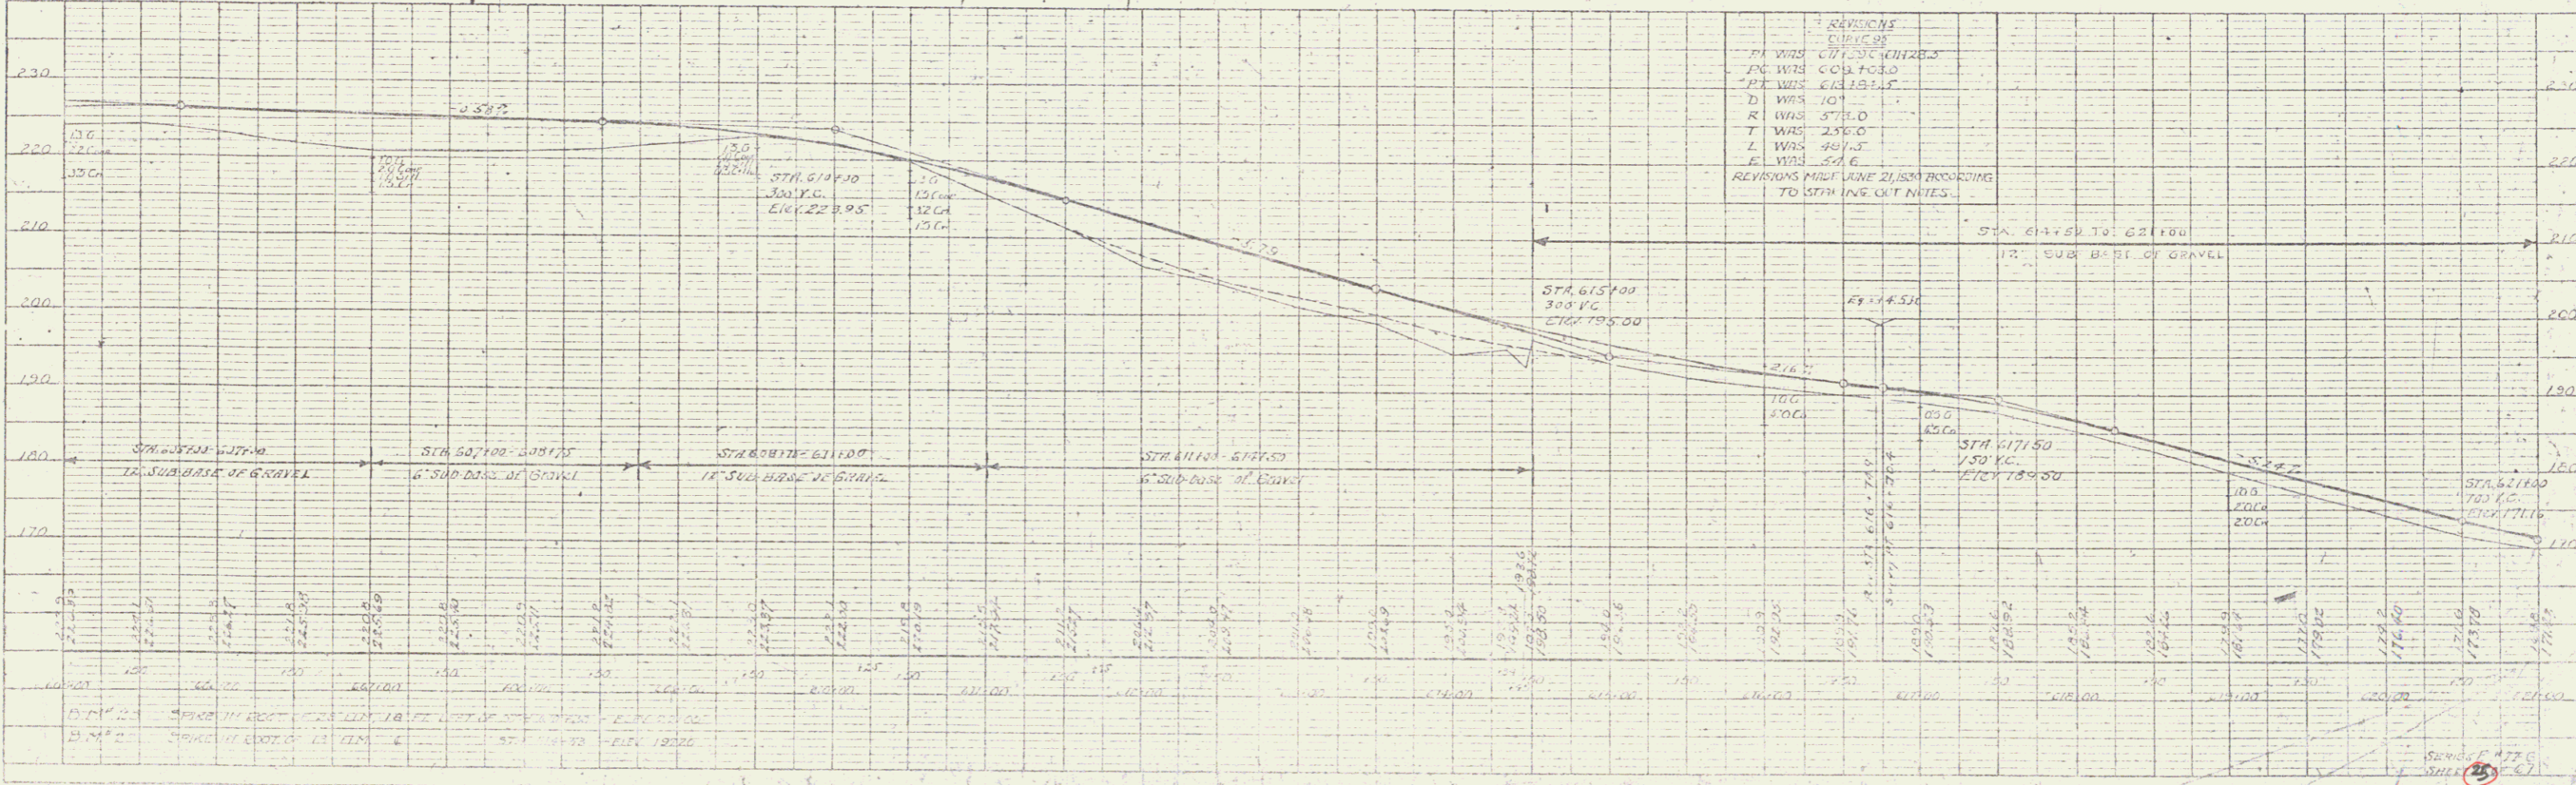


WOOD GUARD RAIL REQUIRED		CABLE GUARD RAIL REQUIRED		NEW PAINE CONC. PIPE CULVERTS REQUIRED						
Station	Left	Right	Station	Left	Right	Station	Diag.	20% Conc.	Steel Conc. A	
6071.50	24 H.	24 H.	6114.8-6141.2	34 H.	-	6071.50	15'	48 H.	23 Cy.	33"
6141.50	24 H.	24 H.				6141.45	15'	52 H.	54	16 Cy.

T.T.C. 1230 25 67

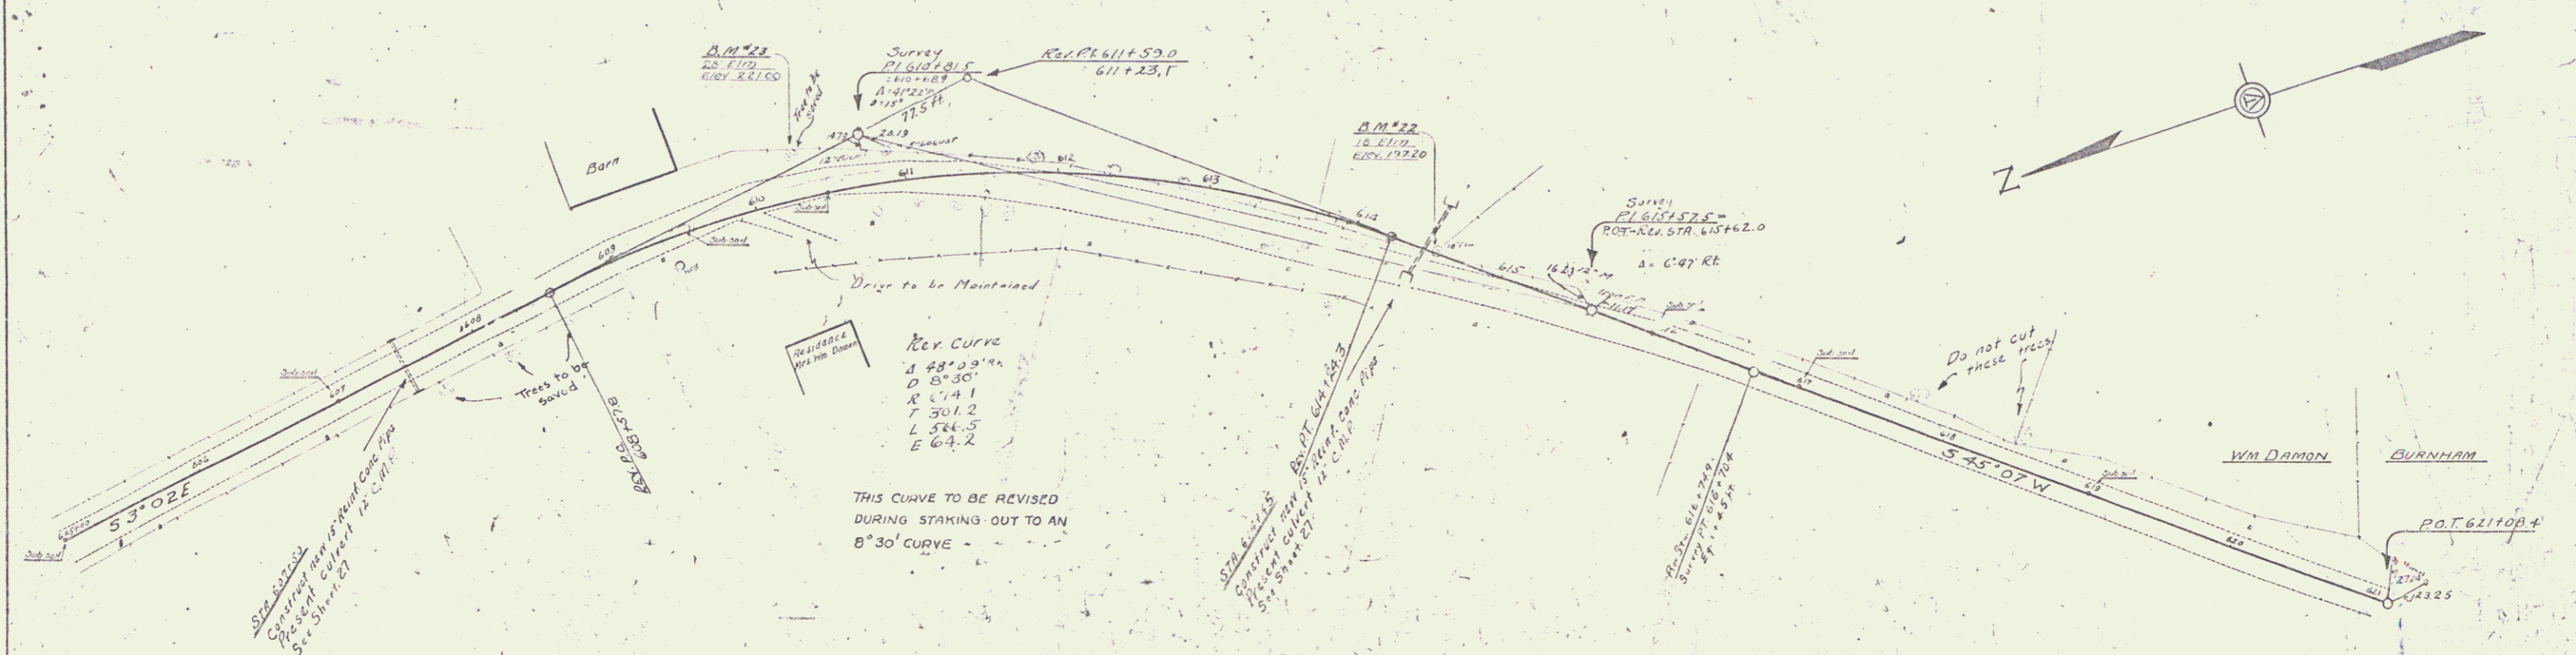

REVISIONS

PA	WAS	CUT	TO	ENTRANCE
PC	WAS	609.103.0		
PT	WAS	613.874.5		
D	WAS	10'		
R	WAS	871.0		
T	WAS	256.0		
L	WAS	487.5		
E	WAS	54.6		

REVISIONS MUST BE MADE ACCORDING TO STAKING OUT NOTES.