


PLAN
 DESIGNED BY
 CHECKED BY
 DATE
 1939

PROFILE
 DESIGNED BY
 CHECKED BY
 DATE

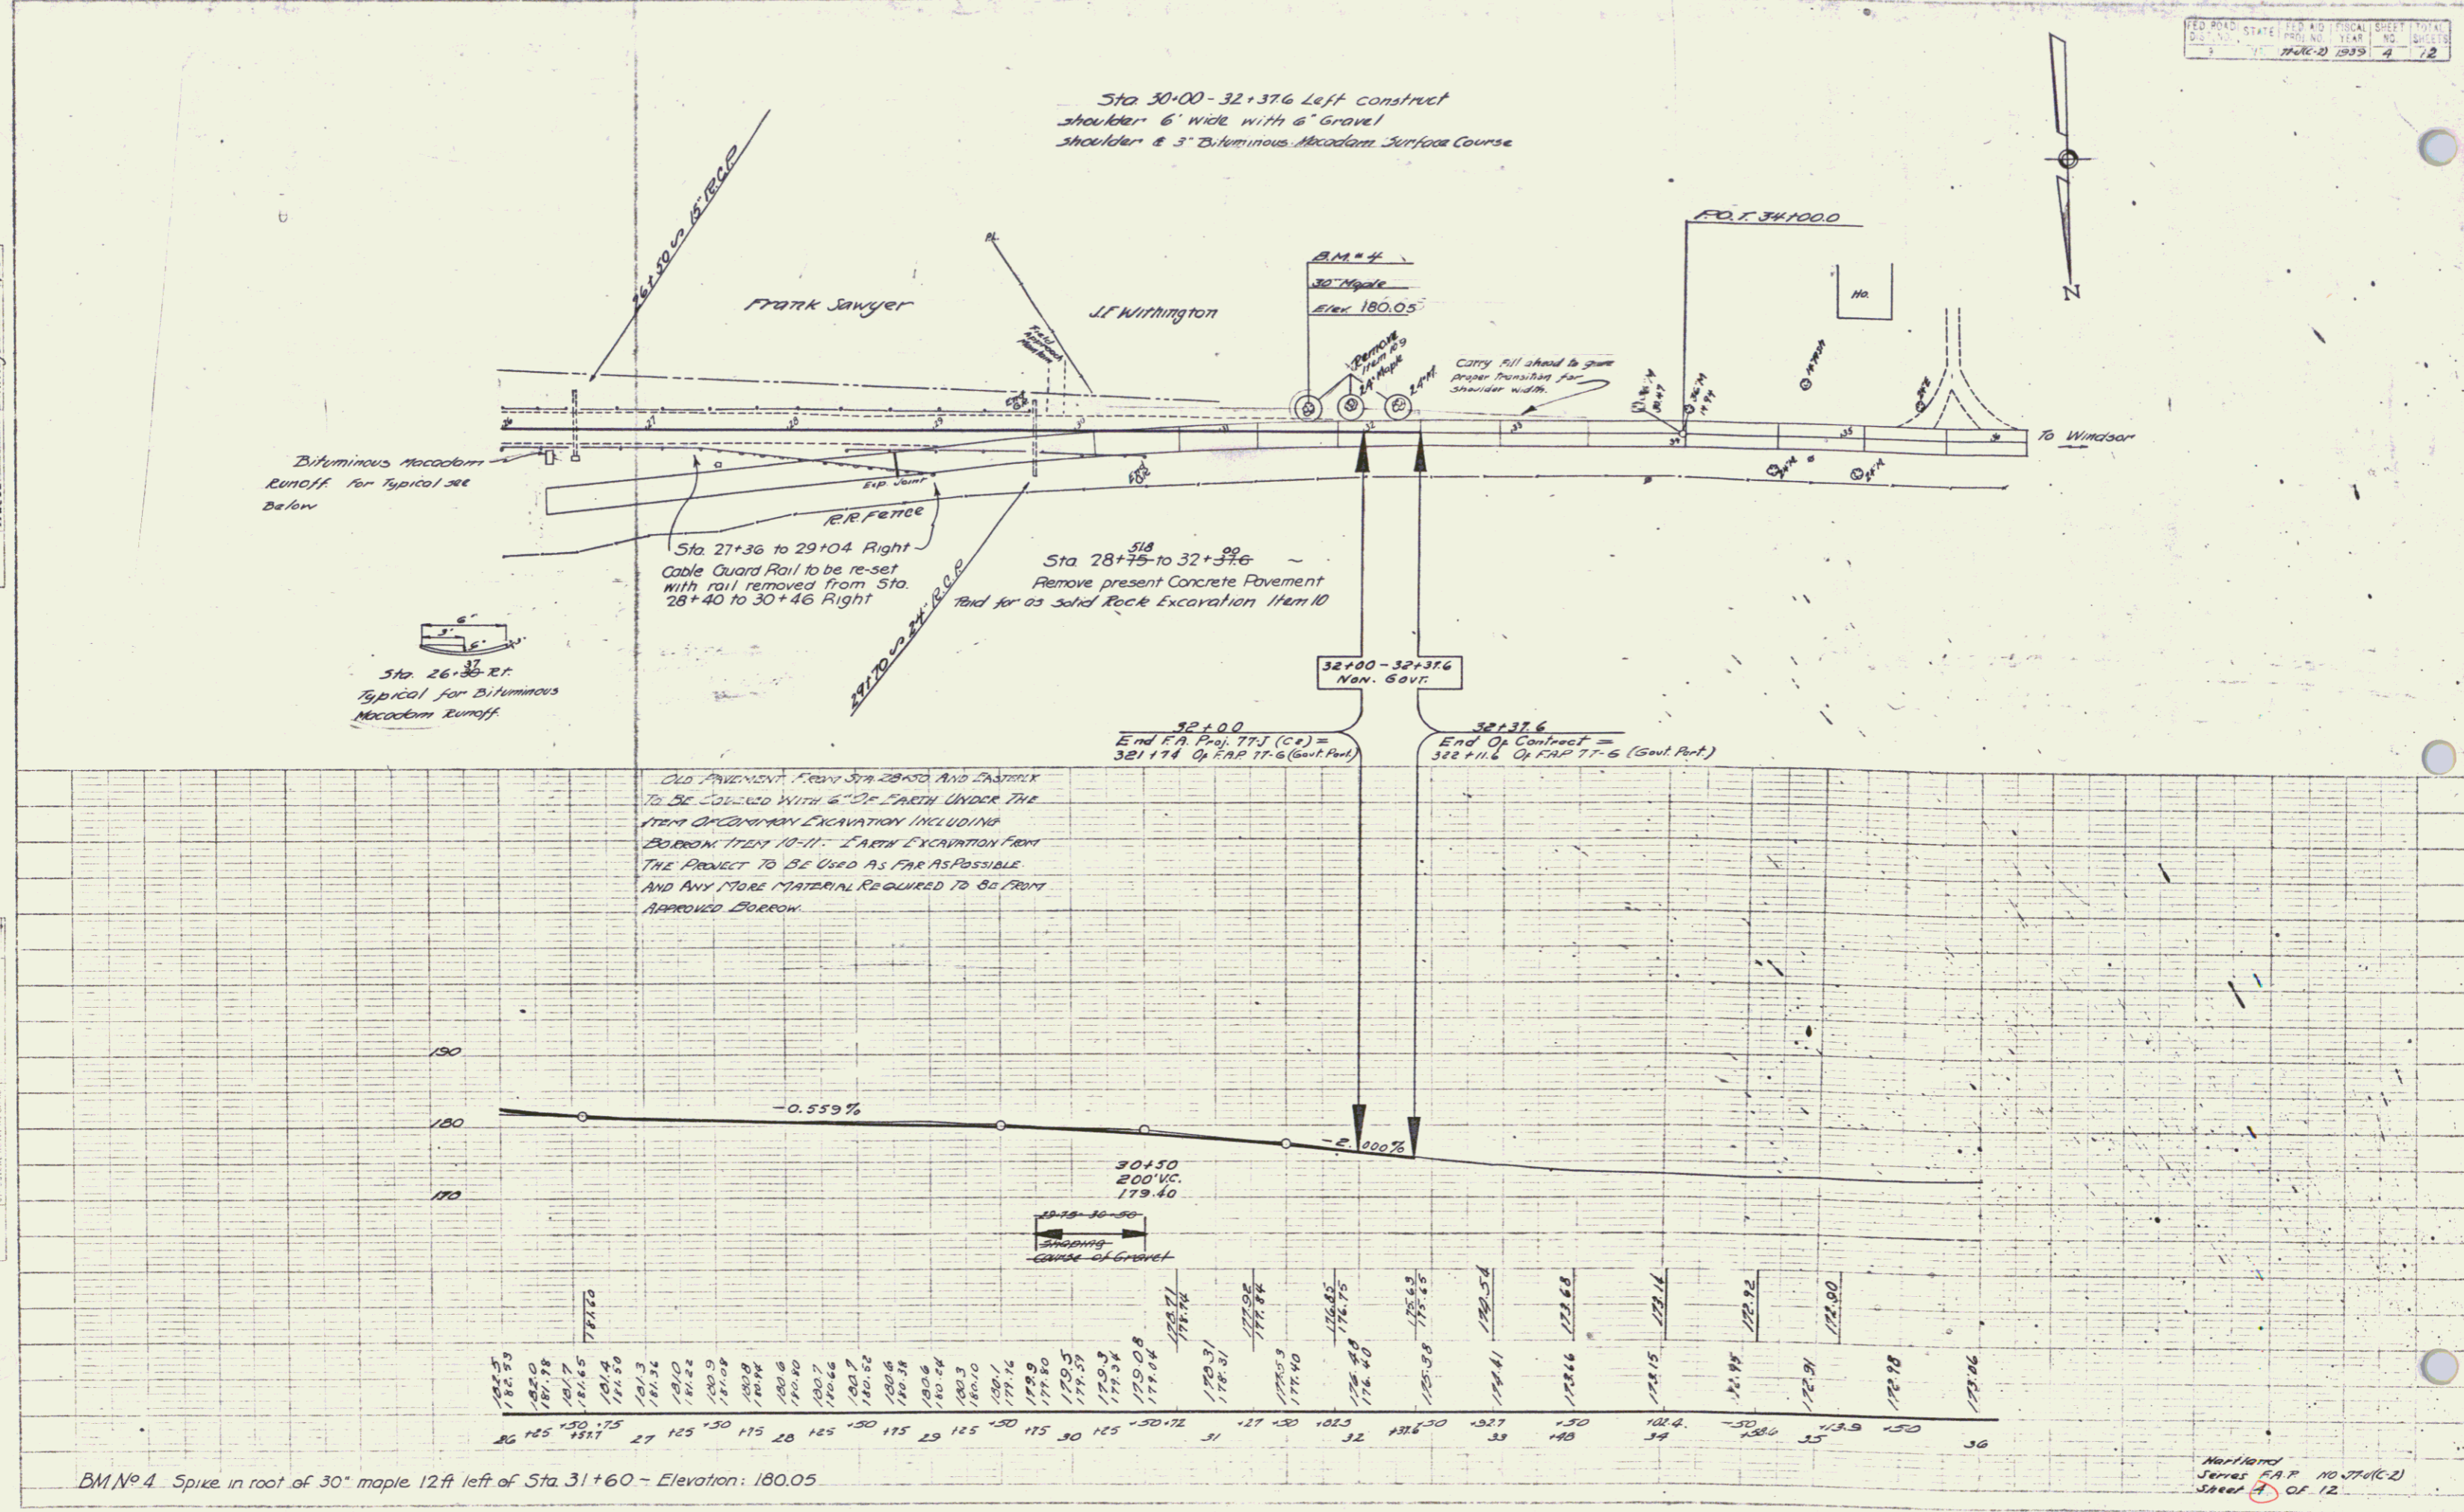

BM No. 4 Spike in root of 30' maple 12ft left of Sta. 31+60 - Elevation: 180.05