
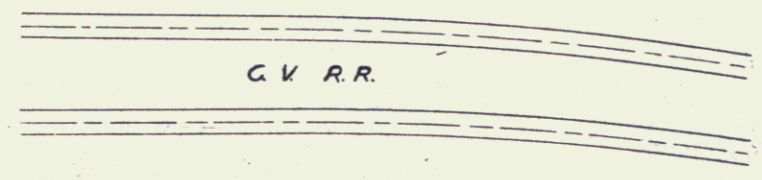


F. Withington

28+00 to 32+00
Road approach to be constructed
to meet present pavement.

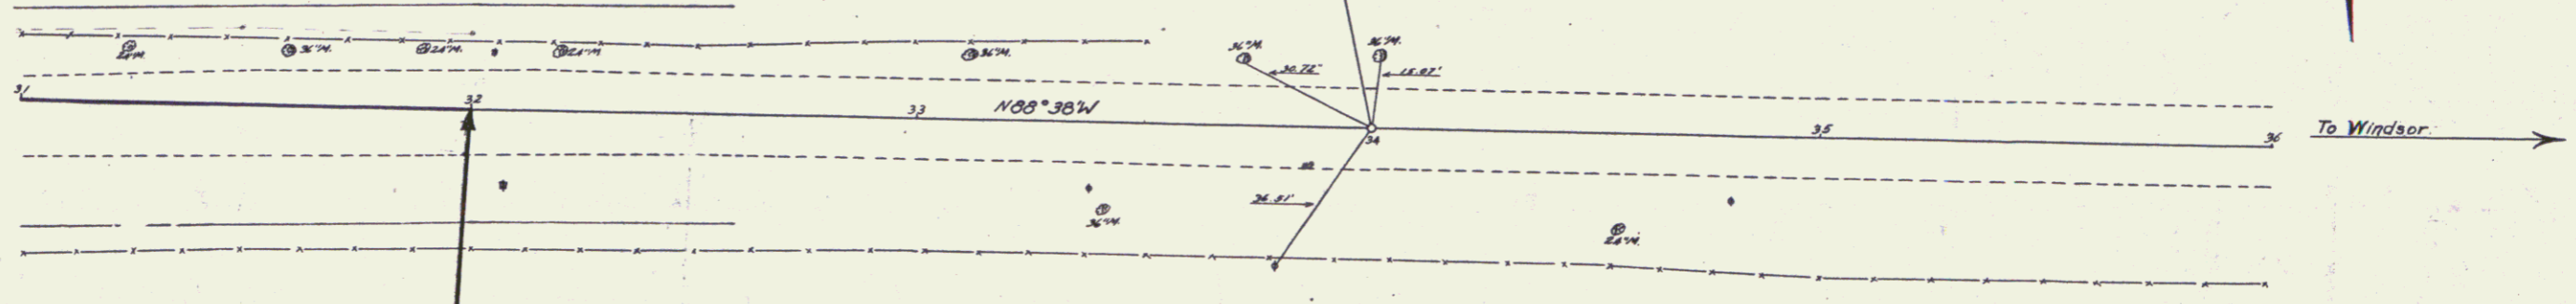

STATION 32+00
END OF PROJECT

STA. 32+00
END OF ROADWAY

190
180
170

-2.000%

31+00 - 32+00
15' Sub-base of Gravel

1728.9
1728.3
1727.5
1726.4
1726.4
1725.9
1725.3
1724.6
1724.0
1723.6
1723.1
1722.9
1722.0
1721.0
1720.0

6