


Name
 A. Ballucci
 Title
 P.E.

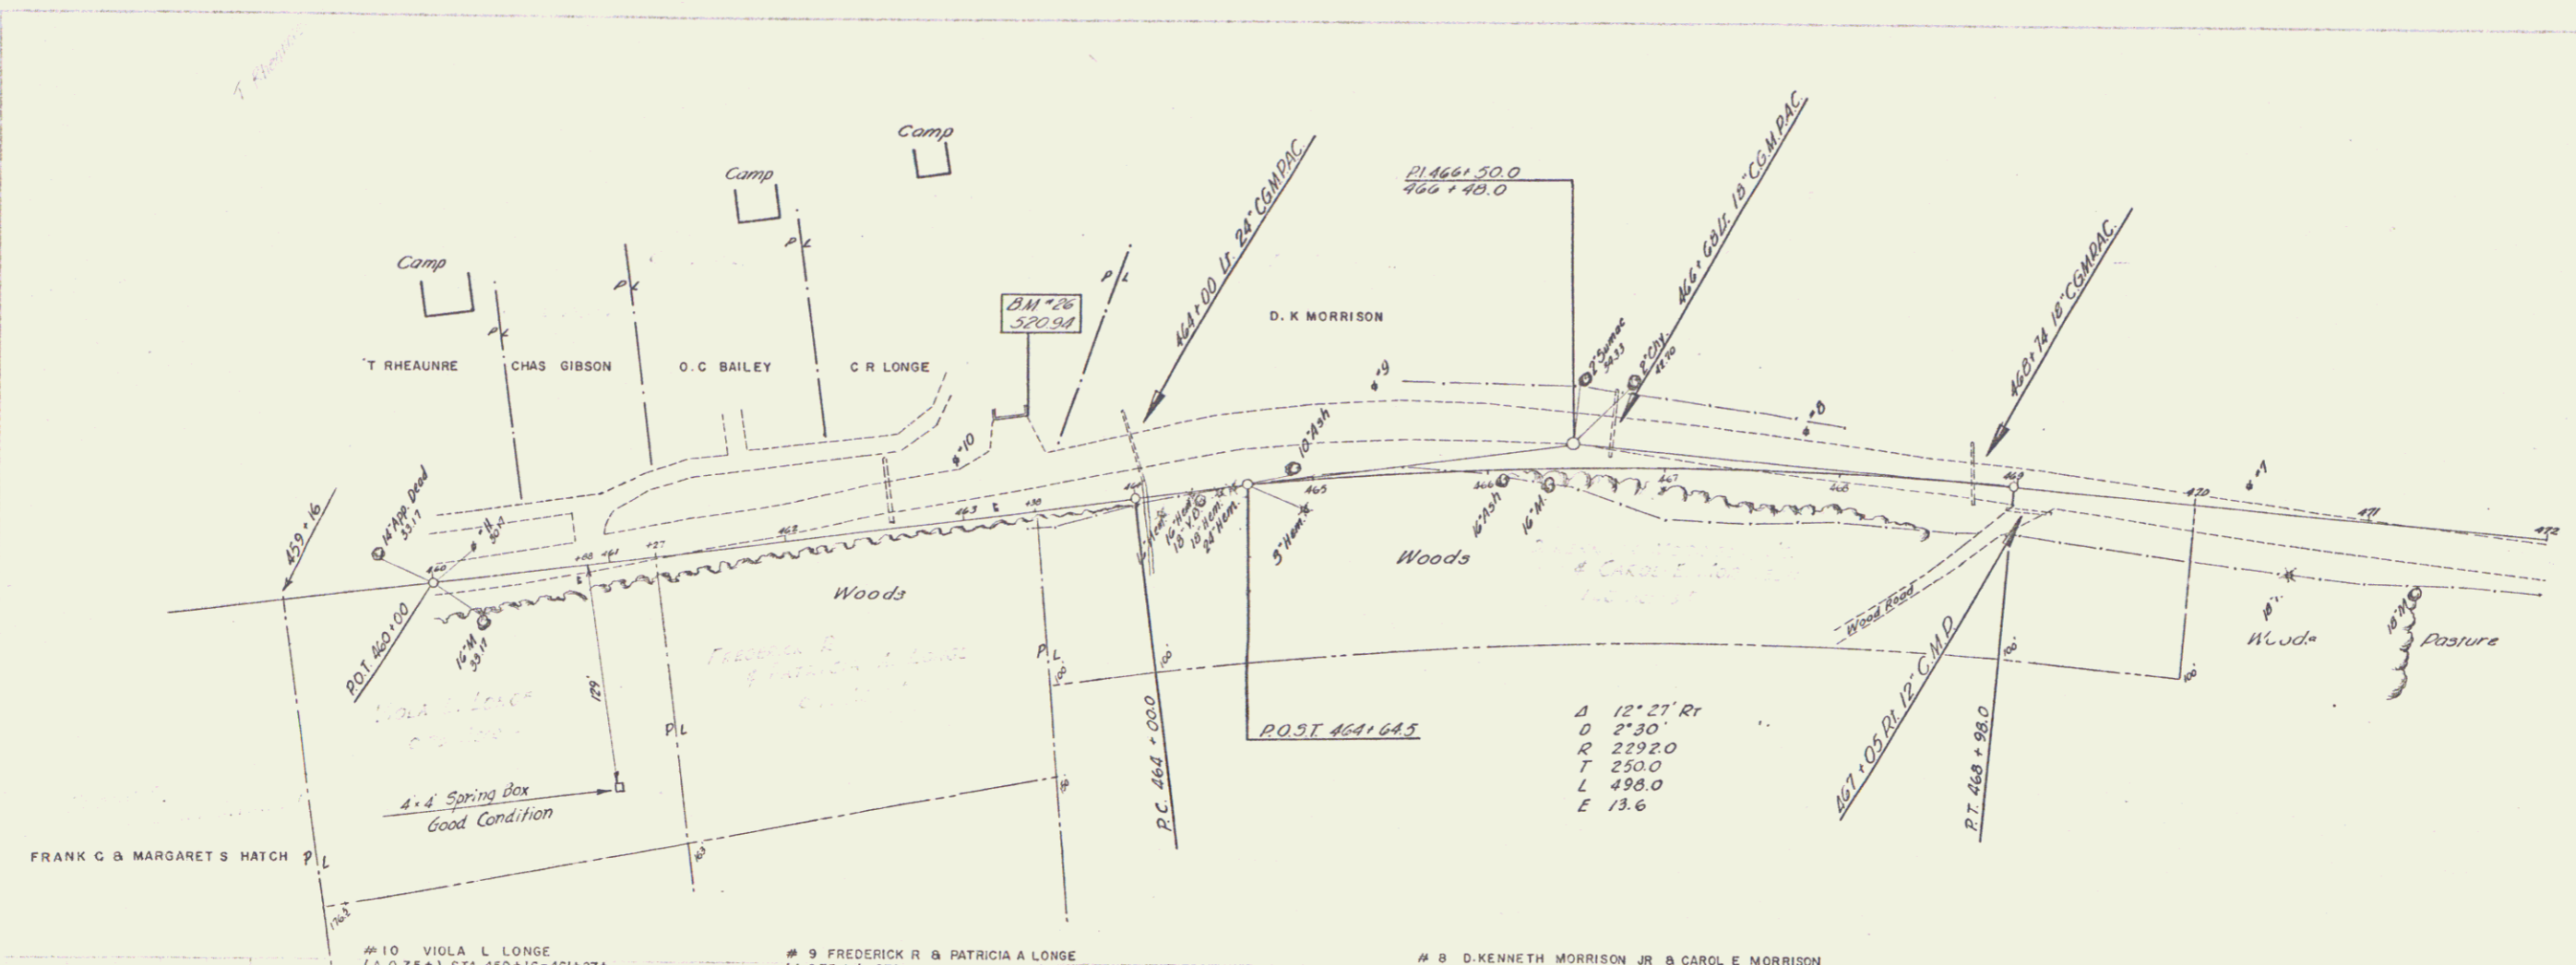


#10 VIOLA L LONGE
 (A 0.75 ±) STA 459+16-481+27 ±
 WD 3/15/57
 RECORDED - SPRINGFIELD - BK 56 - PG 272 / 273-3/19/57

#9 FREDERICK R & PATRICIA A LONGE
 (A 0.75 ±) STA 461+27-463+38 ±
 WD 3/15/57
 RECORDED - SPRINGFIELD - BK 56 - PG 271/272-3/19/57

#8 D. KENNETH MORRISON JR & CAROL E MORRISON
 (A 1.40 ±) STA 463+38-470+00
 WD 3/15/57
 RECORDED - SPRINGFIELD - BK 56 - PG 273-3/19/57

For End Right of Way to 460+00 Sta
 (cut in place of 460+00)

End Approach Proj. P.O.B. to
 Sta 470+00

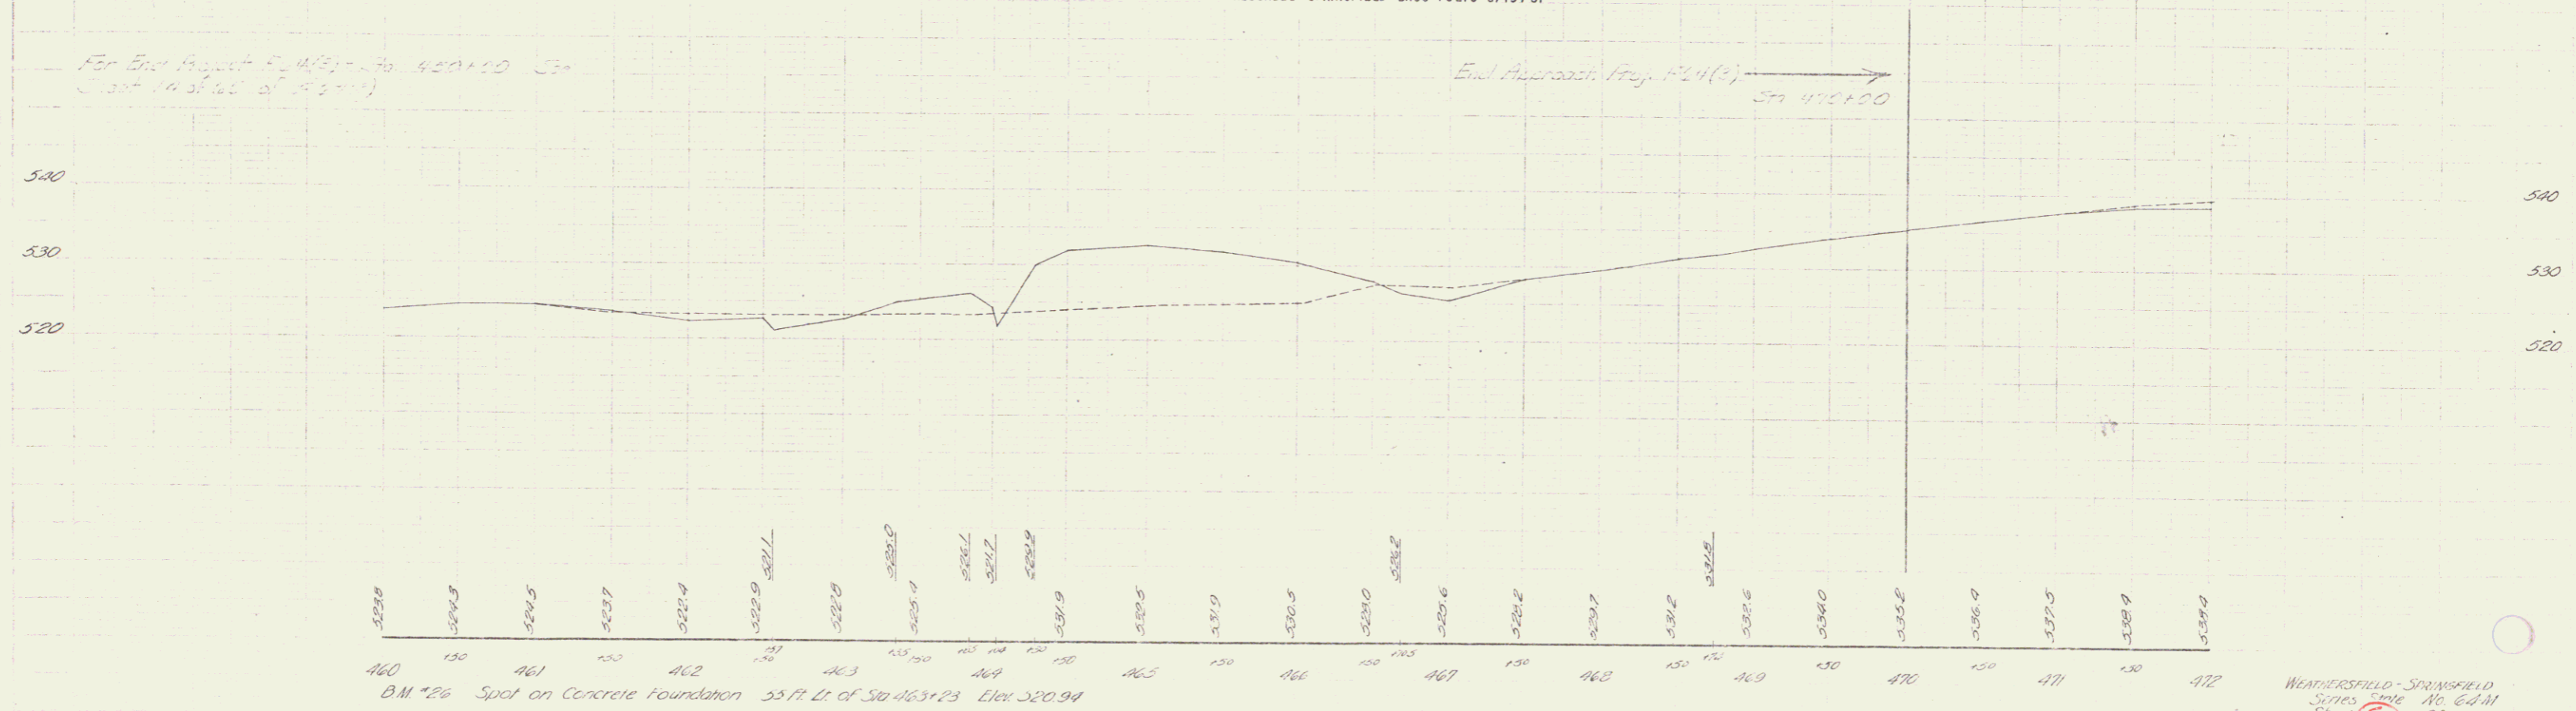

WEATHERSFIELD - SPRINGFIELD
 SERIES DATE NO. 64-M
 SHEET (5) OF