


PARCEL	KIND OF INSTRUMENT	DATE OF INSTRUMENT	GRANTOR	GRANTEE	RECORDED	REMARKS
A	M.D.	11-9-36	HENRY H. LUNKE, BURROWS	HEATHLET FIELD	BOOK 2908 PAGE 247E	11-7-30

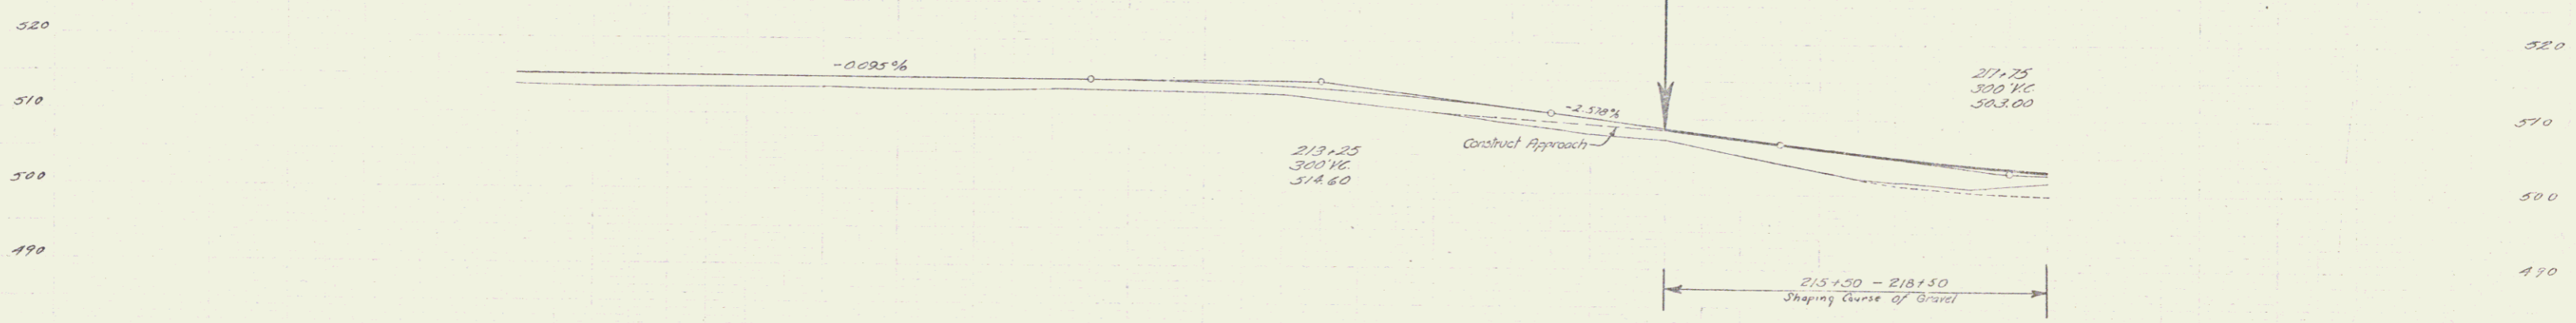

205	150	206	150	207	150	208	150	209	150	210	150	211	150	212	150	213	150	214	150	215	150	216	150	217	150	218	150	219	150	220	150
-----	-----	-----	-----	-----	-----	-----	-----	-----	-----	-----	-----	-----	-----	-----	-----	-----	-----	-----	-----	-----	-----	-----	-----	-----	-----	-----	-----	-----	-----	-----	-----

24.11-14 SPIRE IN ROOT OF 24" OAK 29'-RT OF STA 217+20 EL 50.332