

Note: Sta. 254+00  
A 2" iron pipe to act as a sleeve for the waterpipe is to be placed by the contractor. The exact location to be determined by the engineer.  
This work to be paid for as an extra work item.


Note: Sections taken up to Sta. 257+00 on ReSurf. Line. From 257+00 on offsets taken from Orig. Surf. Line.

STA. 249+35 - 258+35 RT  
249+90 - 255+50 LT  
Seeding Slopes & Topsoil  
(Items 10, 101, 104 & 106)

PARCEL	KIND OF INSTRUMENT	DATE OF INSTRUMENT	GRANTOR	GRANTEE	RECORDED WEATHERFIELD BOOK PAGE DATE	REMARKS
A	W.D.	1-12-37	H.F. & C.E. LAWRENCE	E. SPRINGFIELD	11-60-29	1-16-37 257+00 CUL. #2
A'	W.D.	1-13-37	C.W. & R. RANDALL	J.C.H. MARTIN	11-61-29	1-16-37 260+00 CUL. #1

Note: Sta. 258+501 - 261+001  
Approx. 0.17 Acres of Clearing and Grubbing Item 73

Note: Approx 300 cu yd Rock Excav. between Sta. 253+021 - 261+002 is to be used in making the fill between the same stations.

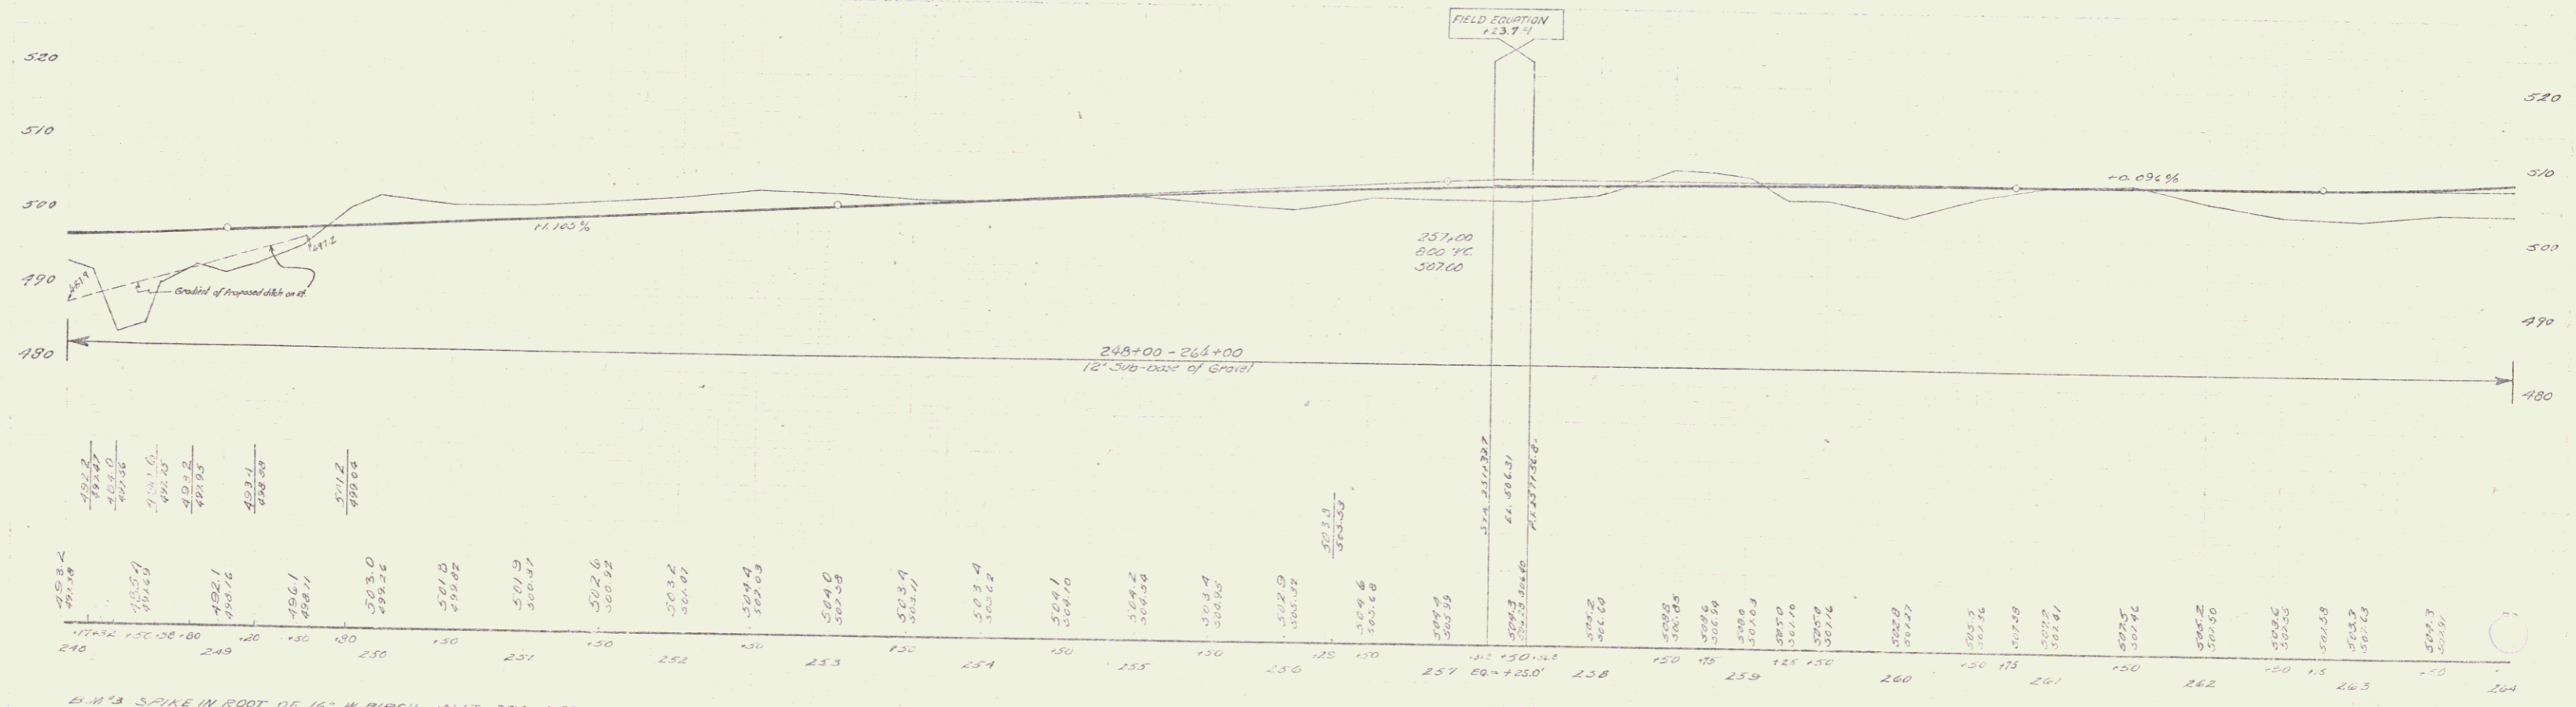

16" x 3 SPIKE IN ROOT OF 16" W BIRCH 13' LT STA 254+10 EL 503+44