
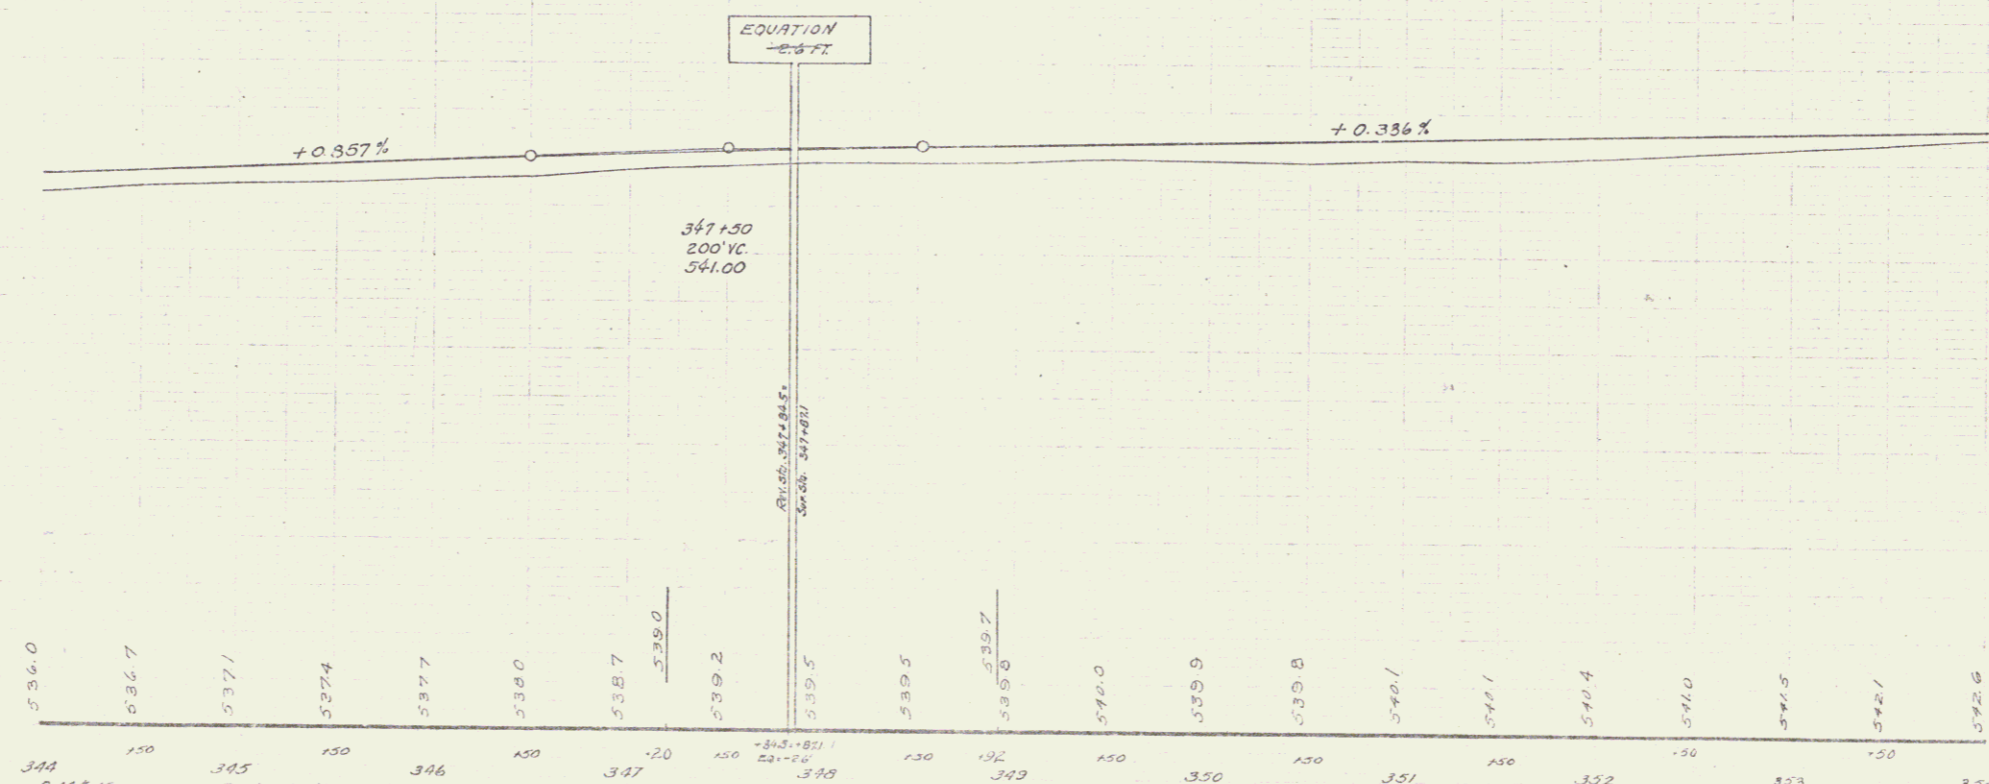


Bert Chamberlain
 and
 Lizzie O'Connor

7/24
 8/12

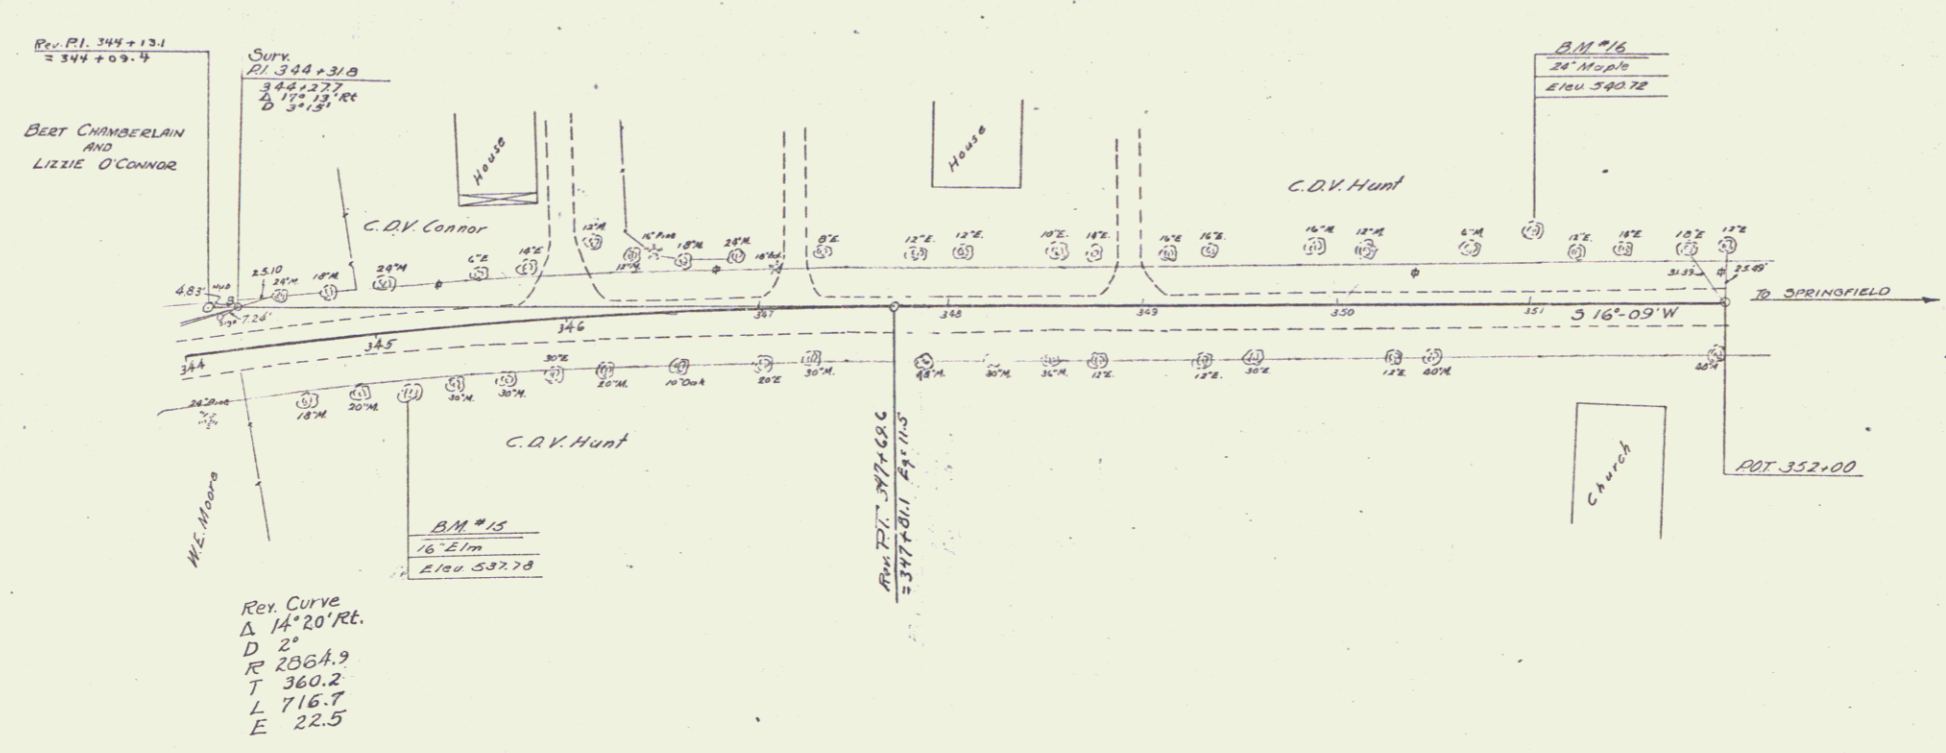

EQUATION
 $Y = 0.000005X^2 + 0.356X + 536.0$